


PLAN
SCALE: 1:50

SCALE IN MILLIMETERS

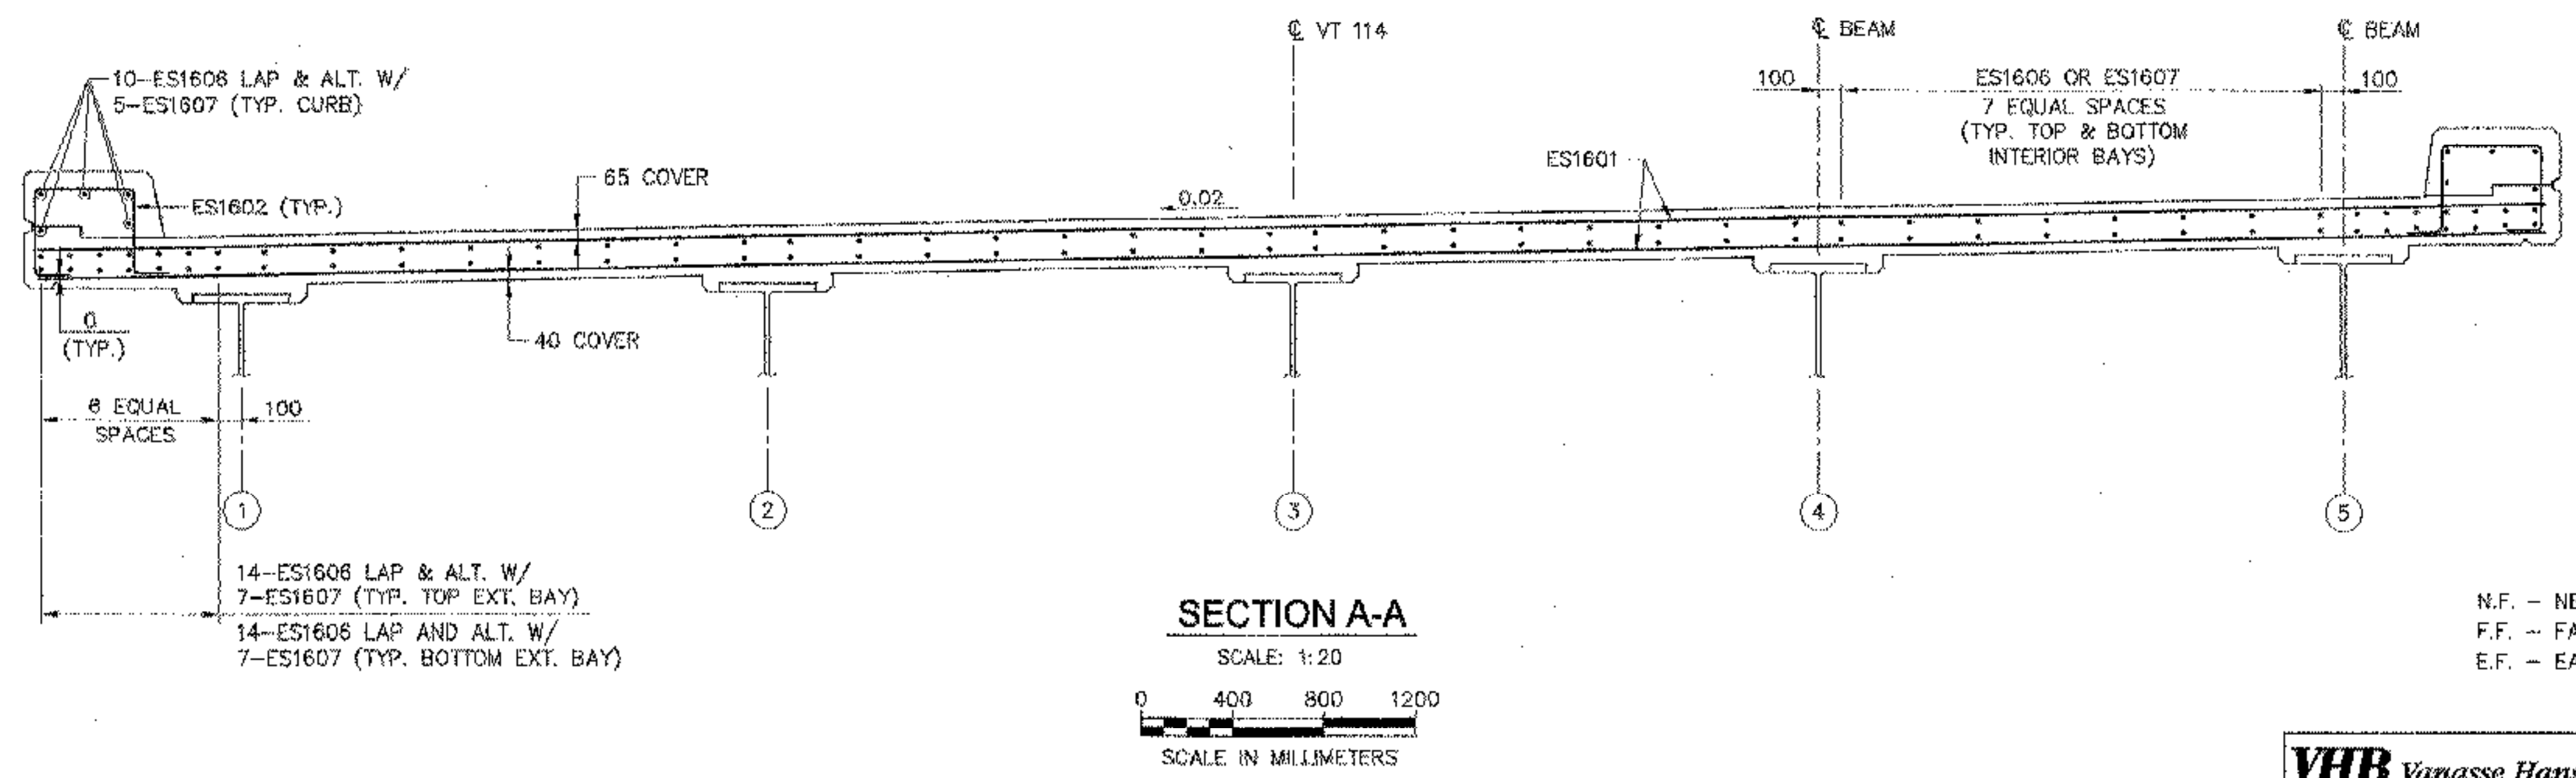

- NOTES:**
- SEE SHEET 37 FOR REINFORCING STEEL DETAIL AT BRIDGE RAIL POSTS. SEE SHEET 24 FOR BRIDGE RAIL POST SPACING.
 - SEE SHEET 30 FOR ADDITIONAL REINFORCING AT INTEGRAL ABUTMENT BACKWALLS.

STATE OF VERMONT AGENCY OF TRANSPORTATION			
Town Of	LYNDON	Bridge No.	2
Highway No.	VT 114	Log Sta.	
		Surv. Sta.	
VT 114 OVER PASSUMPSIC RIVER			
DECK REINFORCING			
Designed By	L.S. GARDNER	Drawn By	B.J. MASSE
Checked By	J.T. KLEIN	Date	3/06
		Bridge Design Supervisor	M.A. COLGAN Date 3/06
PROJECT	LYNDON	PROJECT NO.	BRF 0269(10)
I.G.C. Info.	Bridge Sheet No. 505440R	Sheet	27 of 72