


ELEVATION CHANGES DUE TO REVISION IN VERTICAL CURVES BY RRW 12/06

- NOTES:
- SEE SHEET 35 FOR WINGWALL DETAILS.
 - SEE SHEET 30 FOR ABUTMENT TYPICAL SECTION.

STATE OF VERMONT AGENCY OF TRANSPORTATION	
Town Of LYNDON	Bridge No. 2
Highway No. VT 114	Log Sta.
VT 114 OVER PASSUMPSIC RIVER	
ABUTMENT NO. 1	
Designed By R.J. XU	Drawn By B.J. MASSE
Checked By J.T. KLEIN	Bridge Design Supervisor M.A. COLGAN Date 3/06
PROJECT LYNDON	PROJECT NO. BRF 0269(10)
I.G.C. Info.	Bridge Sheet No. 50544AB1
Sheet 33 of 72 (REVISED)	

* SEE SHEET 35 FOR ADDITIONAL ELEVATIONS.

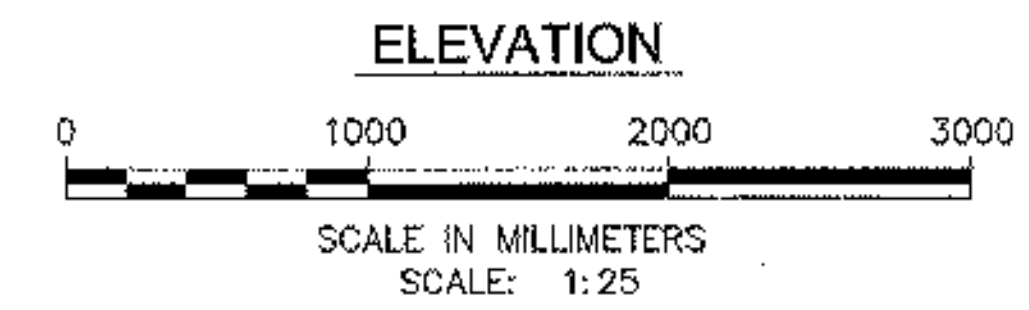

KEY:

N.S. - NEAR SIDE

F.S. - FAR SIDE

E.F. - EACH FACE