


SCALE IN MILLIMETERS  
SCALE: 1:20

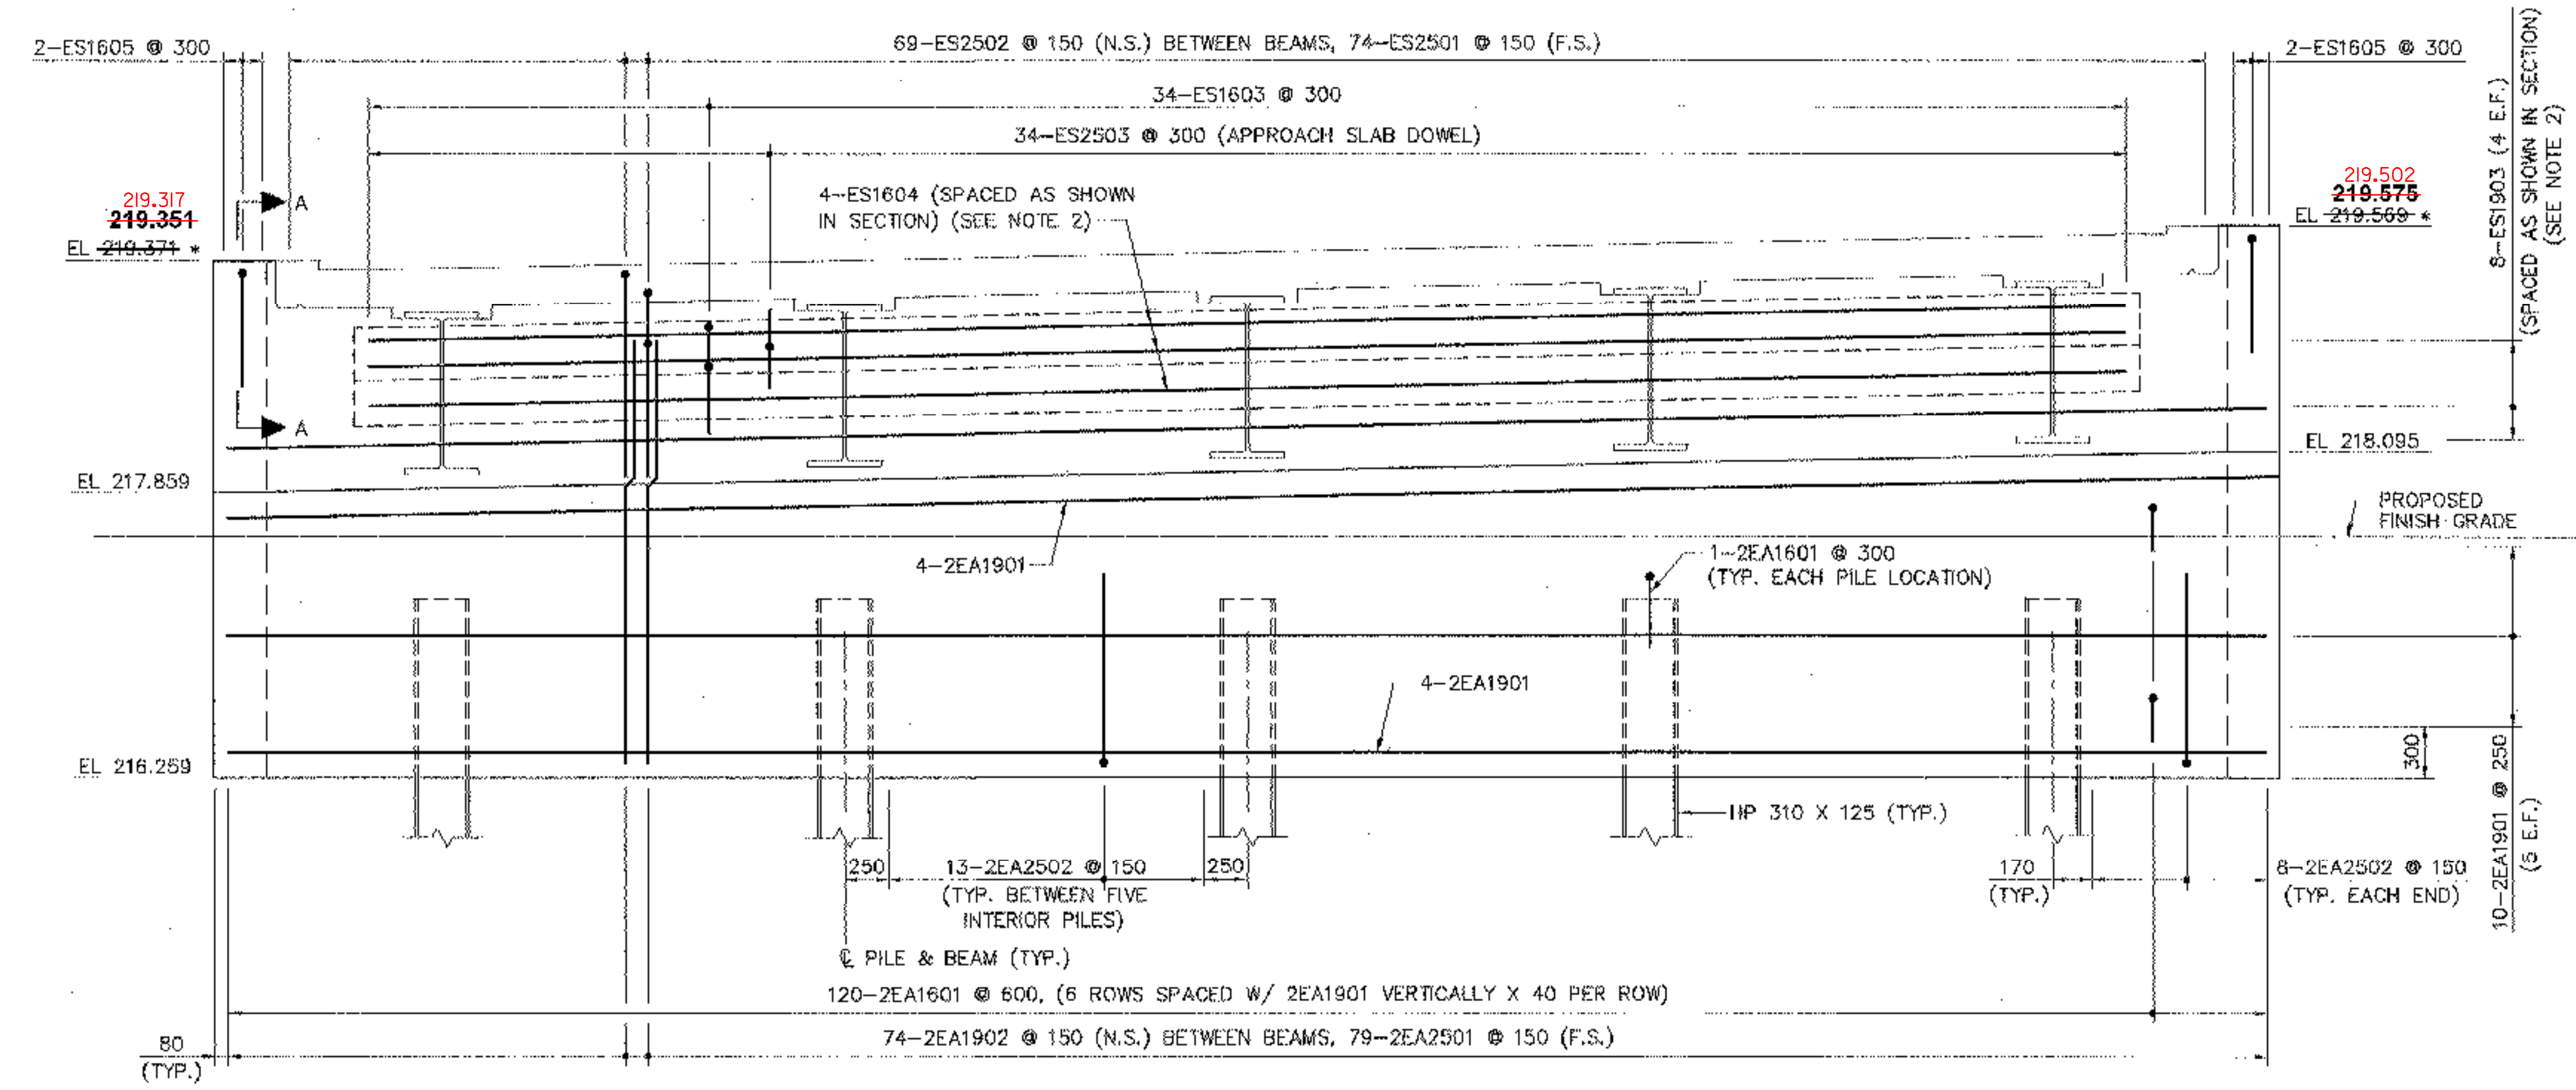

\* SEE SHEET 35 FOR ADDITIONAL ELEVATIONS.

SCALE IN MILLIMETERS  
SCALE: 1:25

KEY:  
N.S. - NEAR SIDE  
F.S. - FAR SIDE  
E.F. - EACH FACE

ELEVATION CHANGES DUE TO REVISION IN VERTICAL CURVES BY RRW 12/06

- NOTES:
- SEE SHEET 35 FOR WINGWALL DETAILS.
  - SEE SHEET 30 FOR ABUTMENT TYPICAL SECTION.

<b>STATE OF VERMONT AGENCY OF TRANSPORTATION</b>		
Town Of	LYNDON	Bridge No. 2
Highway No.	VT 114	Log Sta.
VT 114 OVER PASSUMPSIC RIVER		Surv. Sta.
<b>ABUTMENT NO. 2</b>		
Designed By	R.J. XU	Drawn By
Checked By	J.T. KLEIN	Bridge Design Supervisor
Date	3/06	M.A. COLGAN date 3/06
PROJECT	LYNDON	PROJECT NO.
		BRF 0289(10)
I.G.C. Info.		
Bridge Sheet No.	50544AB2	Sheet 34 of 72 (REVISED)