





WINGWALL NO. 1

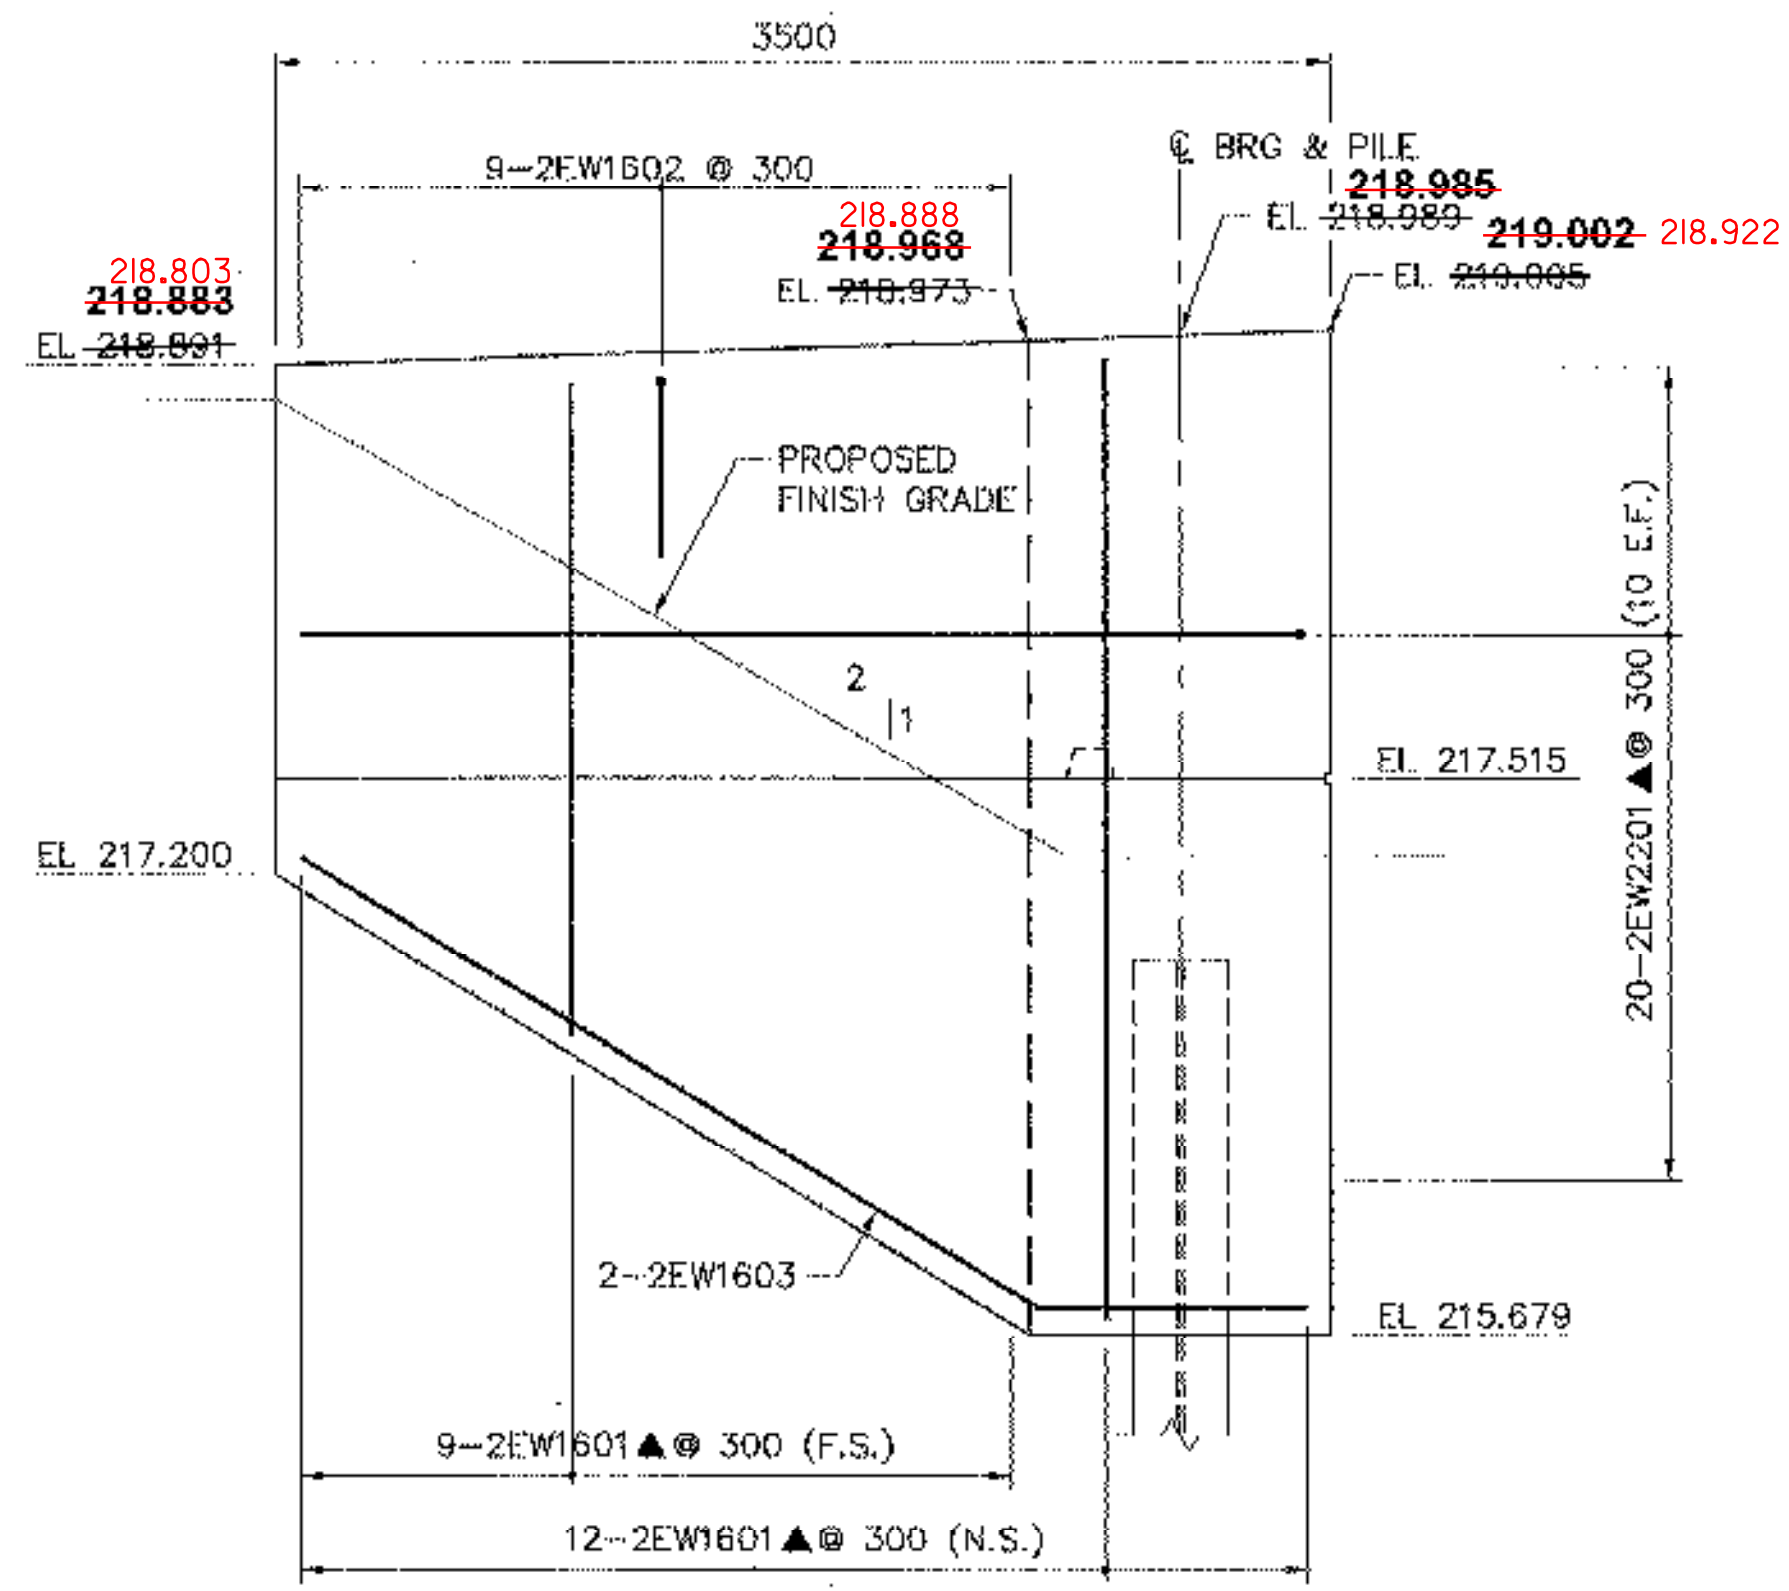


WINGWALL NO. 2

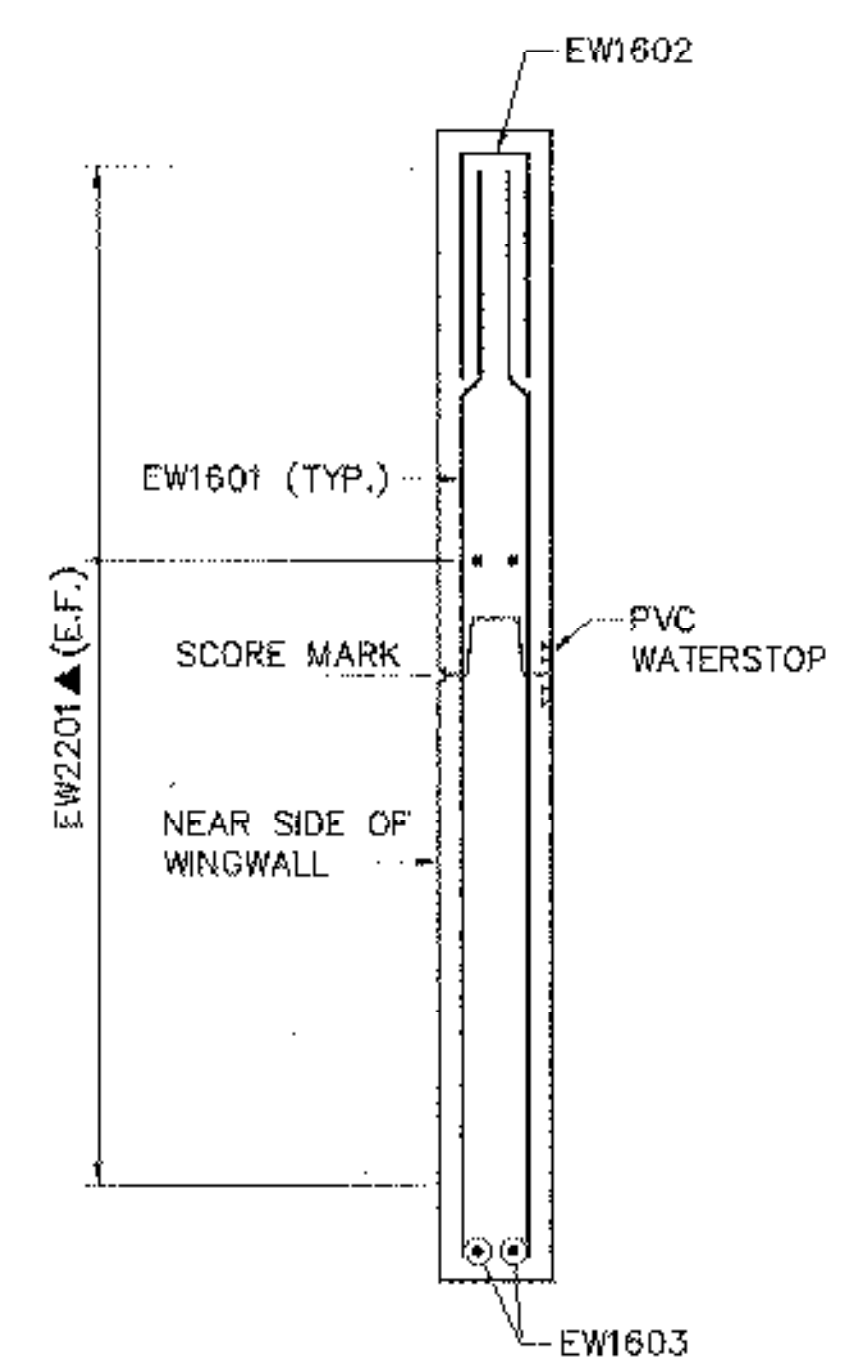


WINGWALL TYPICAL SECTION

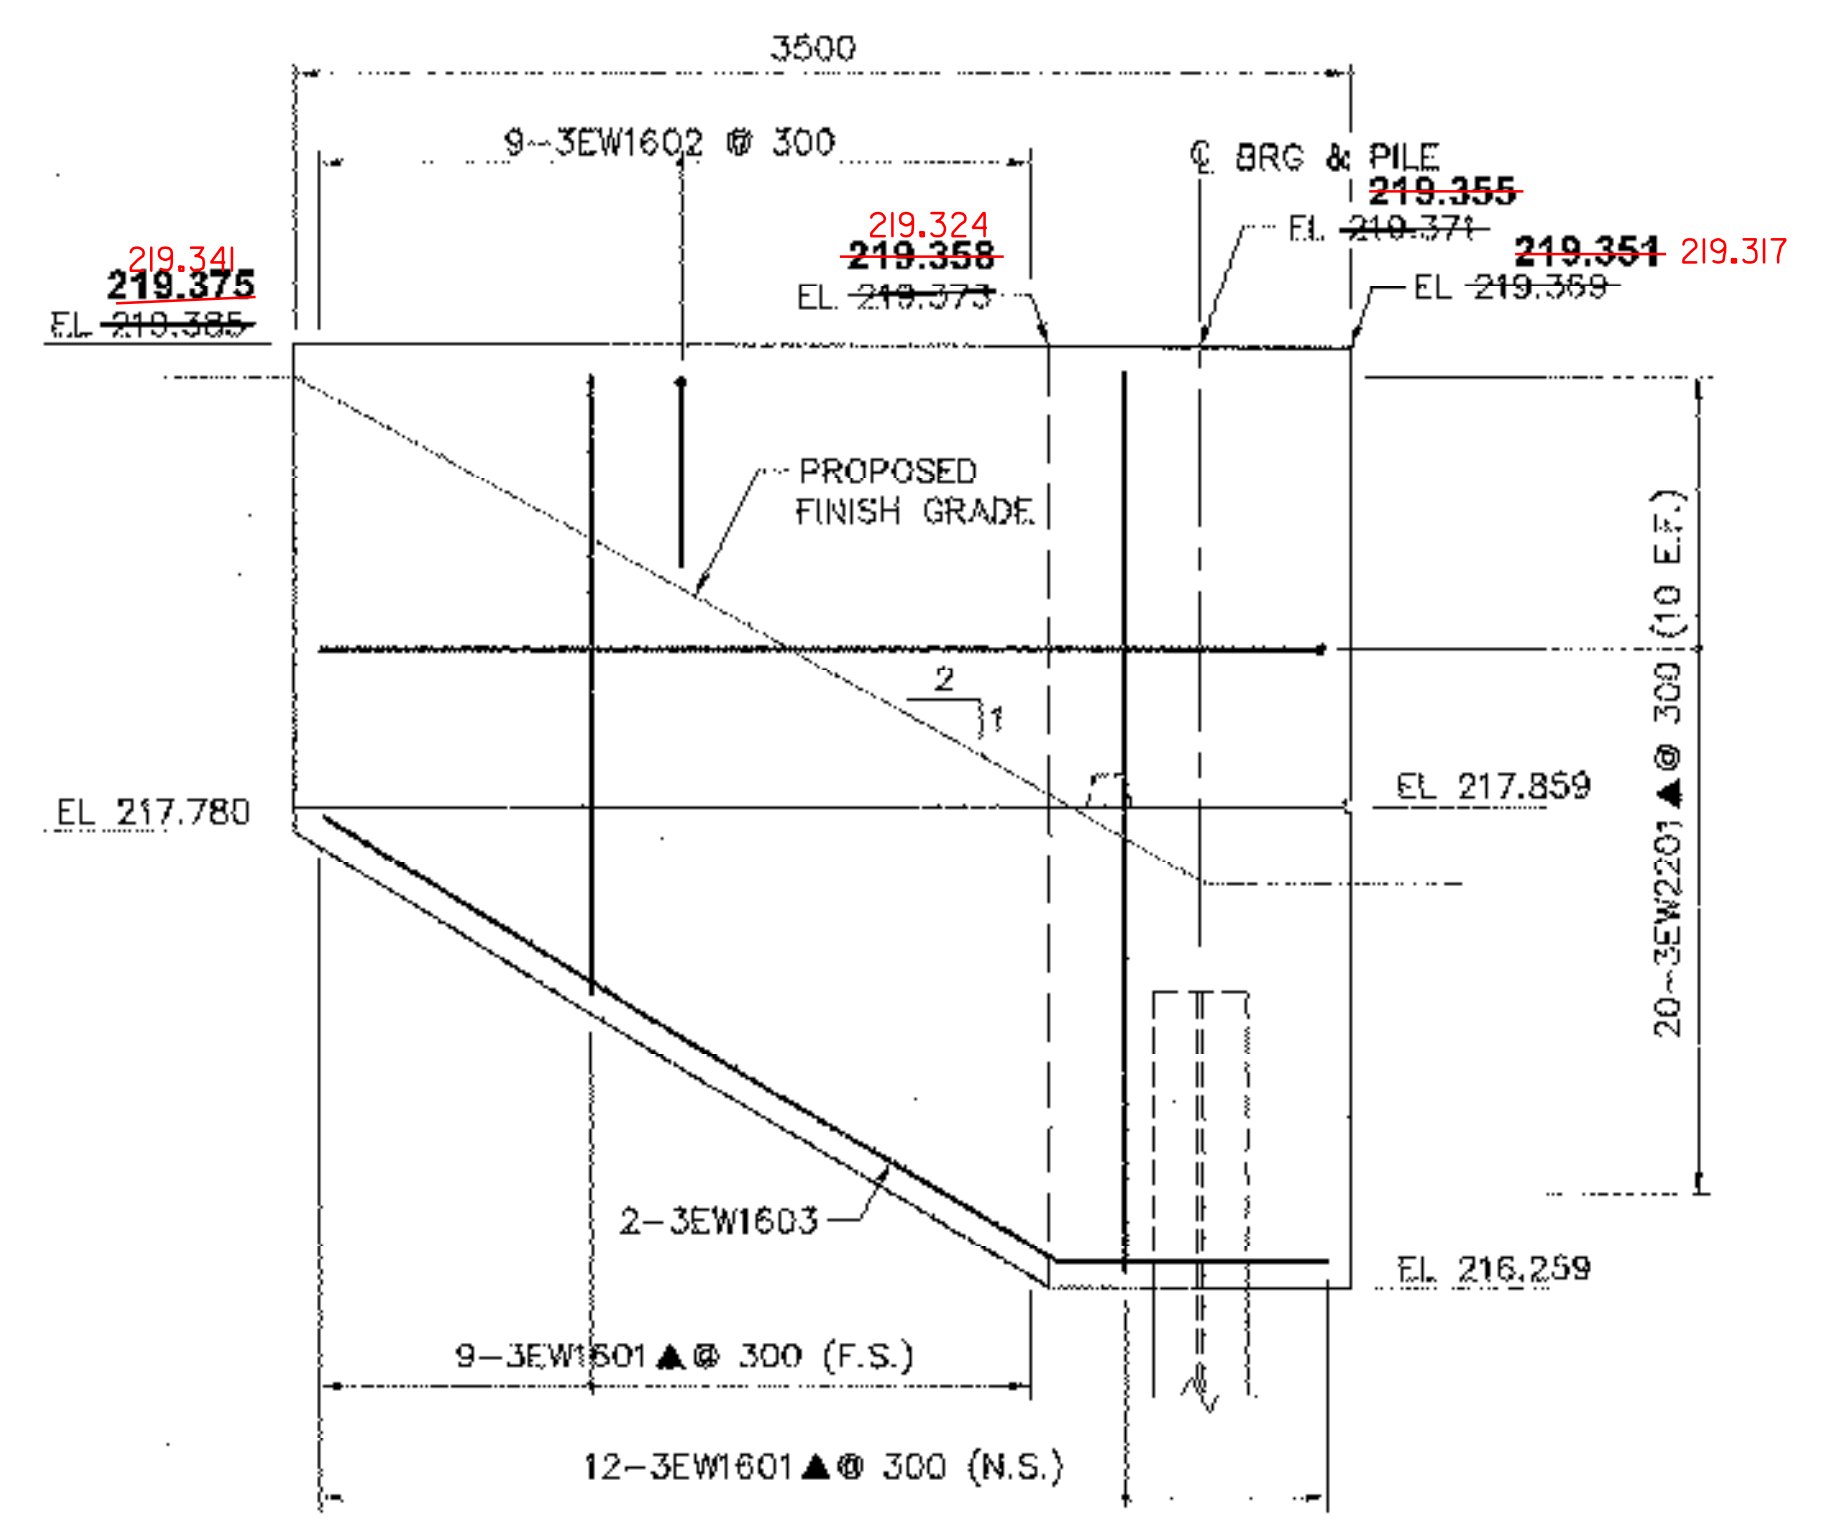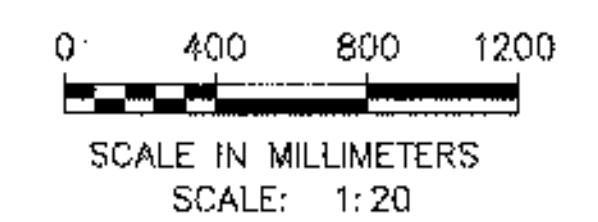


WINGWALL NO. 3

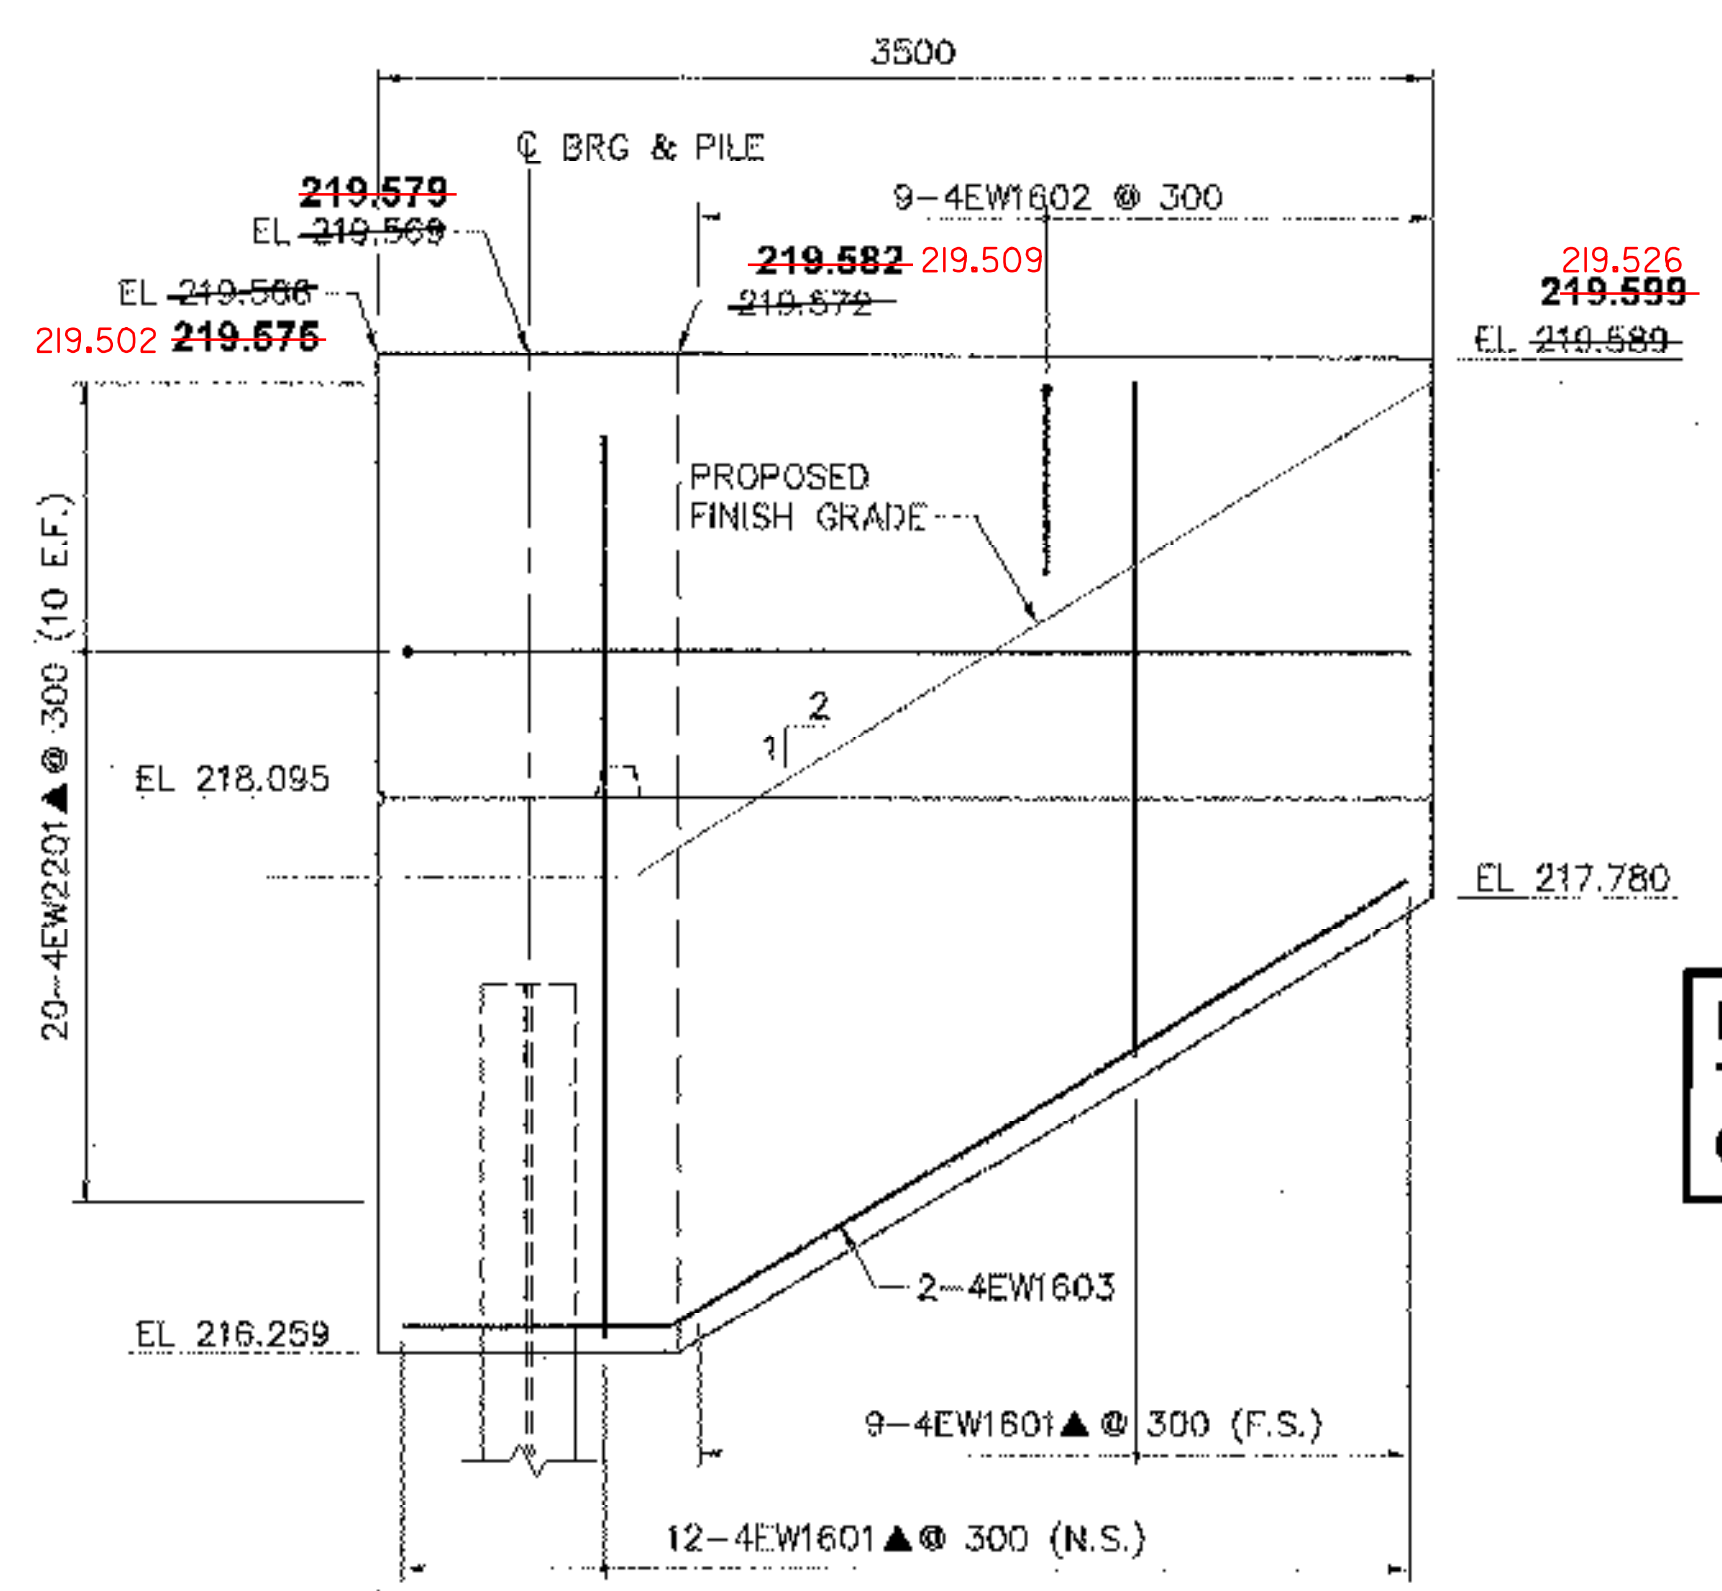

WINGWALL NO. 4

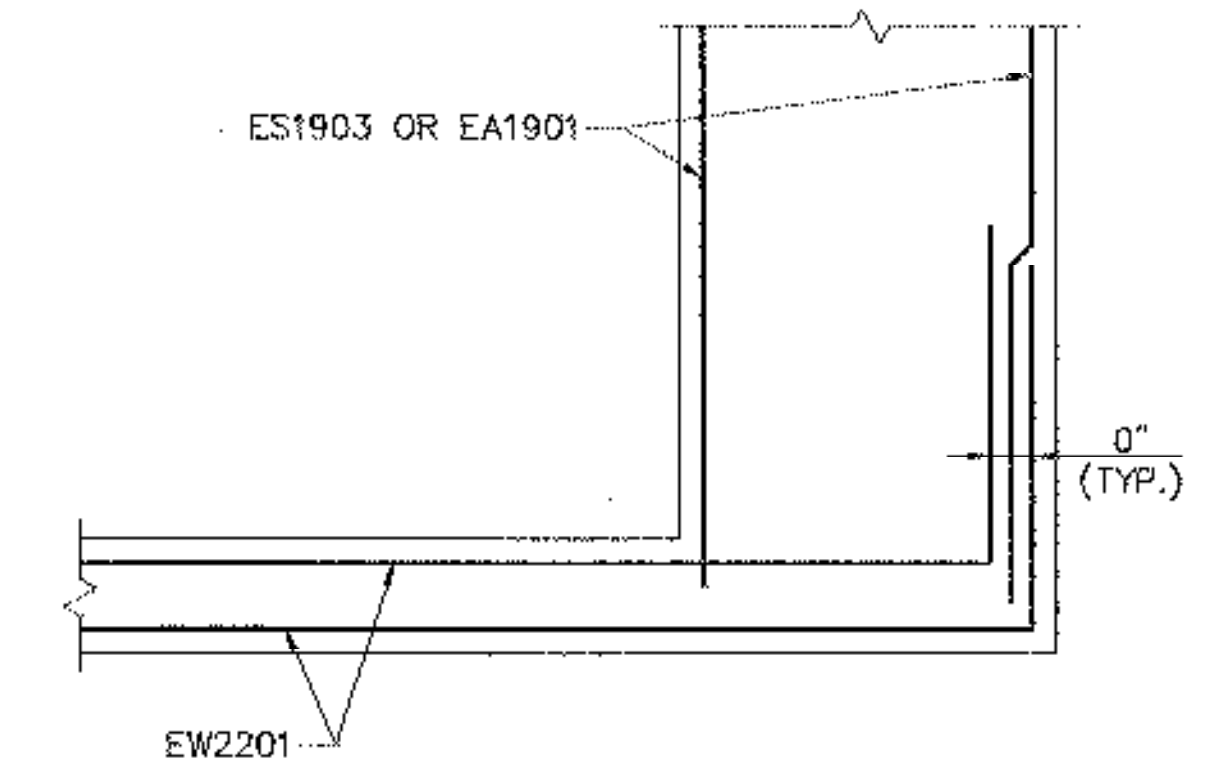


TYPICAL CORNER DETAIL

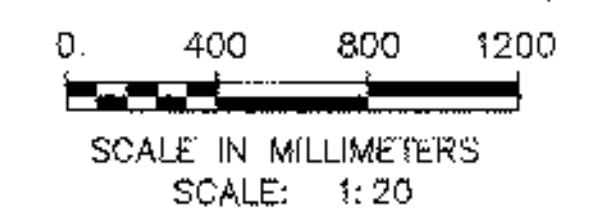

ELEVATION CHANGES DUE TO REVISION OF VERTICAL CURVES BY RRW 12/06

WINGWALL DETAILS

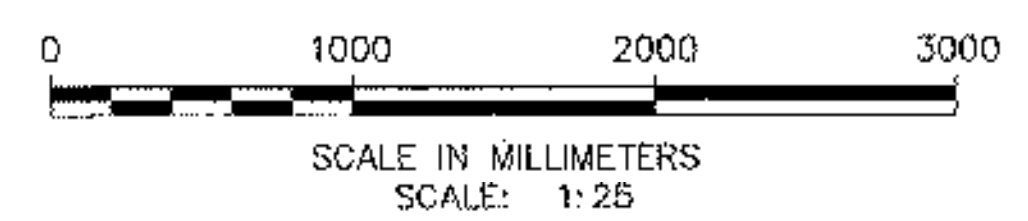

KEY:
 N.S. - NEAR SIDE
 F.S. - FAR SIDE
 E.F. - EACH FACE
 ▲ - CUT TO FIT IN FIELD

STATE OF VERMONT AGENCY OF TRANSPORTATION	
Town Of LYNDON	Bridge No. 2
Highway No. VT 114	Log Sta.
VT 114 OVER PASSUMPSIC RIVER	
WINGWALL DETAILS	
Designed By J.T. KLEIN	Drawn By B.J. MASSE
Checked By L.S. GARDNER	Bridge Design Supervisor M.A. COLGAN
Date 3/06	Date 3/06
PROJECT LYNDON	PROJECT NO. BRF 0269(10)
t.G.C. Info.	Bridge Sheet No. 50544WWF
Sheet 35 of 72 (REVISED)	