


EXISTING LEGEND

	EXISTING GUARDRAIL
	TREELINE
	OVERHEAD UTILITY
	UNDERGROUND TELEPHONE
	UNDERGROUND ELECTRIC
	CENTERLINE DITCH
	CULVERT
	UTILITY POLE W/GUY
	SIGN
	TELEPHONE MARKER
	TRAVERSE POINT

- NOTES:**
- NO "THREATENED & ENDANGERED SPECIES" OR HISTORIC RESOURCES HAVE BEEN IDENTIFIED FOR THIS PROJECT.
 - EXISTING PASSUMPSIC RIVER CHANNEL BANKS ARE ARMORED WITH HEAVY STONE FILL UPSTREAM, DOWNSTREAM, AND UNDER THE BRIDGE.

PLAN

SCALE: 1:250

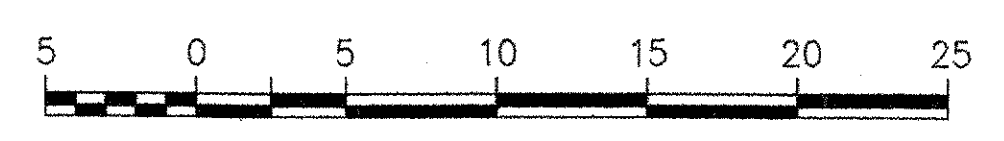

GRAPHIC SCALE
(IN METERS)

DATUM	
VERTICAL	NAVD 88
HORIZONTAL	NAD 83-92

**STATE OF VERMONT
AGENCY OF TRANSPORTATION**

Town Of	LYNDON	Bridge No. 2	
Highway No.	VT 114	Log Sta.	
		Surv. Sta.	
VT 114 OVER PASSUMPSIC RIVER			
EXISTING CONDITIONS SITE PLAN (1 OF 2)			
Designed By	M.A. COLGAN	Drawn By	B.J. MASSE
Checked By	Date	Bridge Design Supervisor	
M.A. COLGAN	3/06	M.A. COLGAN Date 3/06	
PROJECT	LYNDON	PROJECT NO.	BRF 0269(10)
I.G.C. Info.			
Bridge Sheet No.	50544ER1	Sheet	62 of 72