

N 7354.1830  
E 10089.5445  
312.34'  
118°19'30" LT

N 6957.9889  
E 10471.5740  
390.36'  
39°55'06" LT

N 7423.1927  
E 10456.5495  
118.92'  
183°34'45" LT

N 7336.8835  
E 10377.6793

N 7007.8821  
E 10227.8415  
361.87'  
163°32'34" LT


N 6877.5725  
E 10202.4313

LEGEND

- CONCRETE
- PRECAST CONCRETE BRICK PAVERS
- ASPHALT
- FULLY PAINTED AREA
- EXISTING 1' CONTOUR LINE
- EXISTING 5' CONTOUR LINE
- NEW 1' CONTOUR LINE
- SEWAGE
- EXISTING TREE TO REMAIN
- TREE TO BE REMOVED
- NEW OR RELOCATED TREE OR SHRUB
- EXISTING STREETLIGHT
- NEW LAMINAIRE
- FLAGPOLE

THE CONTRACTOR SHALL NOTIFY "DIGSAFE" AT 1-800-225-4877 PRIOR TO ANY EXCAVATION

NOTE TOPOGRAPHIC INFO TAKEN FROM A SURVEY DATED 3/10/86 BY VERMONT SURVEY AND ENGINEERING, INC. MONTPELIER. CONTRACTOR SHALL VERIFY ALL DIMENSIONS AND ELEVATIONS NECESSARY TO PERFORM THE WORK PRIOR TO BEGINNING THE WORK.

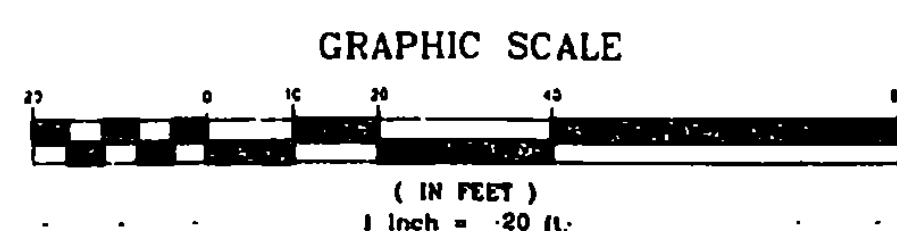

REVISED 7/25/96 PLD

STATE OF VERMONT  
DEPARTMENT OF STATE BUILDINGS  
AGENCY OF ADMINISTRATION  
MONTPELIER, VERMONT

ALBURG WELCOME CENTER  
ALBURG  
SITE-PLAN

DATE: MARCH 28, 1998	SCALE: 1"=20'	REVISION: 5-16-96 7-25-96	DRAWING NO.:
DRAWN BY: SLL	PROJECT NO.:		S-1
APPROVED BY: JBA	NH028-1075		SHEET 4 OF 21