
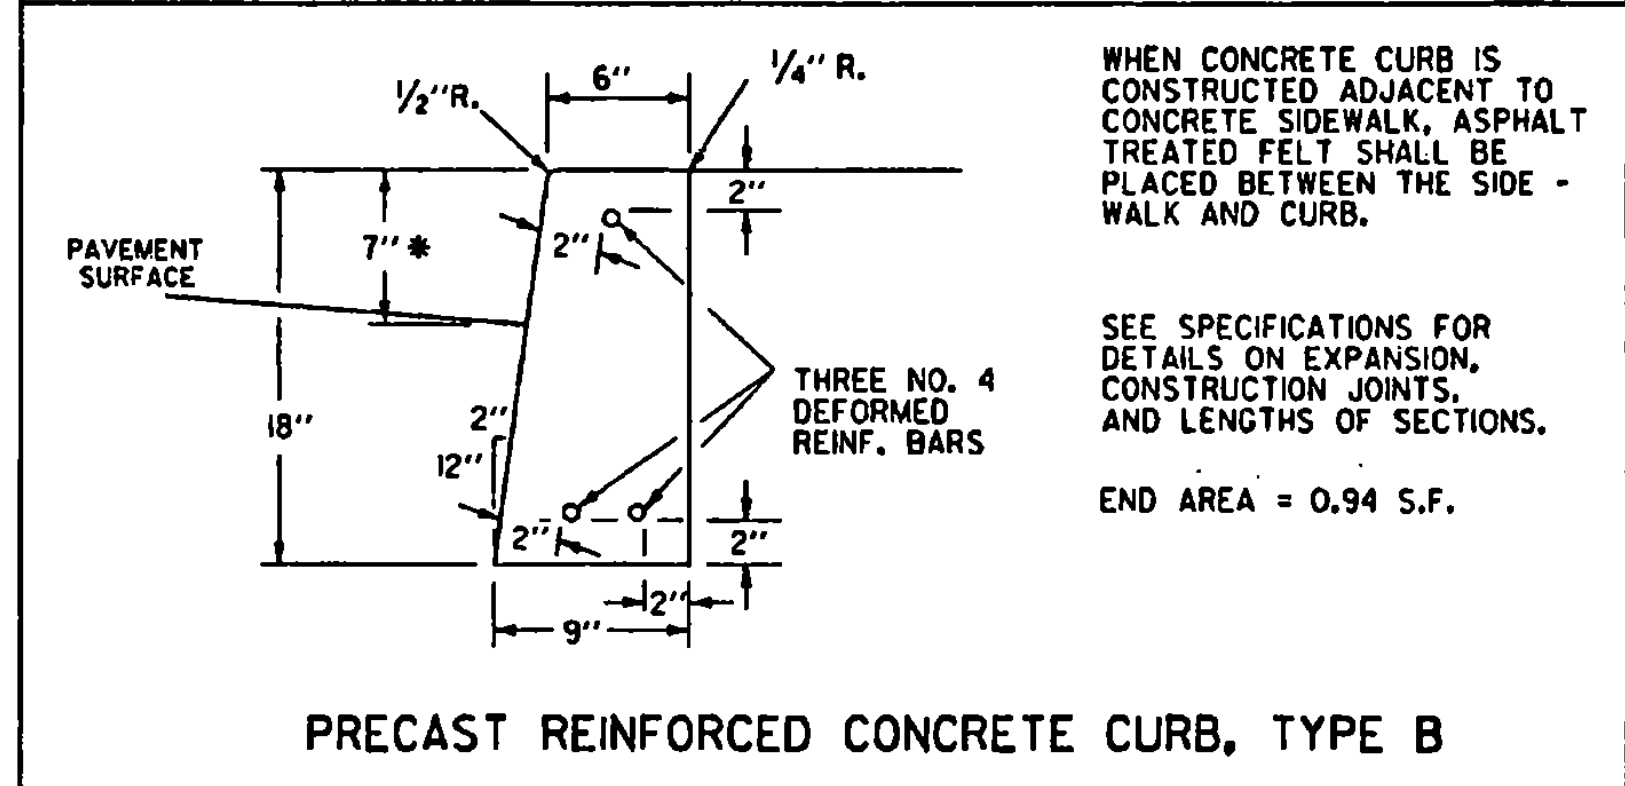
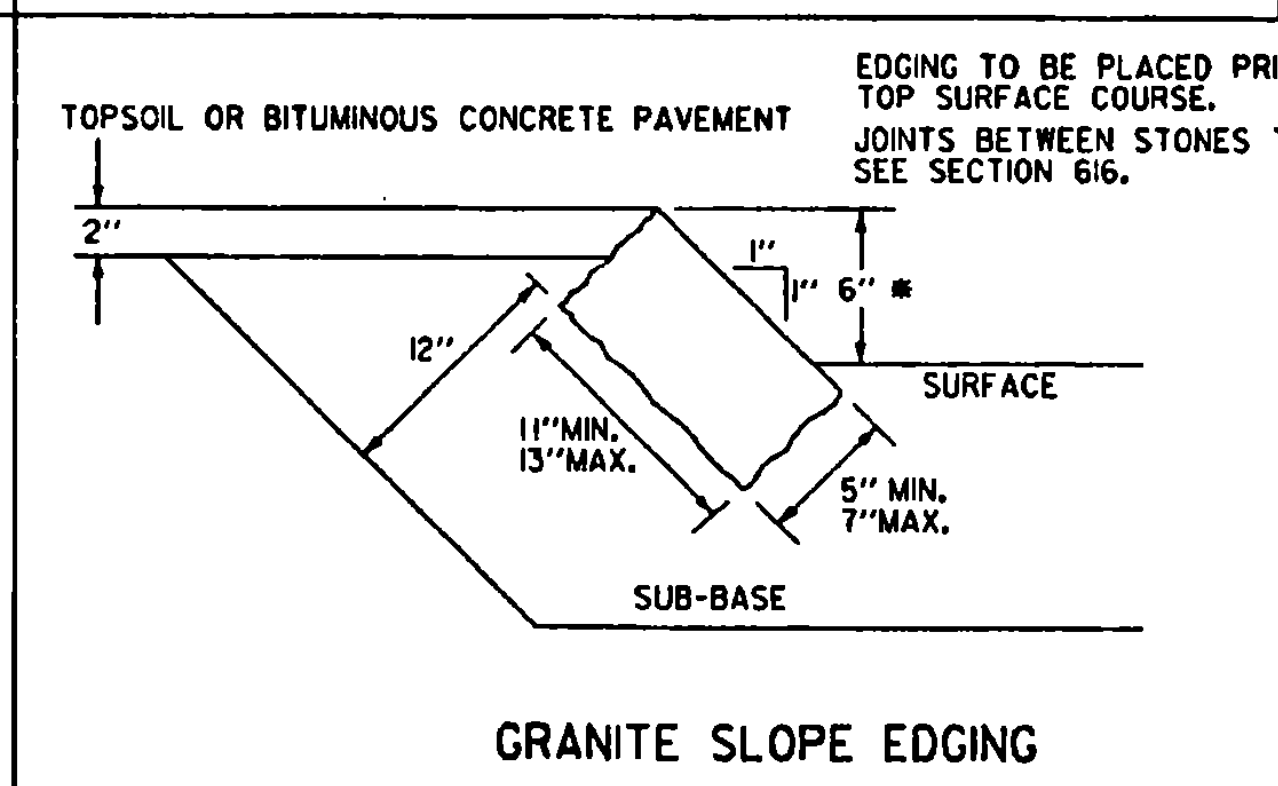
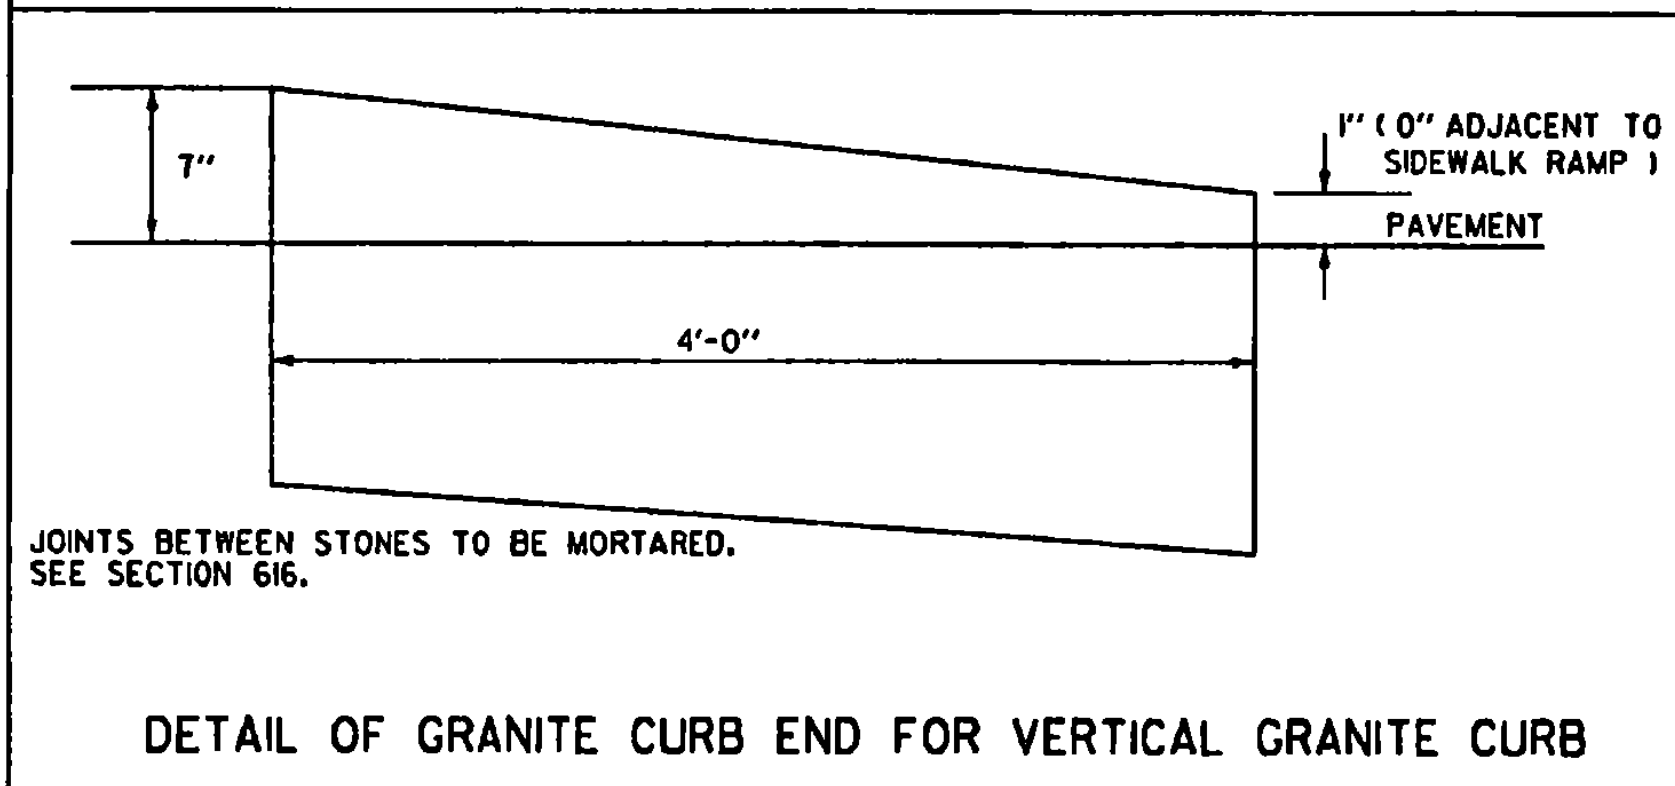


**NOTE**  
 \* HEIGHT NOT TO EXCEED 4" WHEN CURBING IS INSTALLED ADJACENT TO GUARDRAIL (STANDARD SHAPE TO BE BURIED TO THIS DEPTH)

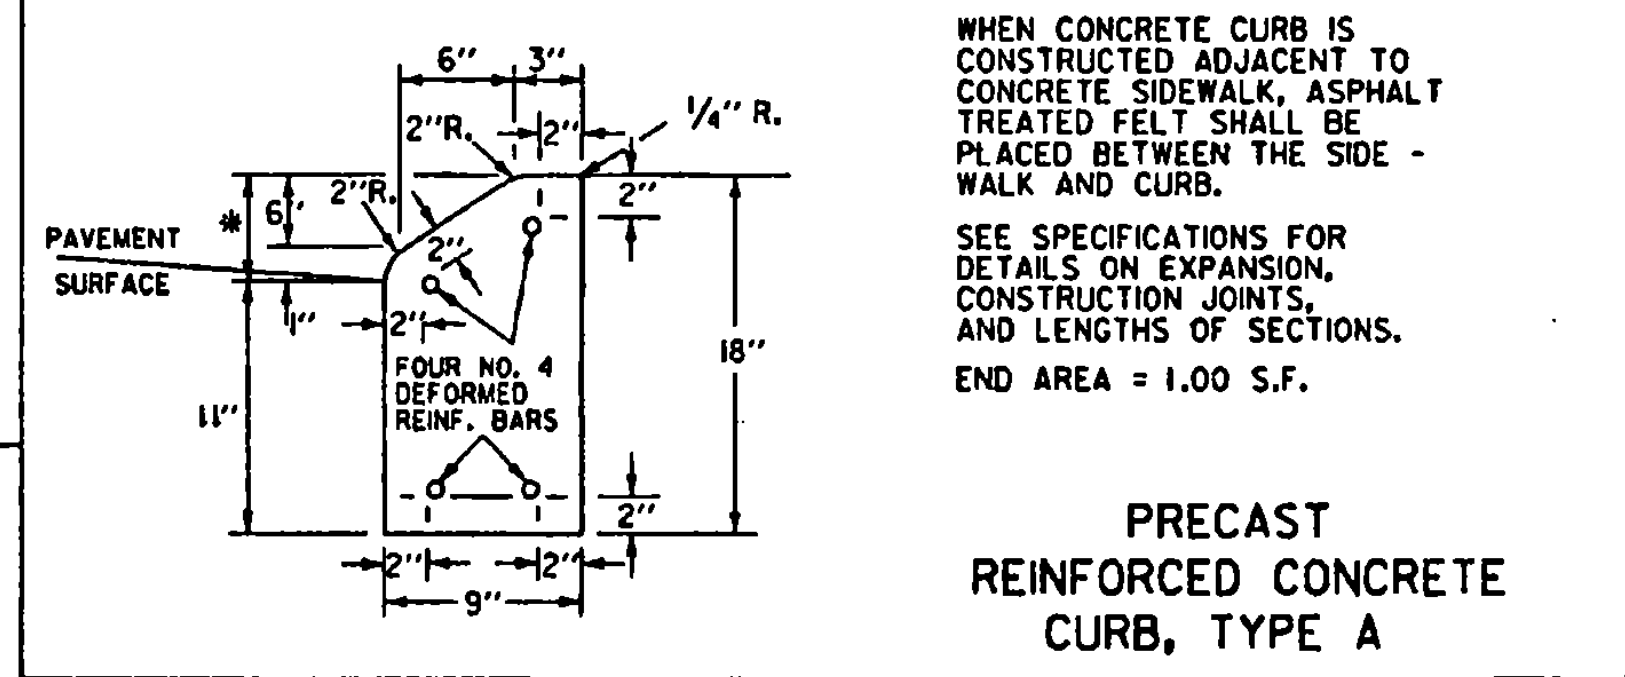

**REVISIONS AND CORRECTIONS**  
 DEC. 8, 1971 - ORIGINAL APPROVAL DATE  
 NOV 16, 1992 - CHANGED 6" CURB TO 4"  
 JUNE 1, 1994 - REISSUED, WITHOUT CHANGE, UNDER NEW SIGNATURES.

**APPROVED**  
 [Signature] DIRECTOR OF ENGINEERING  
 [Signature] DESIGN ENGINEER

**GRANITE SLOPE EDGING  
 VERTICAL GRANITE CURB  
 PRECAST REINFORCED CONCRETE CURB  
 CAST IN PLACE CONCRETE CURB  
 TREATED TIMBER CURB**

