


INDEX OF SHEETS

1	TITLE SHEET
2	PRELIMINARY INFORMATION SHEET
3	QUANTITY SHEET (1 OF 3)
4	QUANTITY SHEET (2 OF 3)
5	QUANTITY SHEET (3 OF 3)
6-8	ROW SHEETS
9	TIE SHEET AND TYPICAL DETAILS
10	PLAN (1 OF 2)
11	PLAN (2 OF 2)
12	PROFILE AND BANKING DIAGRAM
13	TRAFFIC CONTROL PLAN
14	CONSTRUCTION PHASING (1 OF 2)
15	CONSTRUCTION PHASING (2 OF 2)
16	BORING LOGS AND INFORMATION (1 OF 2)
17	BORING LOGS AND INFORMATION (2 OF 2)
18	PLAN AND ELEVATION
19	CONSTRUCTION NOTES
20	DECK DETAILS
21	DECK REINFORCEMENT
22	CURTAIN WALL
23	FRAMING PLAN
24	BEAM ELEVATION AND DETAILS
25	BEARING DETAILS
26	APPROACH SLABS
27	ABUTMENT REMOVAL AND REPAIR
28	ABUTMENT NO. 1
29	ABUTMENT NO. 2
30	SUBSTRUCTURE DETAILS
31	WINGWALL FOOTINGS
32	BRIDGE RAILING (1 OF 2)
33	BRIDGE RAILING (2 OF 2)
34	REINFORCING STEEL SCHEDULE
35-41	ROADWAY CROSS SECTIONS
42-44	CHANNEL CROSS SECTIONS
45	EROSION CONTROL NARRATIVE
46	EXISTING CONDITIONS SITE PLAN
47	EROSION PREVENTION & SEDIMENT CONTROL (EPSC) PLAN
48	FINAL CONDITIONS SITE PLAN
49	EPSC-1M
50	EPSC-2M
51	EPSC-3M
52	EPSC-4M
53	EPSC-5M
54	EPSC-6M
55-70	EXISTING PLANS

STANDARDS			
D-3	06-01-94	E-121	08-08-95
E-100	01-02-04	E-140	08-30-96
E-101	05-30-03	E-142	09-20-95
E-102	06-30-03	E-160	05-20-99
E-102A	05-01-04	E-163	05-20-99
E-106	03-01-04	E-170	11-04-99
E-107	06-30-03	E-171A	08-09-95
E-107A	08-08-95	E-171B	08-09-95
E-108	08-18-95	E-171C	08-09-95
E-110	08-08-95	E-172	08-09-95
E-175	11-17-93		
E-193	08-18-95		
G-1	01-03-00		
G-1D	01-03-00		
G-4	06-01-94		
G-18	06-01-94		
G-19	11-15-02		

STATE OF VERMONT AGENCY OF TRANSPORTATION

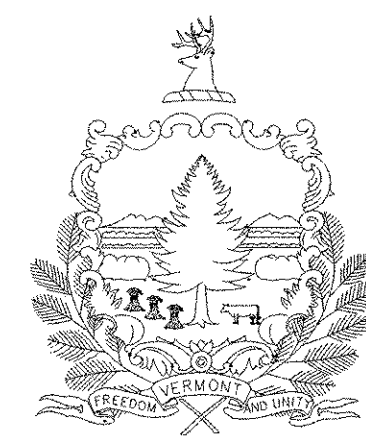

PROPOSED IMPROVEMENT BRIDGE PROJECT


TOWN OF FAYSTON
COUNTY OF WASHINGTON

ROUTE NO. VT 17 (MAJOR COLLECTOR), BRIDGE NO. 36

PROJECT LOCATION: BEGINNING AT A POINT 1.64 km WESTERLY OF THE WAITSFIELD-FAYSTON TOWN LINE AND EXTENDING EASTERLY 0.10 km.

PROJECT DESCRIPTION: REMOVAL OF EXISTING SUPERSTRUCTURE, CONSTRUCTION OF A NEW STEEL BEAM, CONCRETE DECK SUPERSTRUCTURE, REHABILITATION AND WIDENING OF SUBSTRUCTURE WITH RELATED ROADWAY AND CHANNEL WORK.


LENGTH OF STRUCTURE: 24.570 m
LENGTH OF ROADWAY: 75.430 m
LENGTH OF PROJECT: 100.000 m

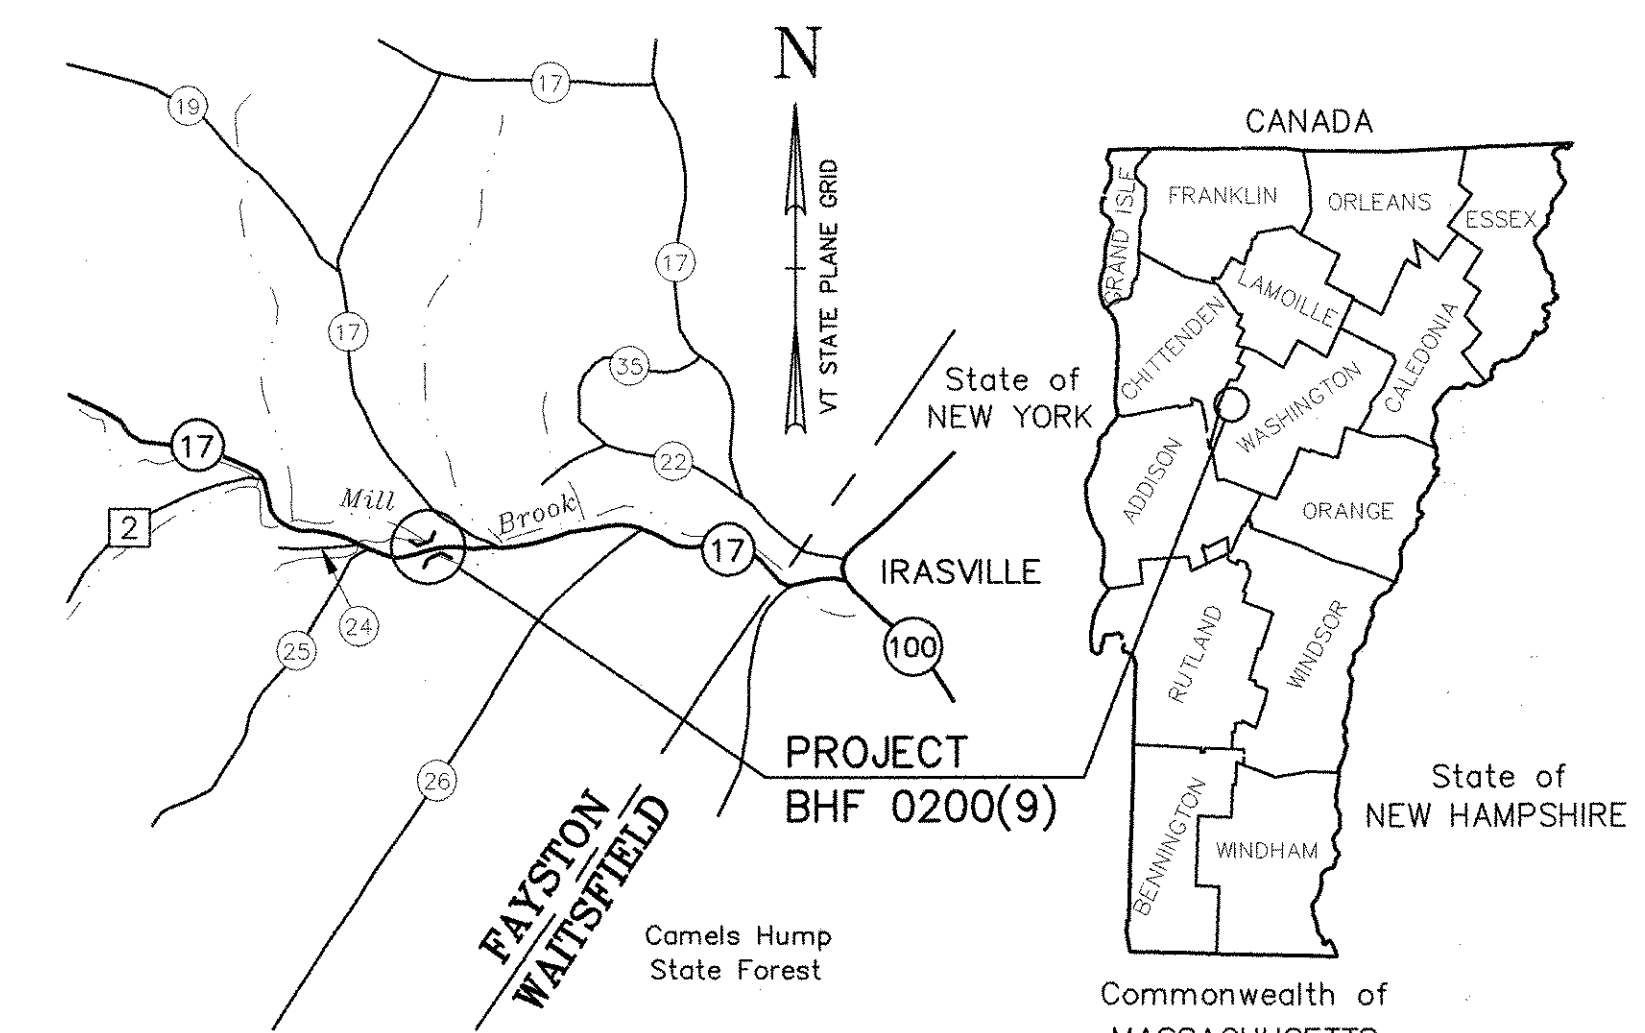



LOCATION MAP

RECORD PLANS	
CONTRACTOR:	WINTERSET, INC. - LYNDON, VT
RESIDENT ENGINEER:	RICK HALE
CONSTRUCTION BEGAN:	SEPTEMBER 8, 2006
CONSTRUCTION COMPLETE:	AUGUST 21, 2007
RECORD PLANS BY:	RICK HALE & C. PIERCE
I HEREBY CERTIFY THAT ALL THE CONSTRUCTION REQUIRED BY THIS SET OF DRAWINGS HAS BEEN ACCOMPLISHED AS INDICATED HEREIN.	
BY:	<i>Rick Hale</i> RESIDENT ENGINEER
DATE:	4-10-9
NOTE: Any further information concerning final quantities, amounts or other details relative to this project may be found at Central Files in the electronic archives.	

CONVENTIONAL SYMBOLS	
COUNTY LINE	---
TOWN LINE	- - - -
LIMITS OF ACCESS	○-○-○-○
POINT OF ACCESS	X
FENCE LINE	-x-x-
STONE WALL	○-○-○-○
TRAVELED WAY	—+—+—+—+—
GUARD RAIL	—+—+—+—+—
RAILROAD	—+—+—+—+—
SURVEY LINE	—+—+—+—+—
CULVERT	—+—+—+—+—
UTILITY POLE	○
OVERHEAD WIRE	DHW
TREES	⊗
CONTROL OF ACCESS	///
PROPERTY LINE	---
R.O.W.	—+—+—+—+—
SLOPE RIGHTS	○-SR-△
TOP OF CUT	△
TOE OF CONST. SLOPE	○

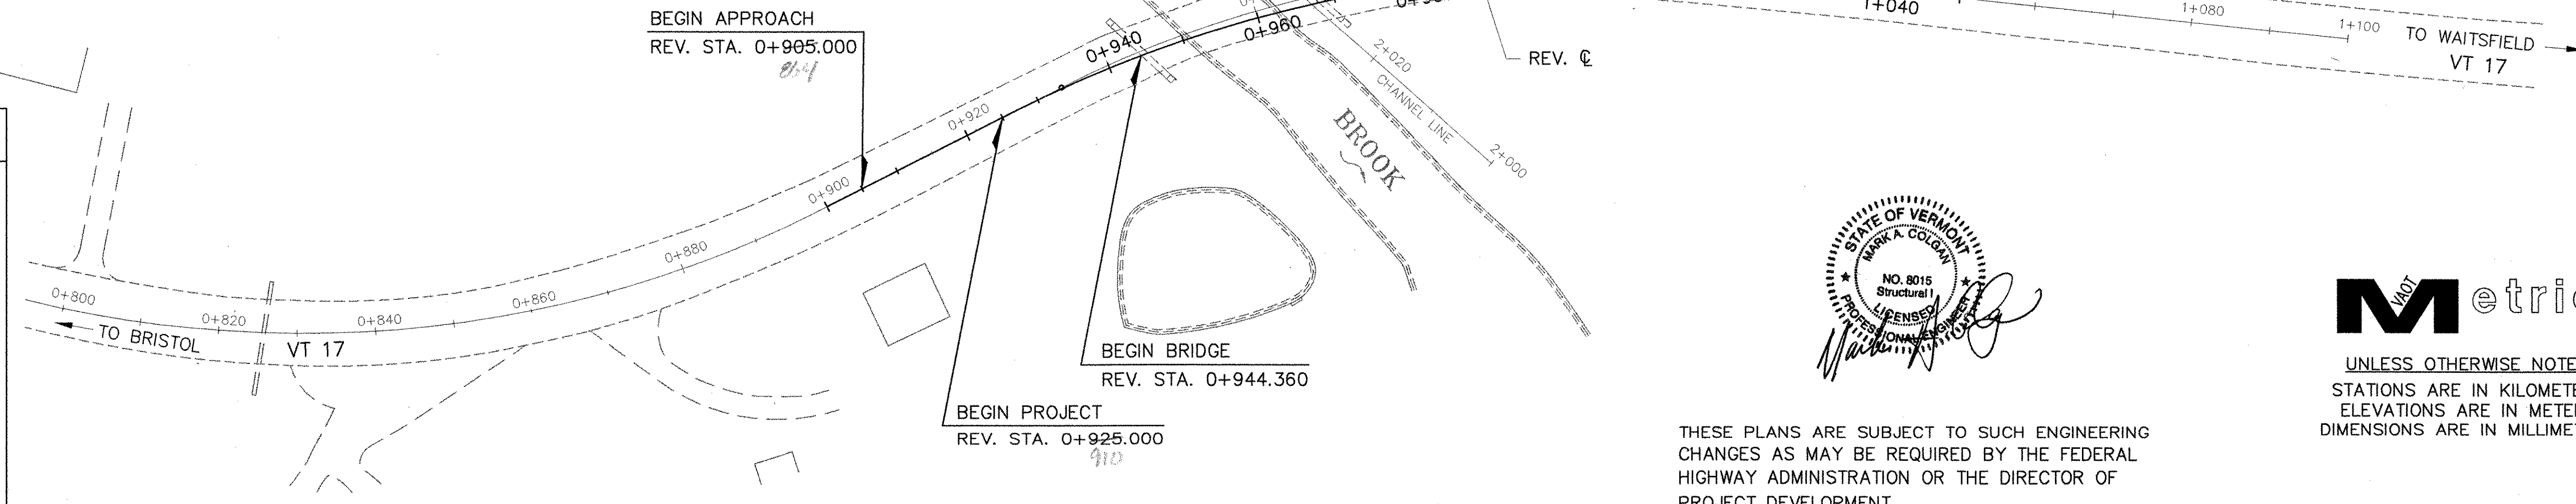

SURVEYED BY :	
SURVEYED DATE :	
DATUM	
VERTICAL	NAVD 1988
HORIZONTAL	NAD 83-92

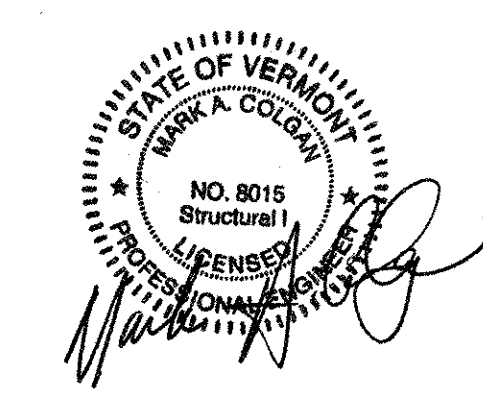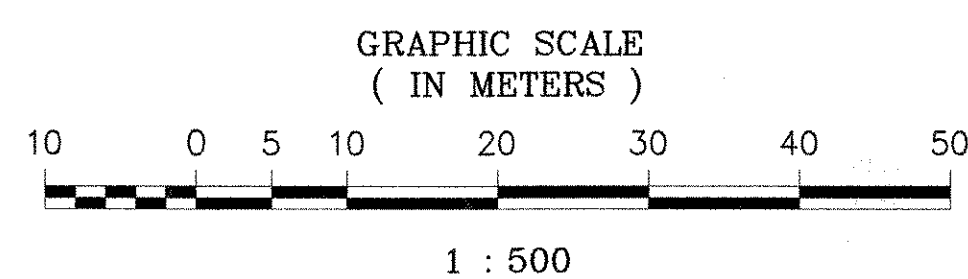

UNLESS OTHERWISE NOTED
STATIONS ARE IN KILOMETERS
ELEVATIONS ARE IN METERS
DIMENSIONS ARE IN MILLIMETERS

THESE PLANS ARE SUBJECT TO SUCH ENGINEERING CHANGES AS MAY BE REQUIRED BY THE FEDERAL HIGHWAY ADMINISTRATION OR THE DIRECTOR OF PROJECT DEVELOPMENT.

CONSTRUCTION IS TO BE CARRIED ON IN ACCORDANCE WITH THESE PLANS AND THE STANDARD SPECIFICATIONS FOR CONSTRUCTION DATED 2001, AS APPROVED BY THE FEDERAL HIGHWAY ADMINISTRATION ON JANUARY 4, 2001 FOR USE ON THIS PROJECT, INCLUDING ALL SUBSEQUENT REVISIONS AND SUCH REVISED SPECIFICATIONS AND SPECIAL PROVISIONS AS ARE INCORPORATED IN THESE PLANS.

DIRECTOR OF PROGRAM DEVELOPMENT	
APPROVED:	<i>James V. Beck</i> DATE 5-09-2006
PROJECT MANAGER :	WAYNE B. SYMONDS
PROJECT NAME :	FAYSTON
PROJECT NUMBER :	BHF 0200(9) (READVERTISED)
SHEET 1 OF 70 SHEETS	

VHB Vanasse Hangen Brustlin, Inc.