


LINES SHOWN ON THIS PLAN AS EXISTING PROPERTY LINES (P/L) ARE BELIEVED TO BE ACCURATE BUT SHOULD NOT BE RELIED UPON FOR PURPOSES UNRELATED TO THE STATE OF VERMONT'S ACQUISITION OF LAND AND RIGHTS FOR THIS PROJECT.

PLAN
SCALE: 1:250

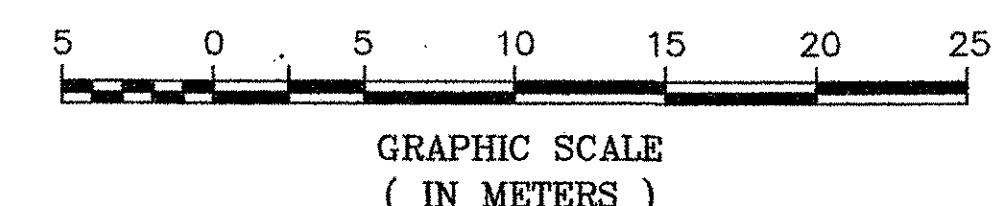

FOR ROW
USE ONLY

CONSTRUCTION NOTES

- REMOVAL AND DISPOSAL OF GUARD RAIL**
STA. 0+880.0 - REV. STA. 0+948.0 RT.
REV. STA. 0+970.7 - 1+006.0 RT.
REV. STA. 0+904.3 - 0+942.2 LT.
REV. STA. 0+985.5 - 0+981.8 LT.
- HEAVY DUTY STEEL BEAM GUARD RAIL**
STA. 0+860.0 - REV. STA. 0+929.2 LT.
STA. 0+894.3, 3.65 m RT. - REV. STA. 0+932.4, 4.50 m RT.
REV. STA. 0+986.6 - STA. 1+033.0 RT.
- MODIFIED ECCENTRIC LOADER TERMINAL**
REV. STA. 0+975.6 - 0+986.7 LT.
- MANUFACTURED TERMINAL SECTION**
STA. 0+879.5, 4.44 m RT. - 0+894.3, 3.71 m RT.

- GUARD RAIL APPROACH SECTION, TYPE I (MODIFIED)**
REV. STA. 0+932.4 - 0+940.3 RT.
REV. STA. 0+978.8 - 0+986.6 RT.
REV. STA. 0+929.2 - 0+936.7 LT.
REV. STA. 0+968.2 - 0+975.6 LT.
- BRIDGE RAILING - 2' RAIL GALVANIZED BOX BEAM (MODIFIED)**
REV. STA. 0+936.7 - 0+968.2 LT.
REV. STA. 0+940.3 - 0+976.8 RT.
- COLD PLACING BIT. CONCRETE PAVEMENT**
STA. 0+890.0 - REV. STA. 0+905.0
REV. STA. 1+045.0 - STA. 1+050.0
- DURABLE 100 mm WHITE LINE**
STA. 0+890.0 - STA. 1+050.0 LT, RT
- DURABLE 100 mm YELLOW LINE**
STA. 0+890.0 - STA. 1+050.0 (DOUBLE CENTER LINE)

FOR EROSION SHEET
SEE R.O.W. SHEET 8 OF 11 SHEETS.

0+880 RT. ~ 0+950 RT.
NEW SIDESLOPES TO BE CONSTRUCTED WITH STONEFILL, TYPE II AND COVERED WITH 150 mm OF EARTH BORROW. SLOPES ARE TO BE SEED AND MULCHED. NO ADDITIONAL CLEARING AND GRUBBING WILL BE ALLOWED BEYOND THE LIMITS OF THE STONE FILL SLOPE.

- NOTES:
- COLD PLACING AND PAVEMENT SHIMMING WILL BE REQUIRED FROM SURVEY STA. 0+890 TO BEGIN APPROACH AND FROM END APPROACH TO SURVEY STA. 1+070.
 - SEE SHEET 47 FOR TEMPORARY EROSION CONTROL.

STATE OF VERMONT AGENCY OF TRANSPORTATION	
Town Of FAYSTON	Bridge No. 36
Highway No. VT 17	Log Sta. Surv. Sta.
VT 17 OVER MILL BROOK	
PLAN (1 OF 2)	
Designed By S.M. GUNN	Drawn By R.F. CLARK
Checked By _____	Bridge Design Supervisor
Date _____	
PROJECT FAYSTON	PROJECT NO. BHF 0200(9)
I.G.C. Info.	
SHEET 7 OF 70 SHEETS	

VANASSE HANGEN BRUSTLIN, INC.