

LIMITS OF TEMPORARY
DETOUR
(RIGHTS ACQUIRED
BY THE CONTRACTOR)


PROJECT & APPROACHES ADJUSTED IN LENGTH TO ACCOMMODATE
A TEMPORARY DETOUR & PAVING PROJECT (FAYSTON-WAITSFIELD STP 2406(II))

NOTES:

1. COLD PLANING AND PAVEMENT SHIMMING WILL BE REQUIRED FROM SURVEY LINE STA. 0+890 TO BEGIN APPROACH AND FROM END APPROACH TO SURVEY LINE STA. 1+070.
2. SEE SHEETS 45-48 FOR TEMPORARY EROSION CONTROL.
3. NEW SIDESLOPES ARE TO BE CONSTRUCTED WITH STONEFILL, TYPE II AND TYPE IV, STA. 0+880 RT. ~ 0+950 RT. AND COVERED WITH 300 OF GRUBBING MATERIAL. SLOPES ARE TO BE SEEDED AND MULCHED. NO ADDITIONAL CLEARING AND GRUBBING WILL BE ALLOWED BEYOND THE LIMITS OF THE STONE FILL SLOPE.

PLAN

SCALE: 1:250

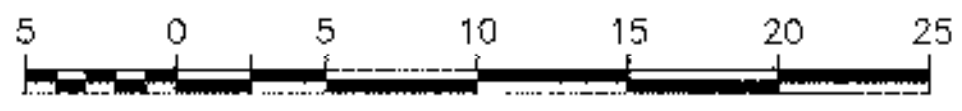

GRAPHIC SCALE
(IN METERS)

SIGN LEGEND
N = NEW
R = REMOVE
RET. = RETAIN
R&S = REMOVE & SALVAGE
S = SALVAGE

EXISTING STRUCTURE
SINGLE SPAN STEEL BEAM, CONCRETE DECK
OVERALL LENGTH = 24.570 m
CONCRETE SPILL THROUGH ABUTMENTS
BRIDGE WIDTH CURB TO CURB = 7.42 m
BUILT IN 1939

CONSTRUCTION NOTES

REMOVAL AND DISPOSAL OF GUARD RAIL
STA. 0+880.0 - REV. STA. 0+946.0 RT.
REV. STA. 0+970.7 - 1+006.0 RT.
REV. STA. 0+904.3 - 0+942.2 LT.
REV. STA. 0+965.5 - 0+981.8 LT.

HEAVY DUTY STEEL BEAM GUARD RAIL
STA. 0+880.0 - REV. STA. 0+932.0 LT.
STA. 0+894.3 - REV. STA. 0+936.5 RT.
REV. STA. 0+983.0 - REV. STA. 1+033.0 RT.

MANUFACTURED TERMINAL SECTION (FLARED)
REV. STA. 0+975.5 - 0+986.5 LT.

MANUFACTURED TERMINAL SECTION (TANGENT)
STA. 0+879.5, 4.44 m RT. - 0+894.3, 3.71 m RT.

ANCHOR FOR STEEL BEAM RAIL
REV. STA. 1+031.8 RT.

GUARD RAIL APPROACH SECTION, NETC 2 RAIL
REV. STA. 0+932.0 - 0+939.4 LT.
REV. STA. 0+968.0 - 0+975.5 LT.
REV. STA. 0+936.5 - 0+944.4 RT.
REV. STA. 0+975.2 - 0+983.0 RT.

BRIDGE RAILING - NETC 2 RAIL
REV. STA. 0+939.4 - 0+968.0 LT.
REV. STA. 0+944.4 - 0+975.2 RT.

COLD PLANING BIT, CONCRETE PAVEMENT
STA. 0+890.0 - REV. STA. 0+905.0
REV. STA. 1+045.0 - STA. 1+050.0

DURABLE 100 mm WHITE LINE
STA. 0+890.0 - STA. 1+050.0 LT, RT

DURABLE 100 mm YELLOW LINE
STA. 0+890.0 - STA. 1+050.0 (DOUBLE CENTER LINE)

**STATE OF VERMONT
AGENCY OF TRANSPORTATION**

Town Of	FAYSTON	Bridge No.	36
Highway No.	VT 17	Log Sta.	
		Surv. Sta.	

PLAN (1 OF 2)

Designed By	S.M. GUNN	Drawn By	B.J. MASSE
Checked By	S.M. GUNN	Date	1/06
		Bridge Design Supervisor	M.A. COLGAN Date 1/06

PROJECT	FAYSTON	PROJECT NO.	BHF 0200(9)
---------	---------	-------------	-------------

L.G.C. Info.	Bridge Sheet No. 50543PLN	Sheet	10 of 70
--------------	---------------------------	-------	----------