
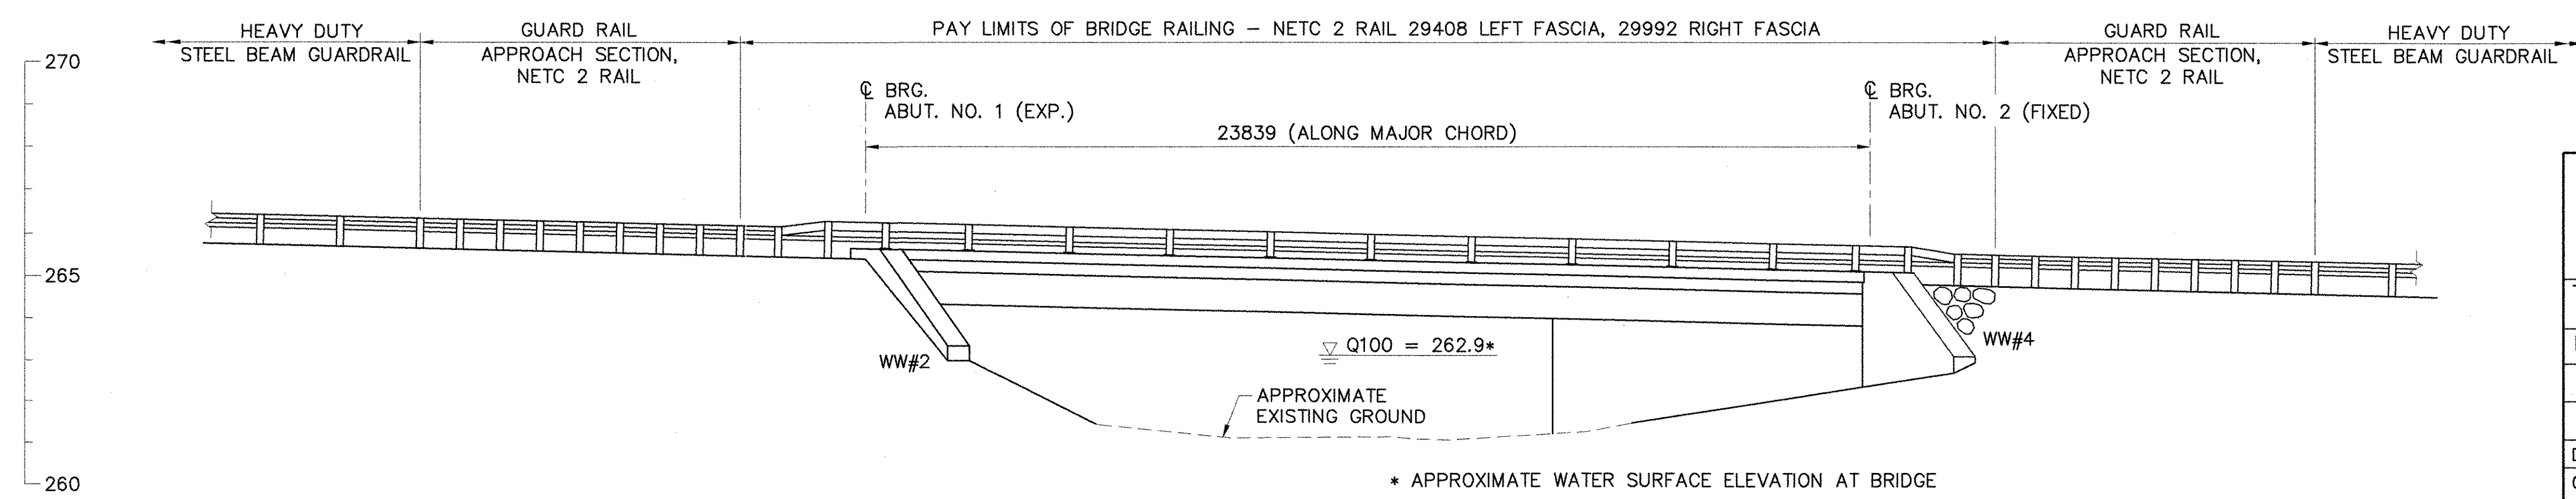


**PLAN**

SCALE: 1:100

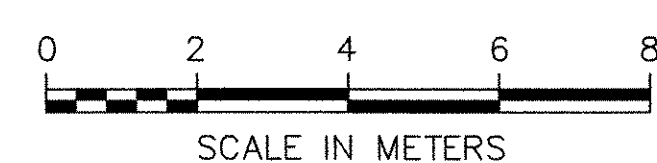

**ELEVATION**

SCALE: 1:100

<b>STATE OF VERMONT AGENCY OF TRANSPORTATION</b>			
Town Of	FAYSTON	Bridge No.	36
Highway No.	VT 17	Log Sta.	
		Surv. Sta.	
VT 17 OVER MILL BROOK			
<b>PLAN AND ELEVATION</b>			
Designed By	S.M. GUNN	Drawn By	B.J. MASSE
Checked By	M.A. COLGAN	Date	1/06
		Bridge Design Supervisor	M.A. COLGAN Date 1/06
PROJECT	FAYSTON	PROJECT NO.	BHF 0200(9)
I.G.C. Info.			
Bridge Sheet No.	50543ELV	Sheet	18 of 70