




APPROACH SLAB NO. 1
SCALE: 1:50

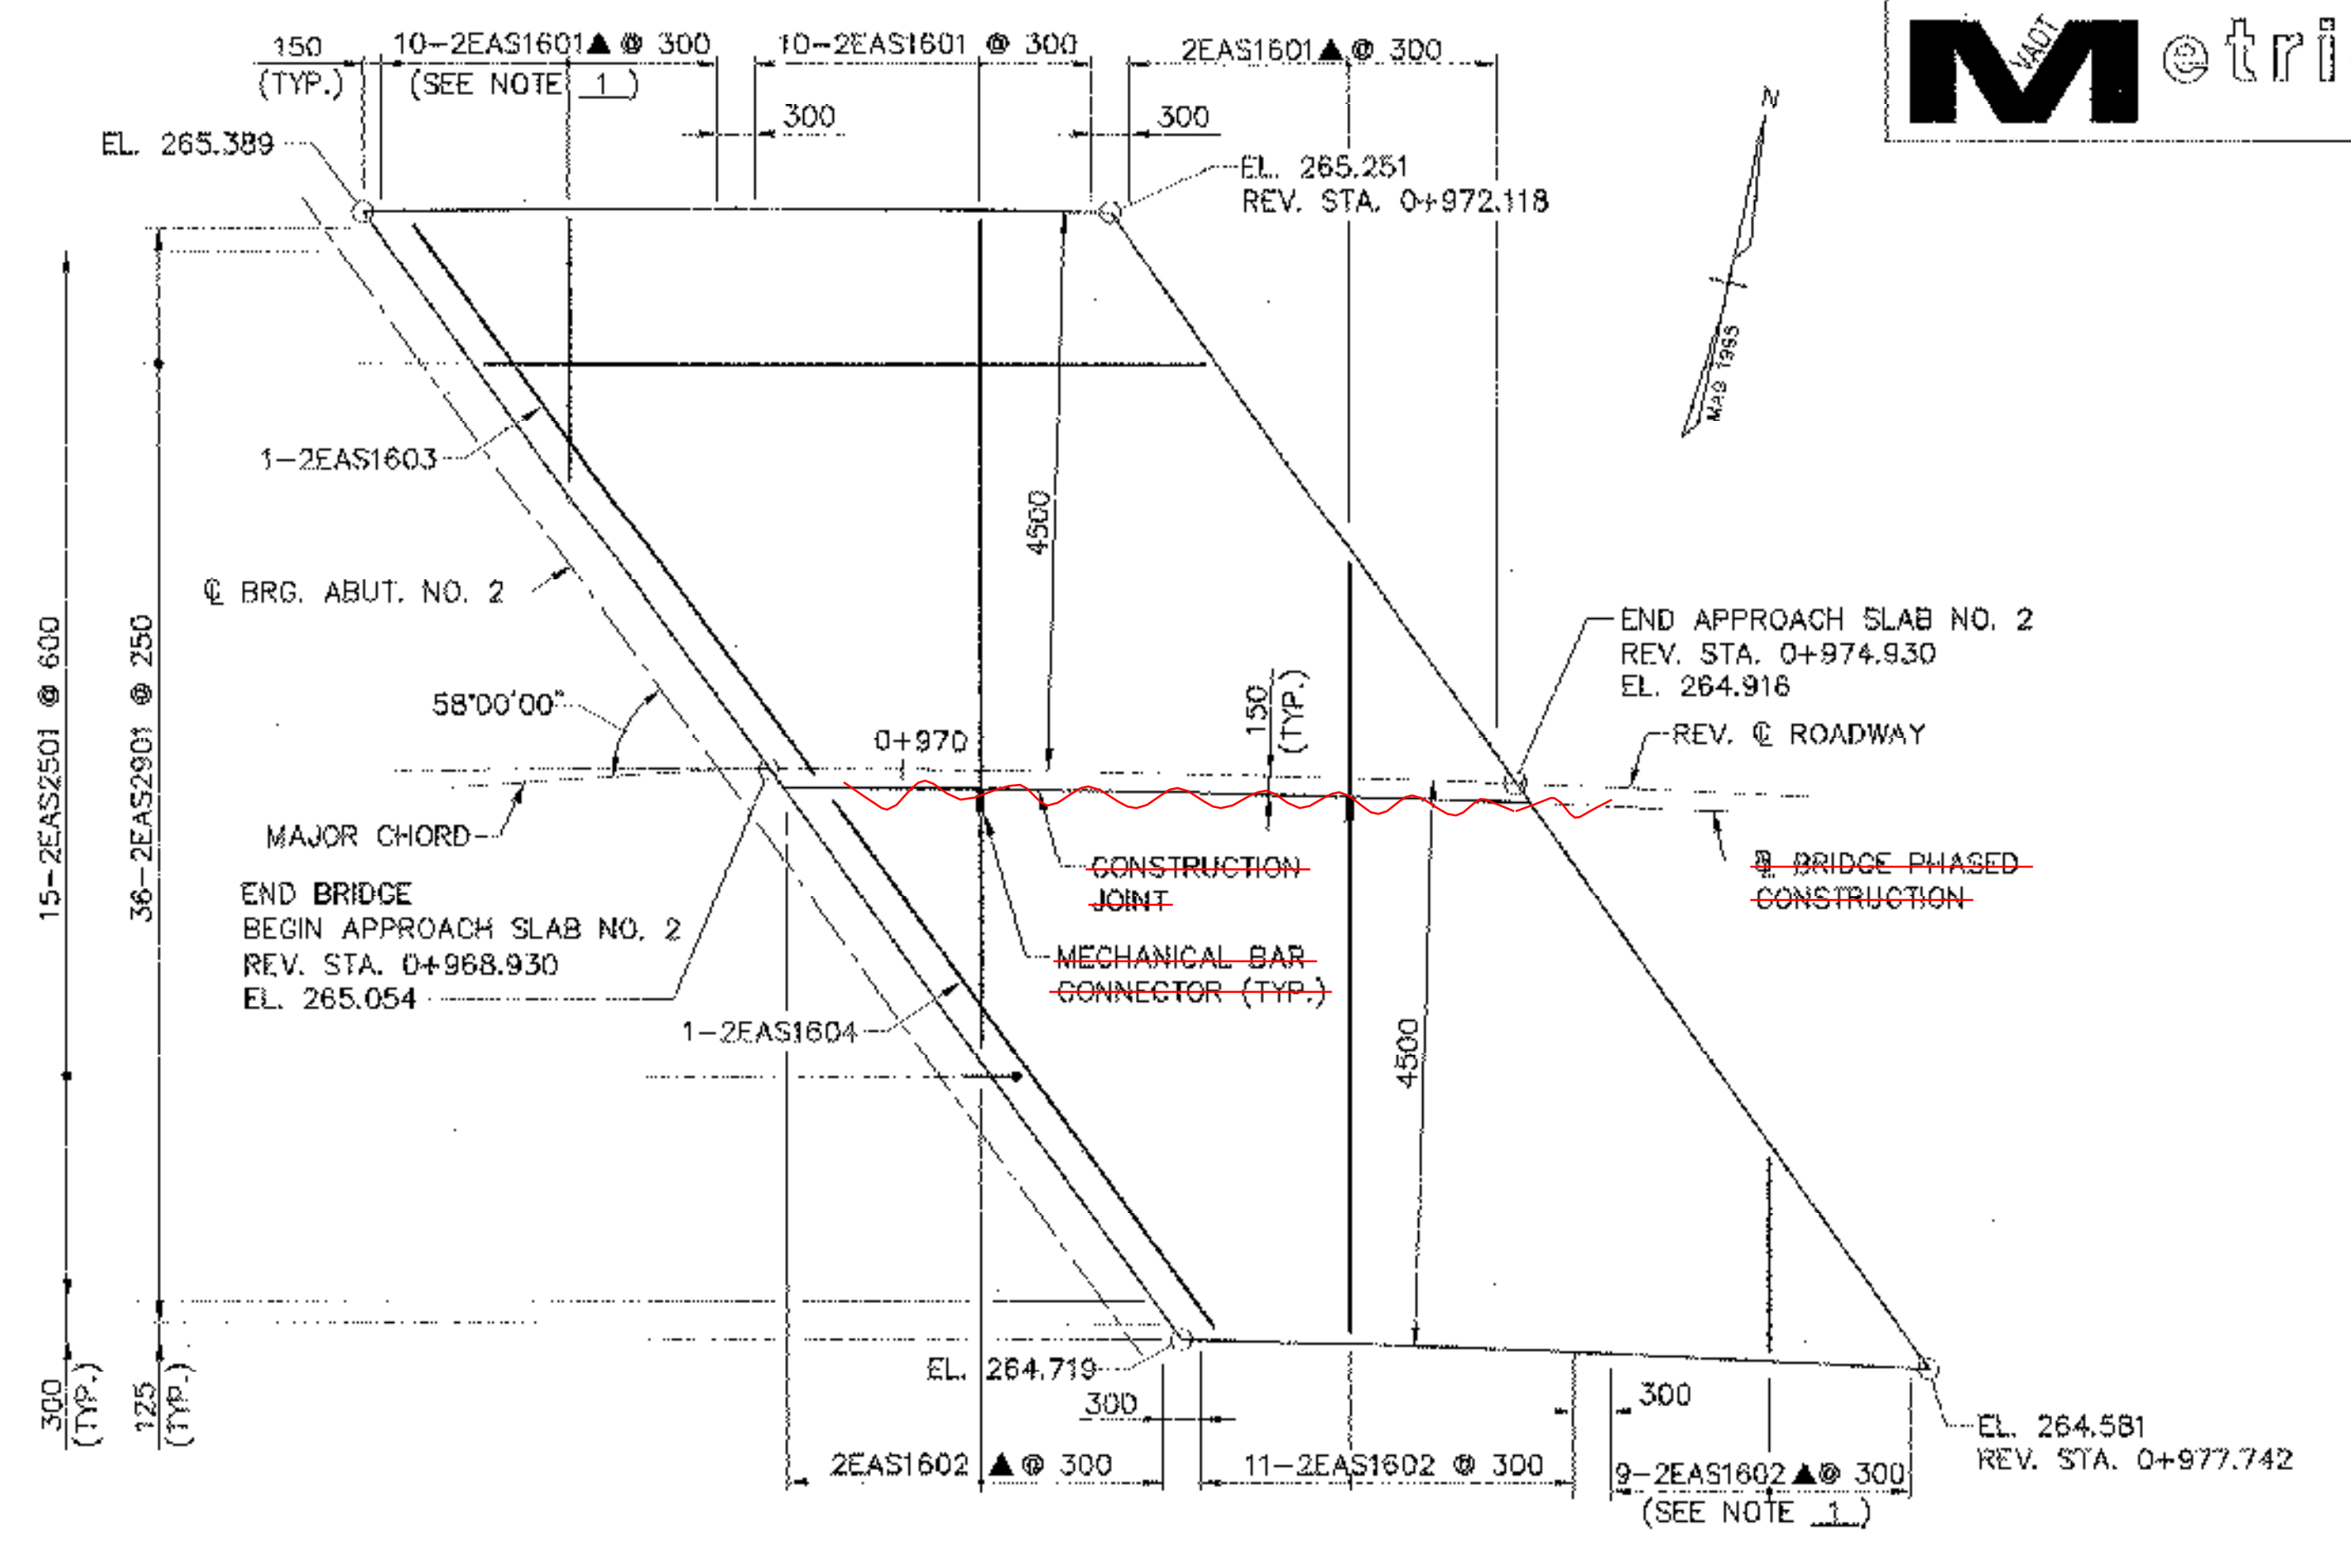


APPROACH SLAB NO. 2
SCALE: 1:50

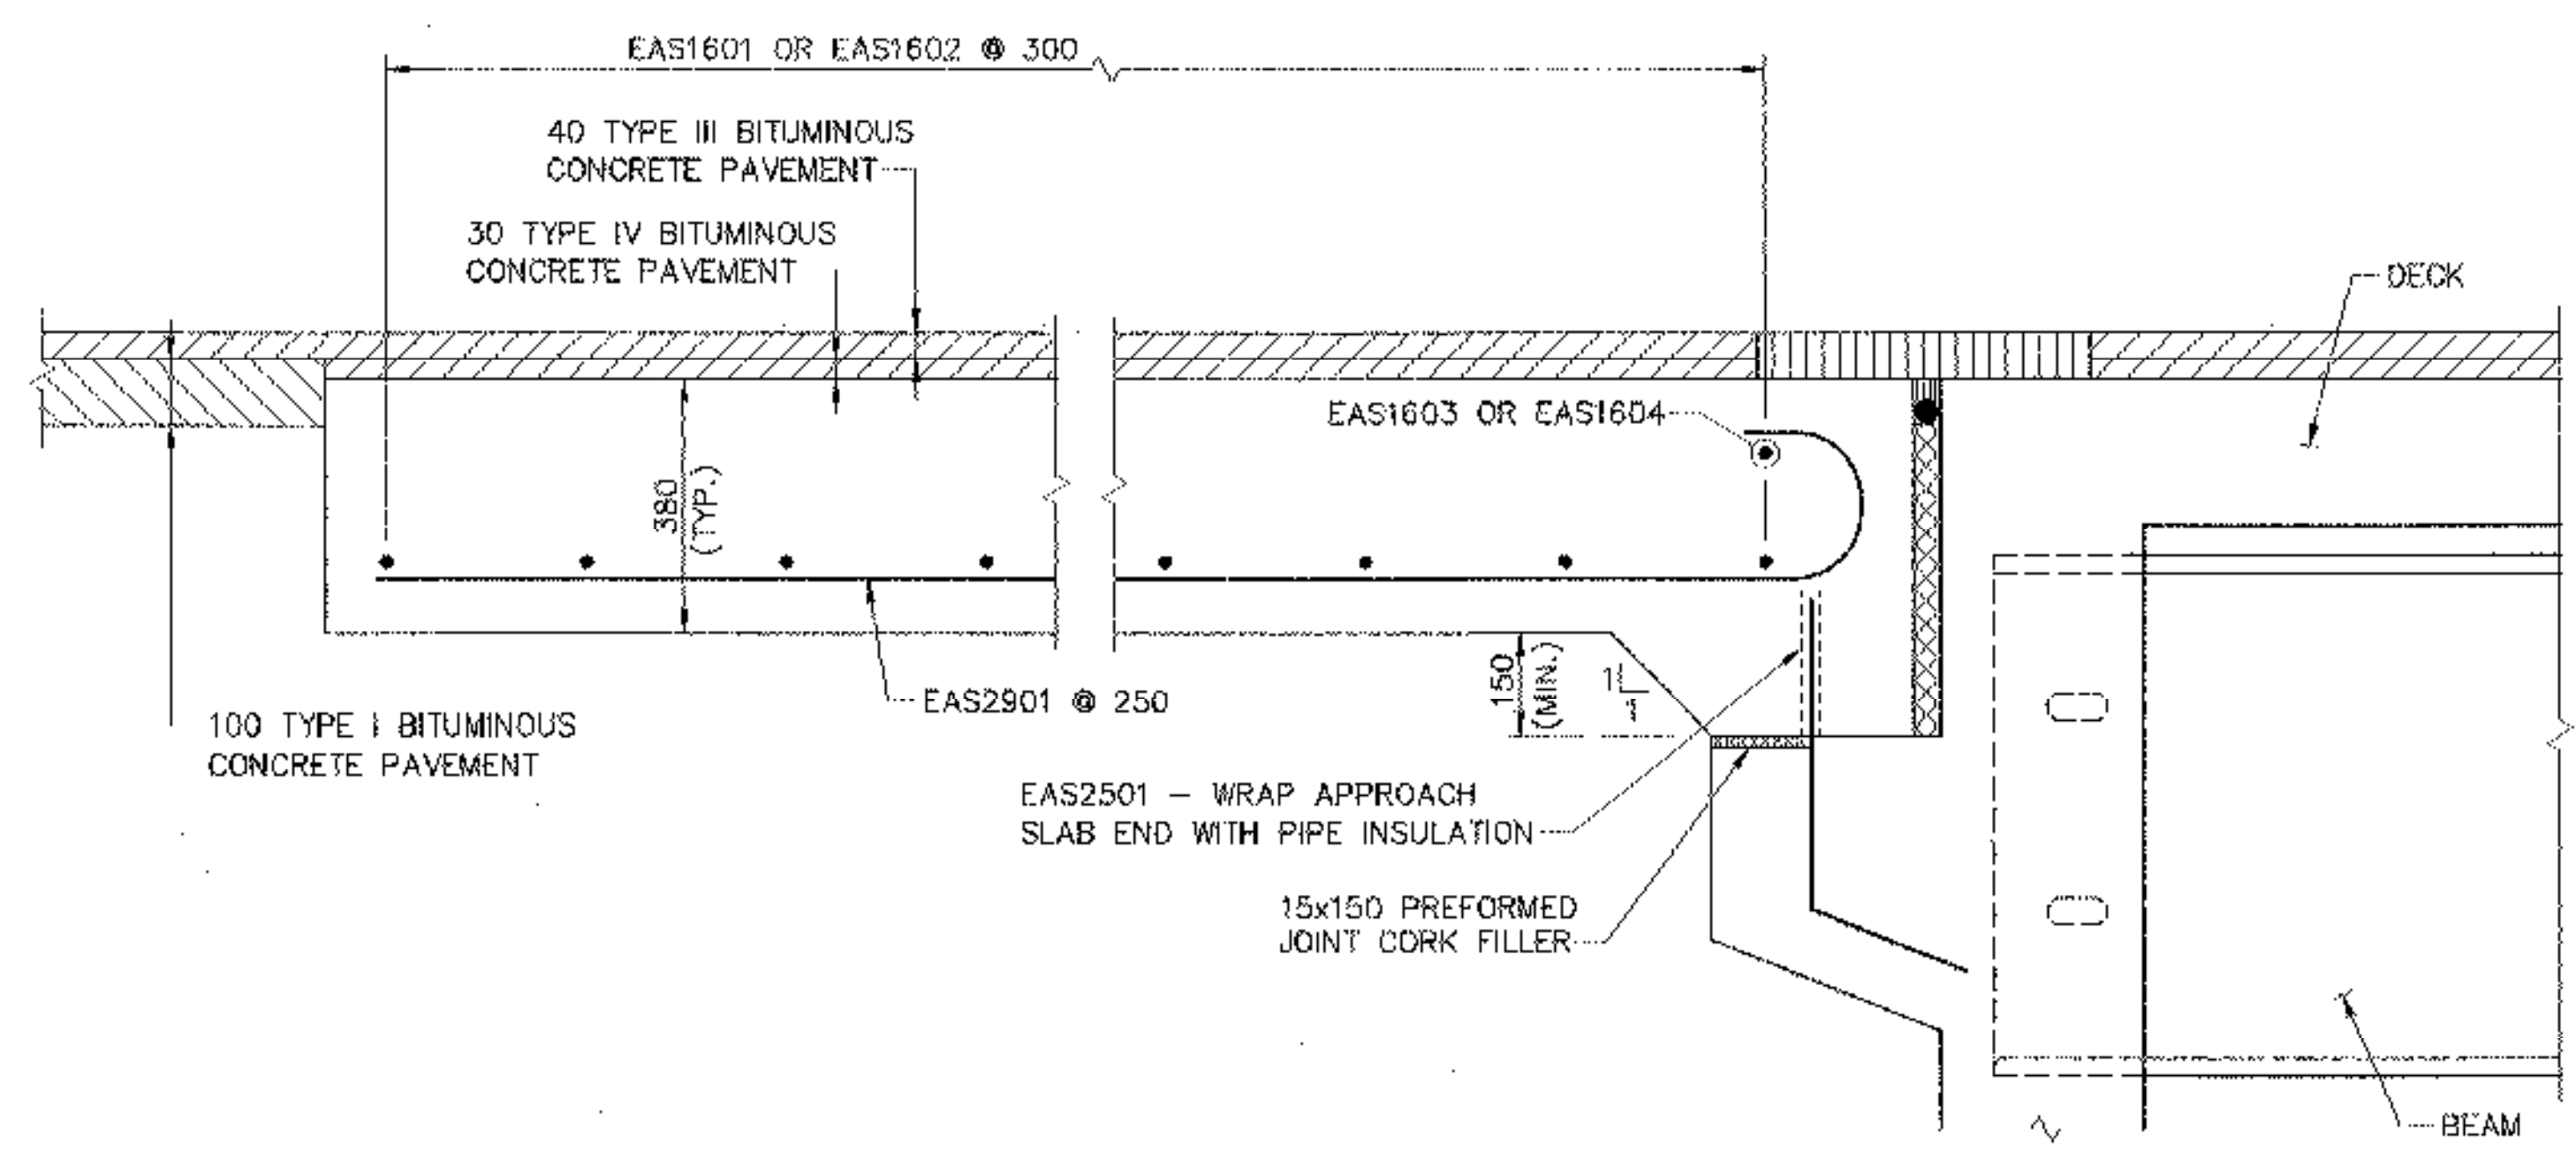

APPROACH SLAB NO. 1 DETAIL
(APPROACH SLAB NO. 2 SIMILAR)
SCALE: 1:10

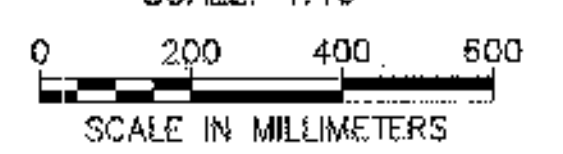

KEY
N.F. = NEAR FACE
F.F. = FAR FACE
E.F. = EACH FACE
▲ = CUT TO FIT IN FIELD

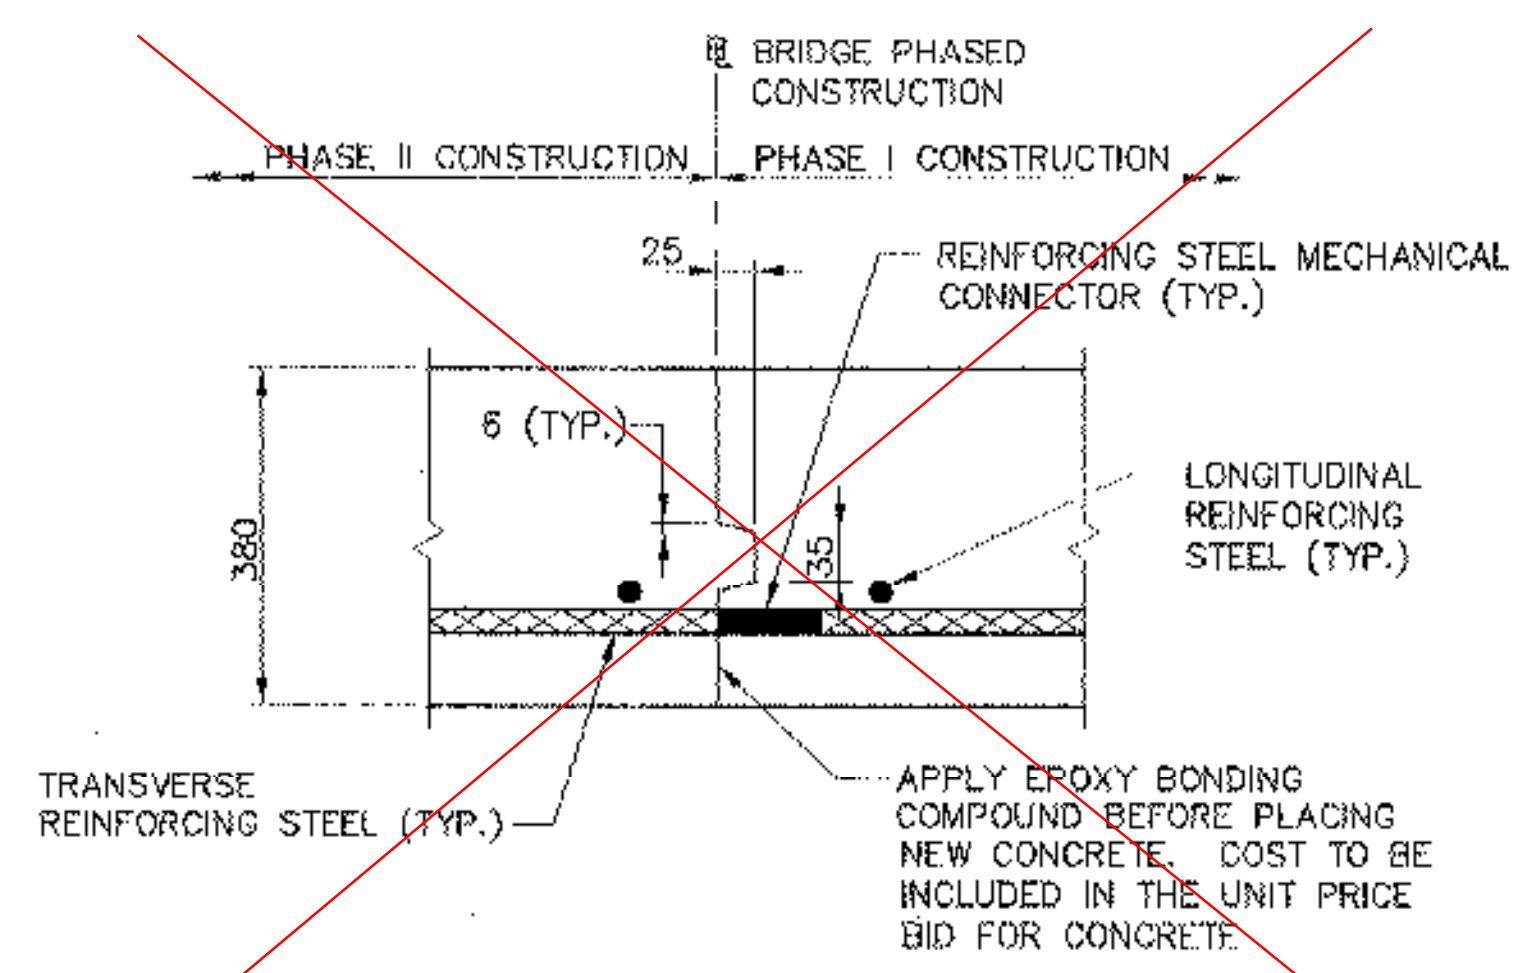

LONGITUDINAL CONSTRUCTION JOINT DETAIL
N.T.S.

NOTE:
1. USE CUTOFFS FROM THIS END FOR THE OTHER END OF APPROACH SLAB.

STATE OF VERMONT AGENCY OF TRANSPORTATION	
Town Of FAYSTON	Bridge No. 36
Highway No. VT 17	Log Sta. Surv. Sta.
VT 17 OVER MILL BROOK	
APPROACH SLABS	
Designed By M.A. COLGAN	Drawn By B.J. MASSE
Checked By S.M. SAREAULT Date 1/06	Bridge Design Supervisor M.A. COLGAN Date 1/06
PROJECT FAYSTON	PROJECT NO. BHF 0200(9)
I.G.C. Info.	
Bridge Sheet No. 50543AS	Sheet 26 of 70