


SEE ROADWAY SECTIONS
 STA. 2+055
 END UNCLASSIFIED CHANNEL EXCAVATION
 STONE FILL TYPE IV
 GEOTEXTILE FOR STONE FILL
 GRUBBING MATERIAL

SEE ROADWAY SECTIONS

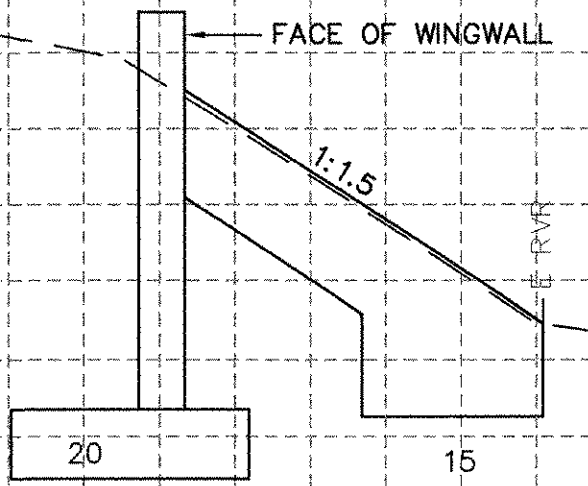

STA. 2+046
 BEGIN UNCLASSIFIED CHANNEL EXCAVATION
 STONE FILL TYPE IV
 GEOTEXTILE FOR STONE FILL
 GRUBBING MATERIAL

SCALE 5 METERS
 HORZI & VERT.

FROM STA. 2+050 TO STA. 2+065 VT 17
 PROJECT NAME FAYSTON 36
 NO. BHF 0200(9)
 SURVEYED BY EIV TECHNICAL SERVICES, LLC 1/96
 SHEET 44 OF 70 SHEETS