


LEGEND

	TREELINE
	OVERHEAD UTILITY
	CULVERT
	UTILITY POLE
	WELL
	PROPOSED GUARDRAIL
	SIGN
	TRAVERSE POINT
	TOP OF CUT TO MATCH EXISTING
	TOE OF SLOPE TO MATCH EXISTING

N
MAG 1995

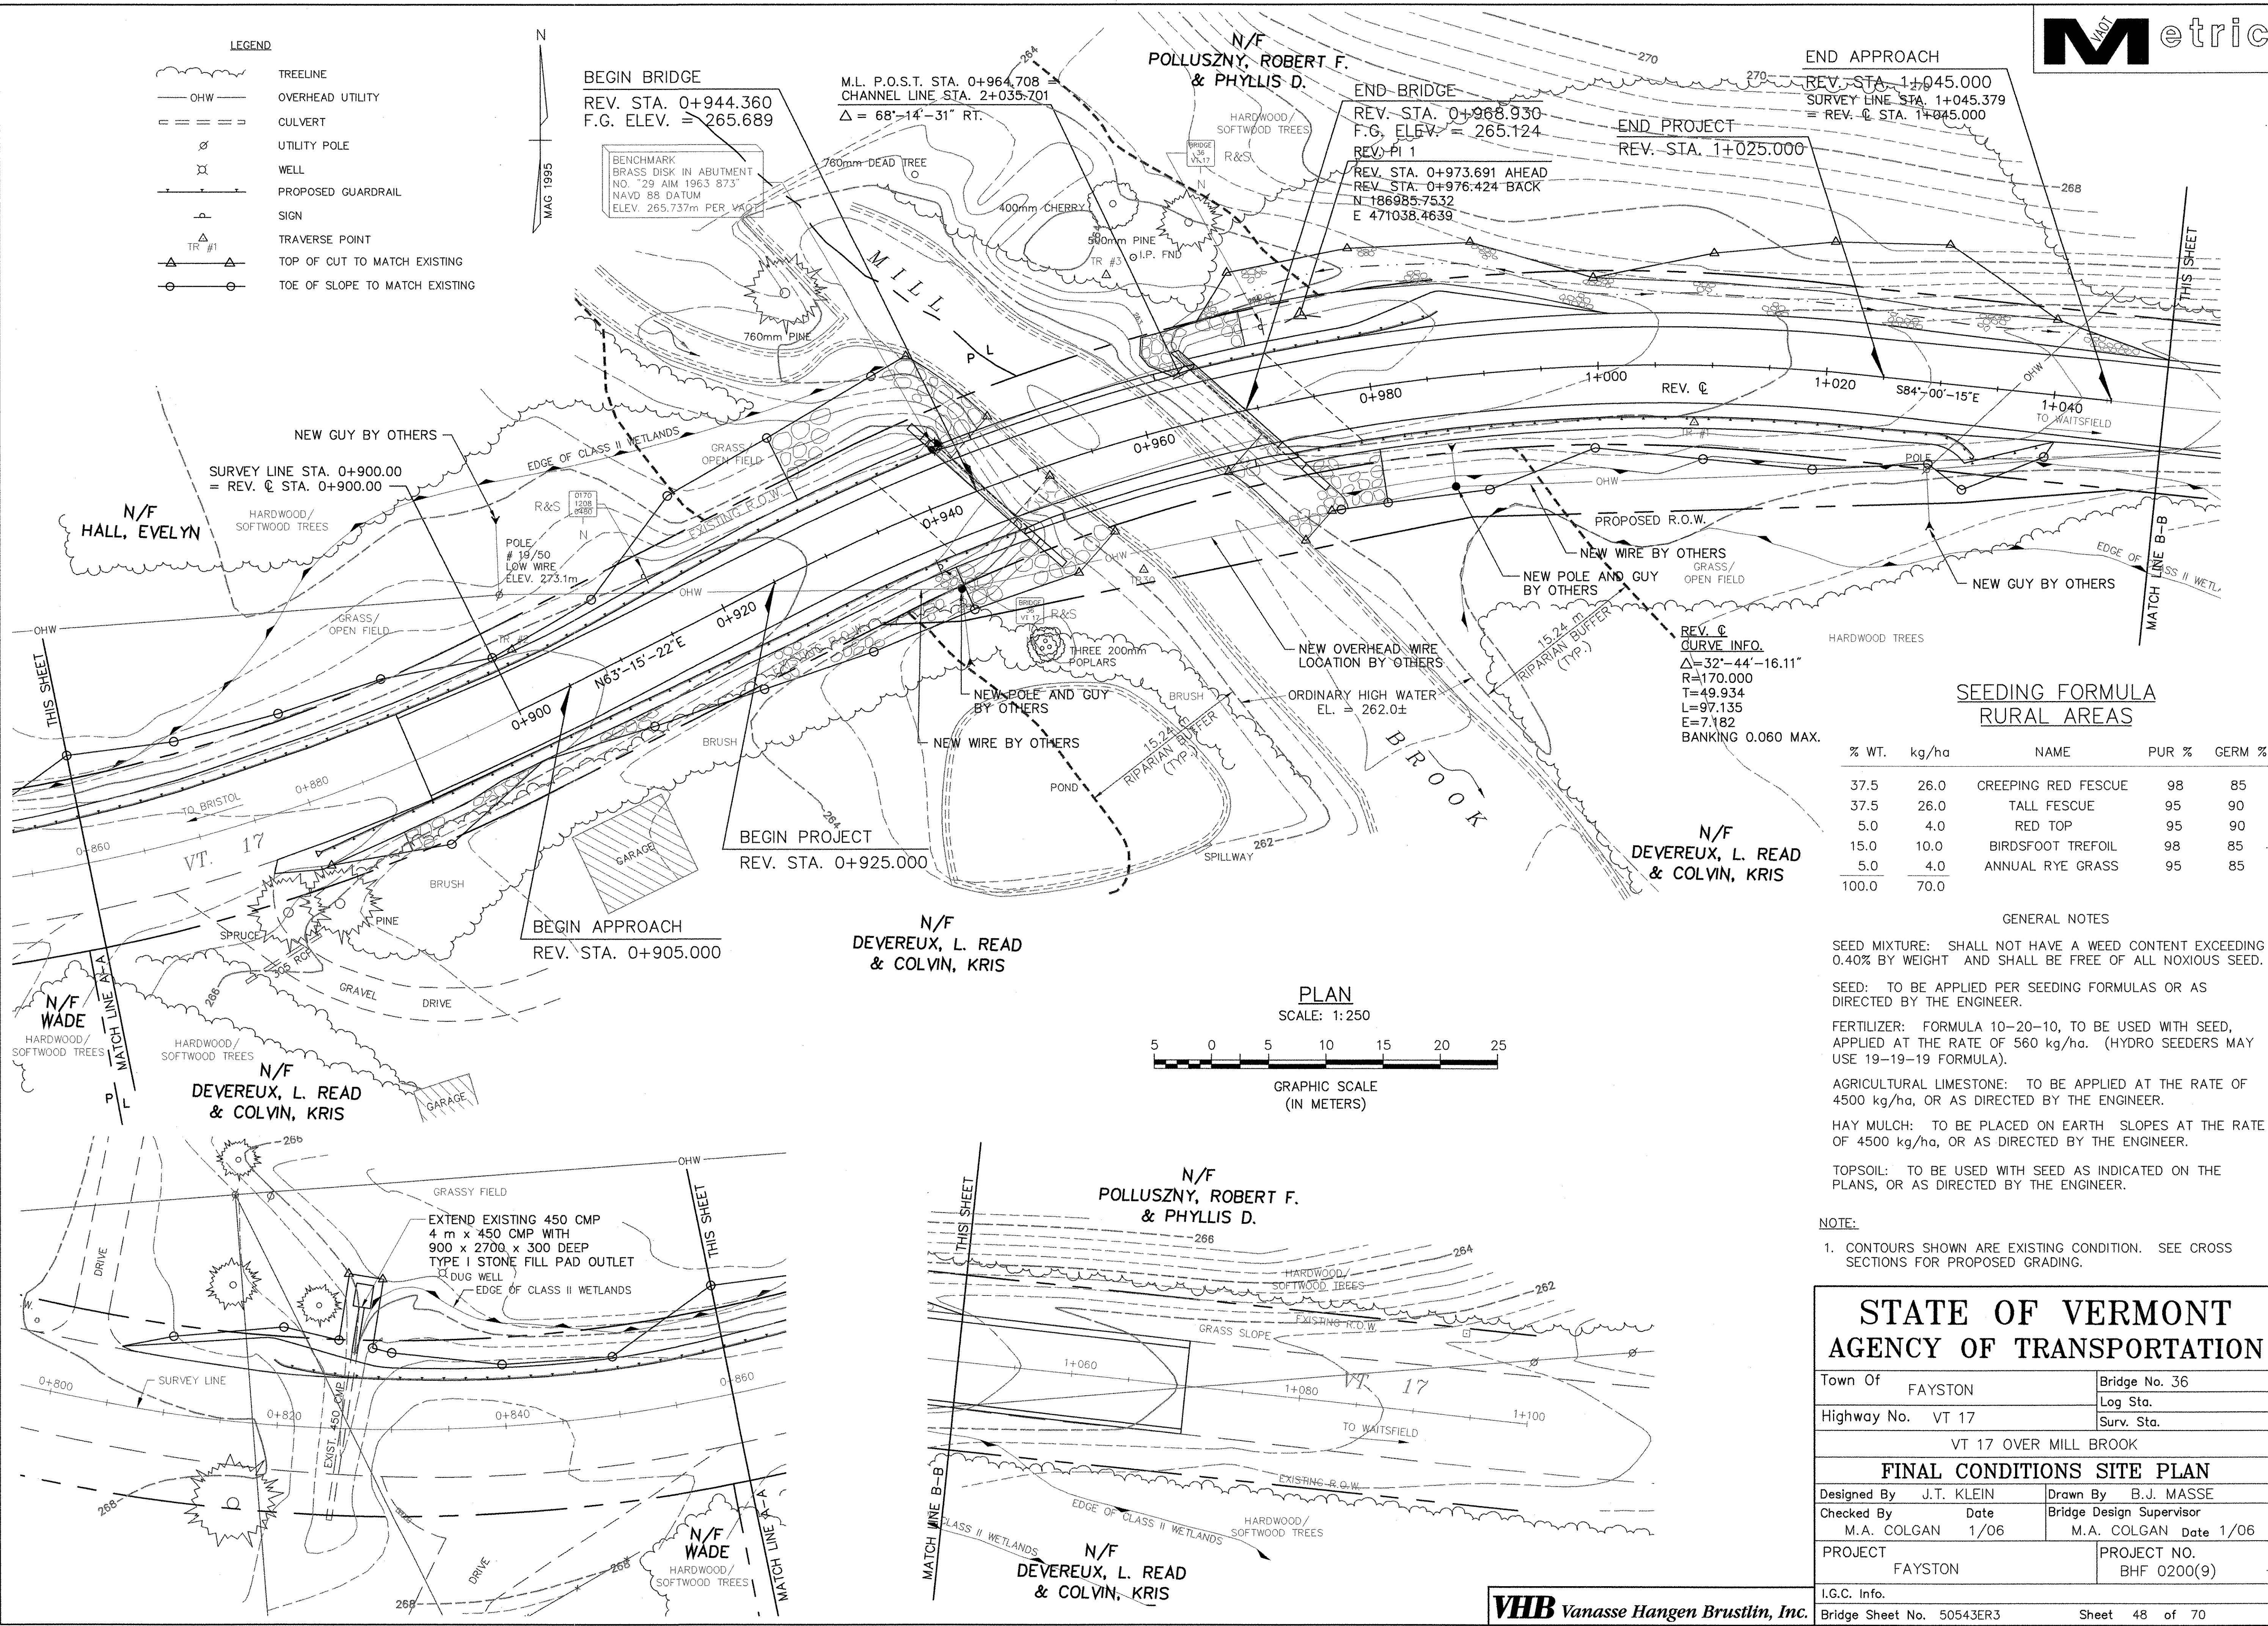

BEGIN BRIDGE
REV. STA. 0+944.360
F.G. ELEV. = 265.689

M.L. P.O.S.T. STA. 0+964.708
CHANNEL LINE STA. 2+035.701
 $\Delta = 68^{\circ}-14'-31''$ RT.

N/F
**POLLUSZNY, ROBERT F.
& PHYLLIS D.**

END BRIDGE
REV. STA. 0+968.930
F.G. ELEV. = 265.124
REV. PI 1
REV. STA. 0+973.691 AHEAD
REV. STA. 0+976.424 BACK
N 186.985-75.32
E 471038.4639

END APPROACH
REV. STA. 1+045.000
SURVEY LINE STA. 1+045.379
= REV. STA. 1+045.000

END PROJECT
REV. STA. 1+025.000

SURVEY LINE STA. 0+900.00
= REV. STA. 0+900.00

N/F
HALL, EVELYN

BEGIN APPROACH
REV. STA. 0+905.000

BEGIN PROJECT
REV. STA. 0+925.000

N/F
**DEVEREUX, L. READ
& COLVIN, KRIS**

N/F
**DEVEREUX, L. READ
& COLVIN, KRIS**

N/F
**DEVEREUX, L. READ
& COLVIN, KRIS**

EXTEND EXISTING 450 CMP
4 m x 450 CMP WITH
900 x 2700 x 300 DEEP
TYPE I STONE FILL PAD OUTLET
DUG WELL
EDGE OF CLASS II WETLANDS

N/F
**POLLUSZNY, ROBERT F.
& PHYLLIS D.**

N/F
**DEVEREUX, L. READ
& COLVIN, KRIS**

PLAN

SCALE: 1:250



GRAPHIC SCALE
(IN METERS)

**SEEDING FORMULA
RURAL AREAS**

% WT.	kg/ha	NAME	PUR %	GERM %
37.5	26.0	CREeping RED FESCUE	98	85
37.5	26.0	TALL FESCUE	95	90
5.0	4.0	RED TOP	95	90
15.0	10.0	BIRDSFOOT TREFOIL	98	85
5.0	4.0	ANNUAL RYE GRASS	95	85
100.0	70.0			

GENERAL NOTES

- SEED MIXTURE: SHALL NOT HAVE A WEED CONTENT EXCEEDING 0.40% BY WEIGHT AND SHALL BE FREE OF ALL NOXIOUS SEED.
- SEED: TO BE APPLIED PER SEEDING FORMULAS OR AS DIRECTED BY THE ENGINEER.
- FERTILIZER: FORMULA 10-20-10, TO BE USED WITH SEED, APPLIED AT THE RATE OF 560 kg/ha. (HYDRO SEEDERS MAY USE 19-19-19 FORMULA).
- AGRICULTURAL LIMESTONE: TO BE APPLIED AT THE RATE OF 4500 kg/ha, OR AS DIRECTED BY THE ENGINEER.
- HAY MULCH: TO BE PLACED ON EARTH SLOPES AT THE RATE OF 4500 kg/ha, OR AS DIRECTED BY THE ENGINEER.
- TOPSOIL: TO BE USED WITH SEED AS INDICATED ON THE PLANS, OR AS DIRECTED BY THE ENGINEER.

NOTE:

- 1. CONTOURS SHOWN ARE EXISTING CONDITION. SEE CROSS SECTIONS FOR PROPOSED GRADING.

**STATE OF VERMONT
AGENCY OF TRANSPORTATION**

Town Of	FAYSTON	Bridge No.	36
Highway No.	VT 17	Log Sta.	
		Surv. Sta.	
VT 17 OVER MILL BROOK			
FINAL CONDITIONS SITE PLAN			
Designed By	J.T. KLEIN	Drawn By	B.J. MASSE
Checked By	M.A. COLGAN	Date	1/06
		Bridge Design Supervisor	M.A. COLGAN Date 1/06
PROJECT	FAYSTON	PROJECT NO.	BHF 0200(9)
I.G.C. Info.	Bridge Sheet No. 50543ER3	Sheet	48 of 70