

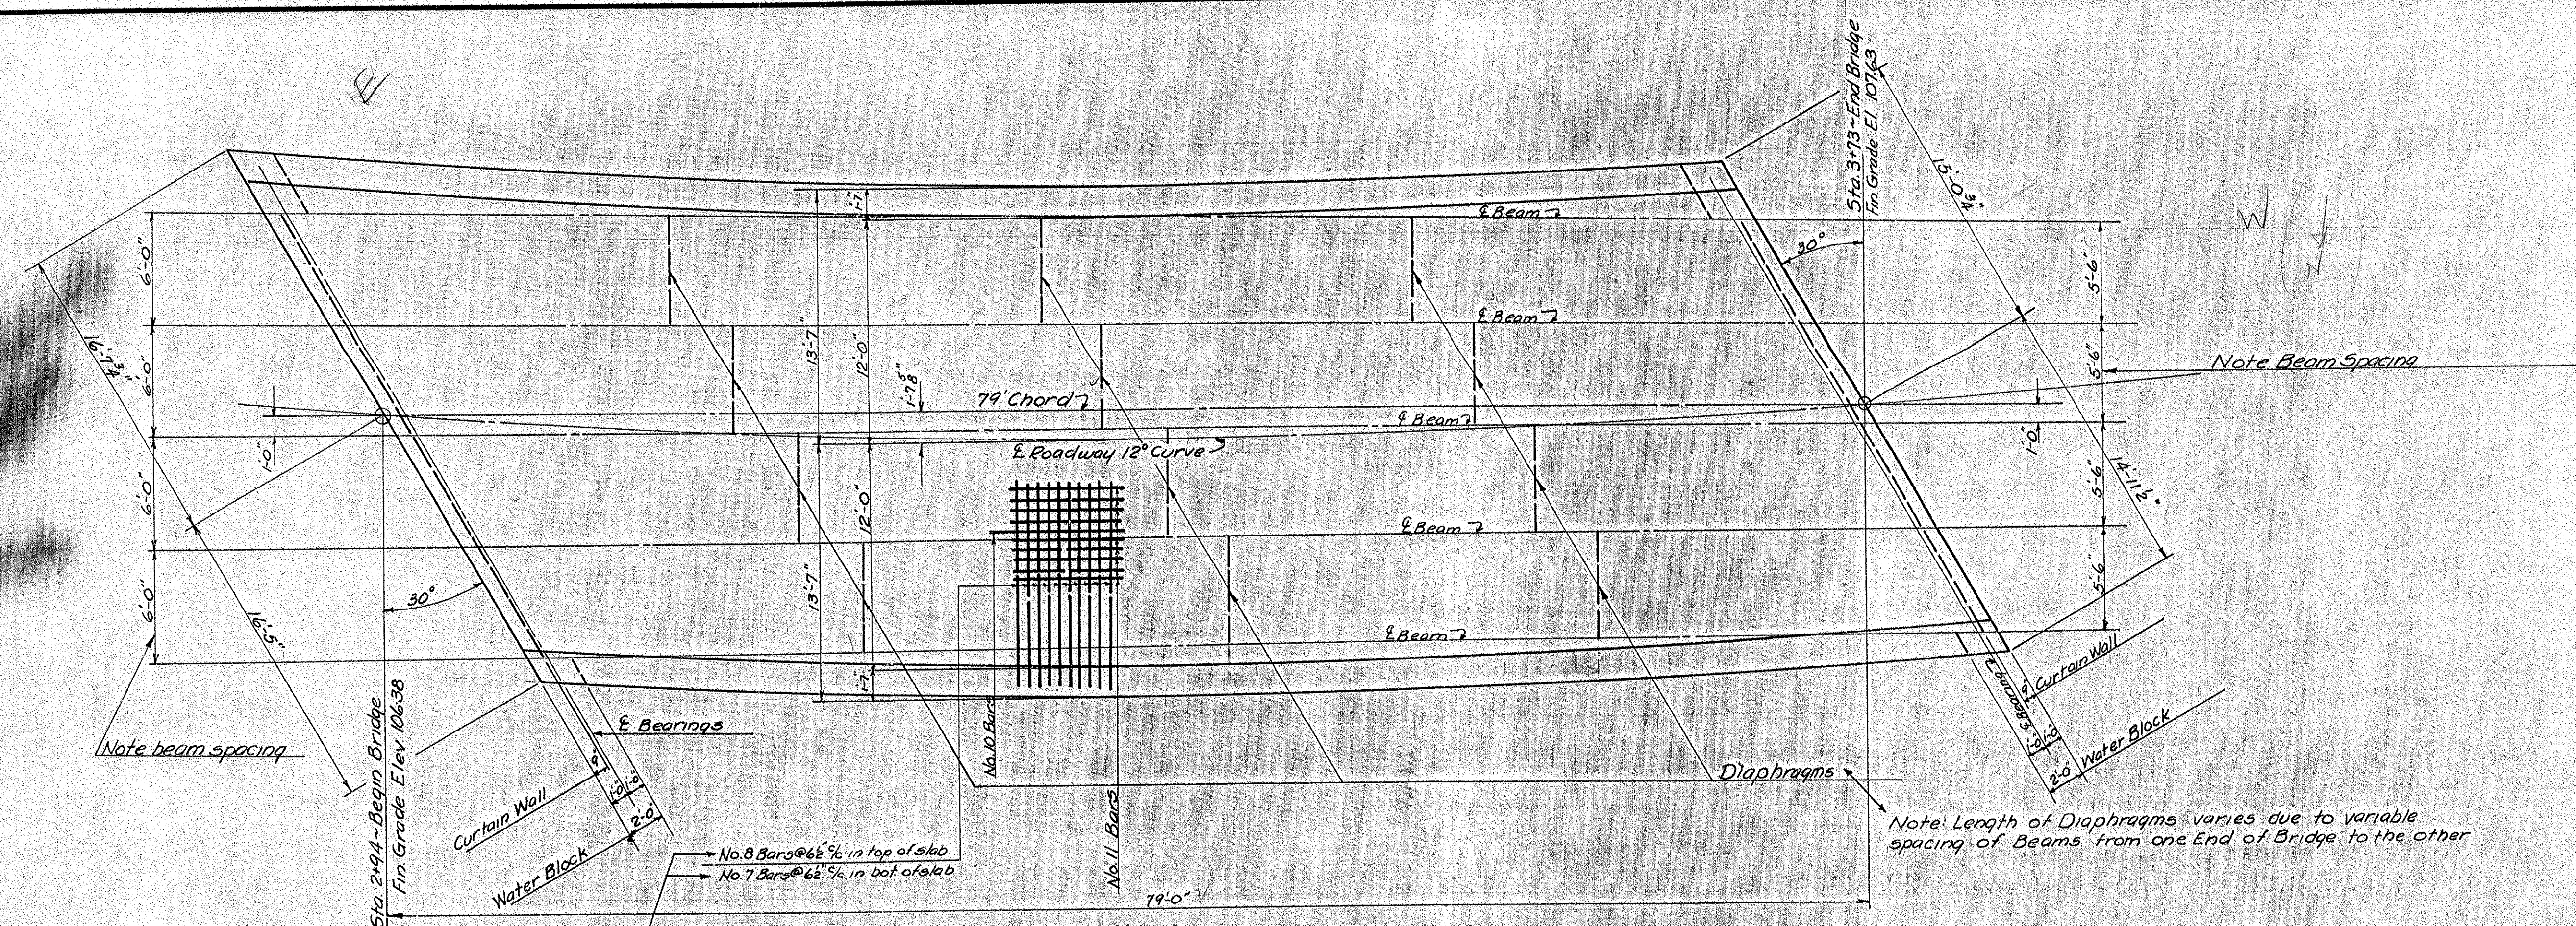


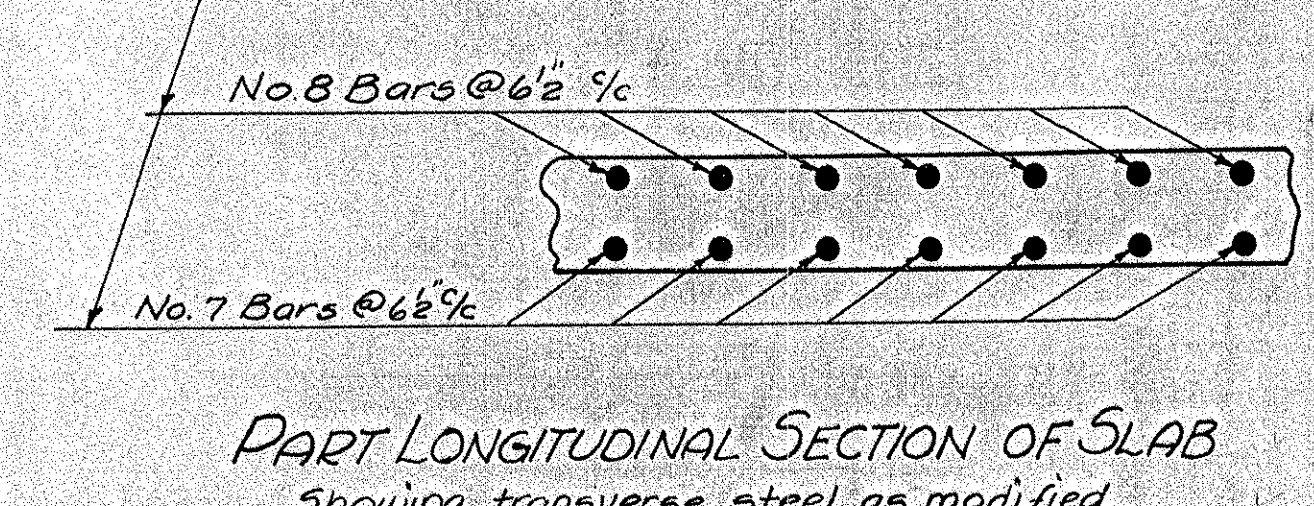

PLAN

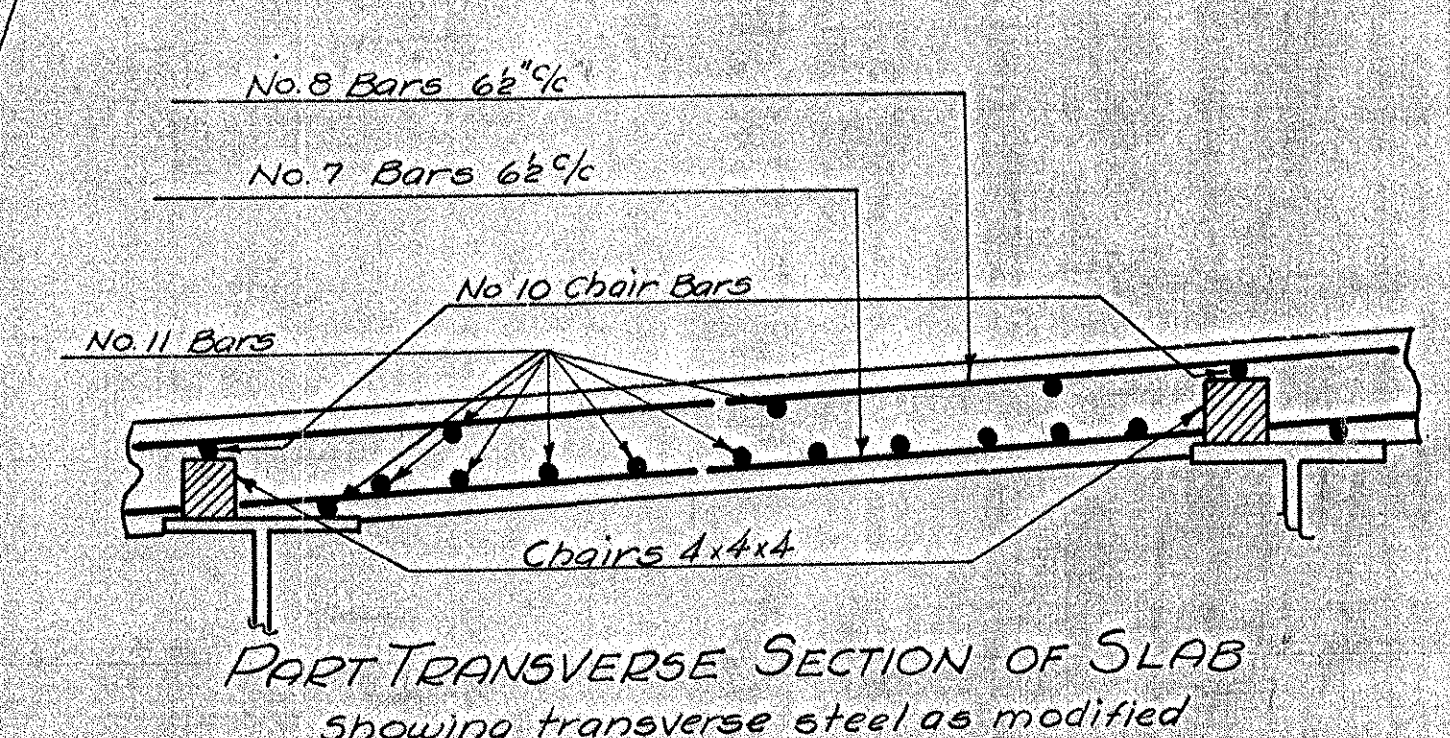

NOTE: This sheet to be used with Standard Sheet 51B 24. All details and notes on this sheet which differ from those shown on 51B 24 will be used in place of those shown on 51B 24.

MODIFIED DETAILS AND NOTES FOR USE
WITH STANDARD SHEET 51B 24
BRIDGE No. 89
FAYSTON

ESTIMATED QUANTITIES

--	--

Surveyed by	
Designed by	
Drawn by	H.G.H.
Traced by	H.W.S.
Checked by	D.R.B.
Series	AWA. No. 1092-39
Filed	
Sheet	6 of 17 Sheets