


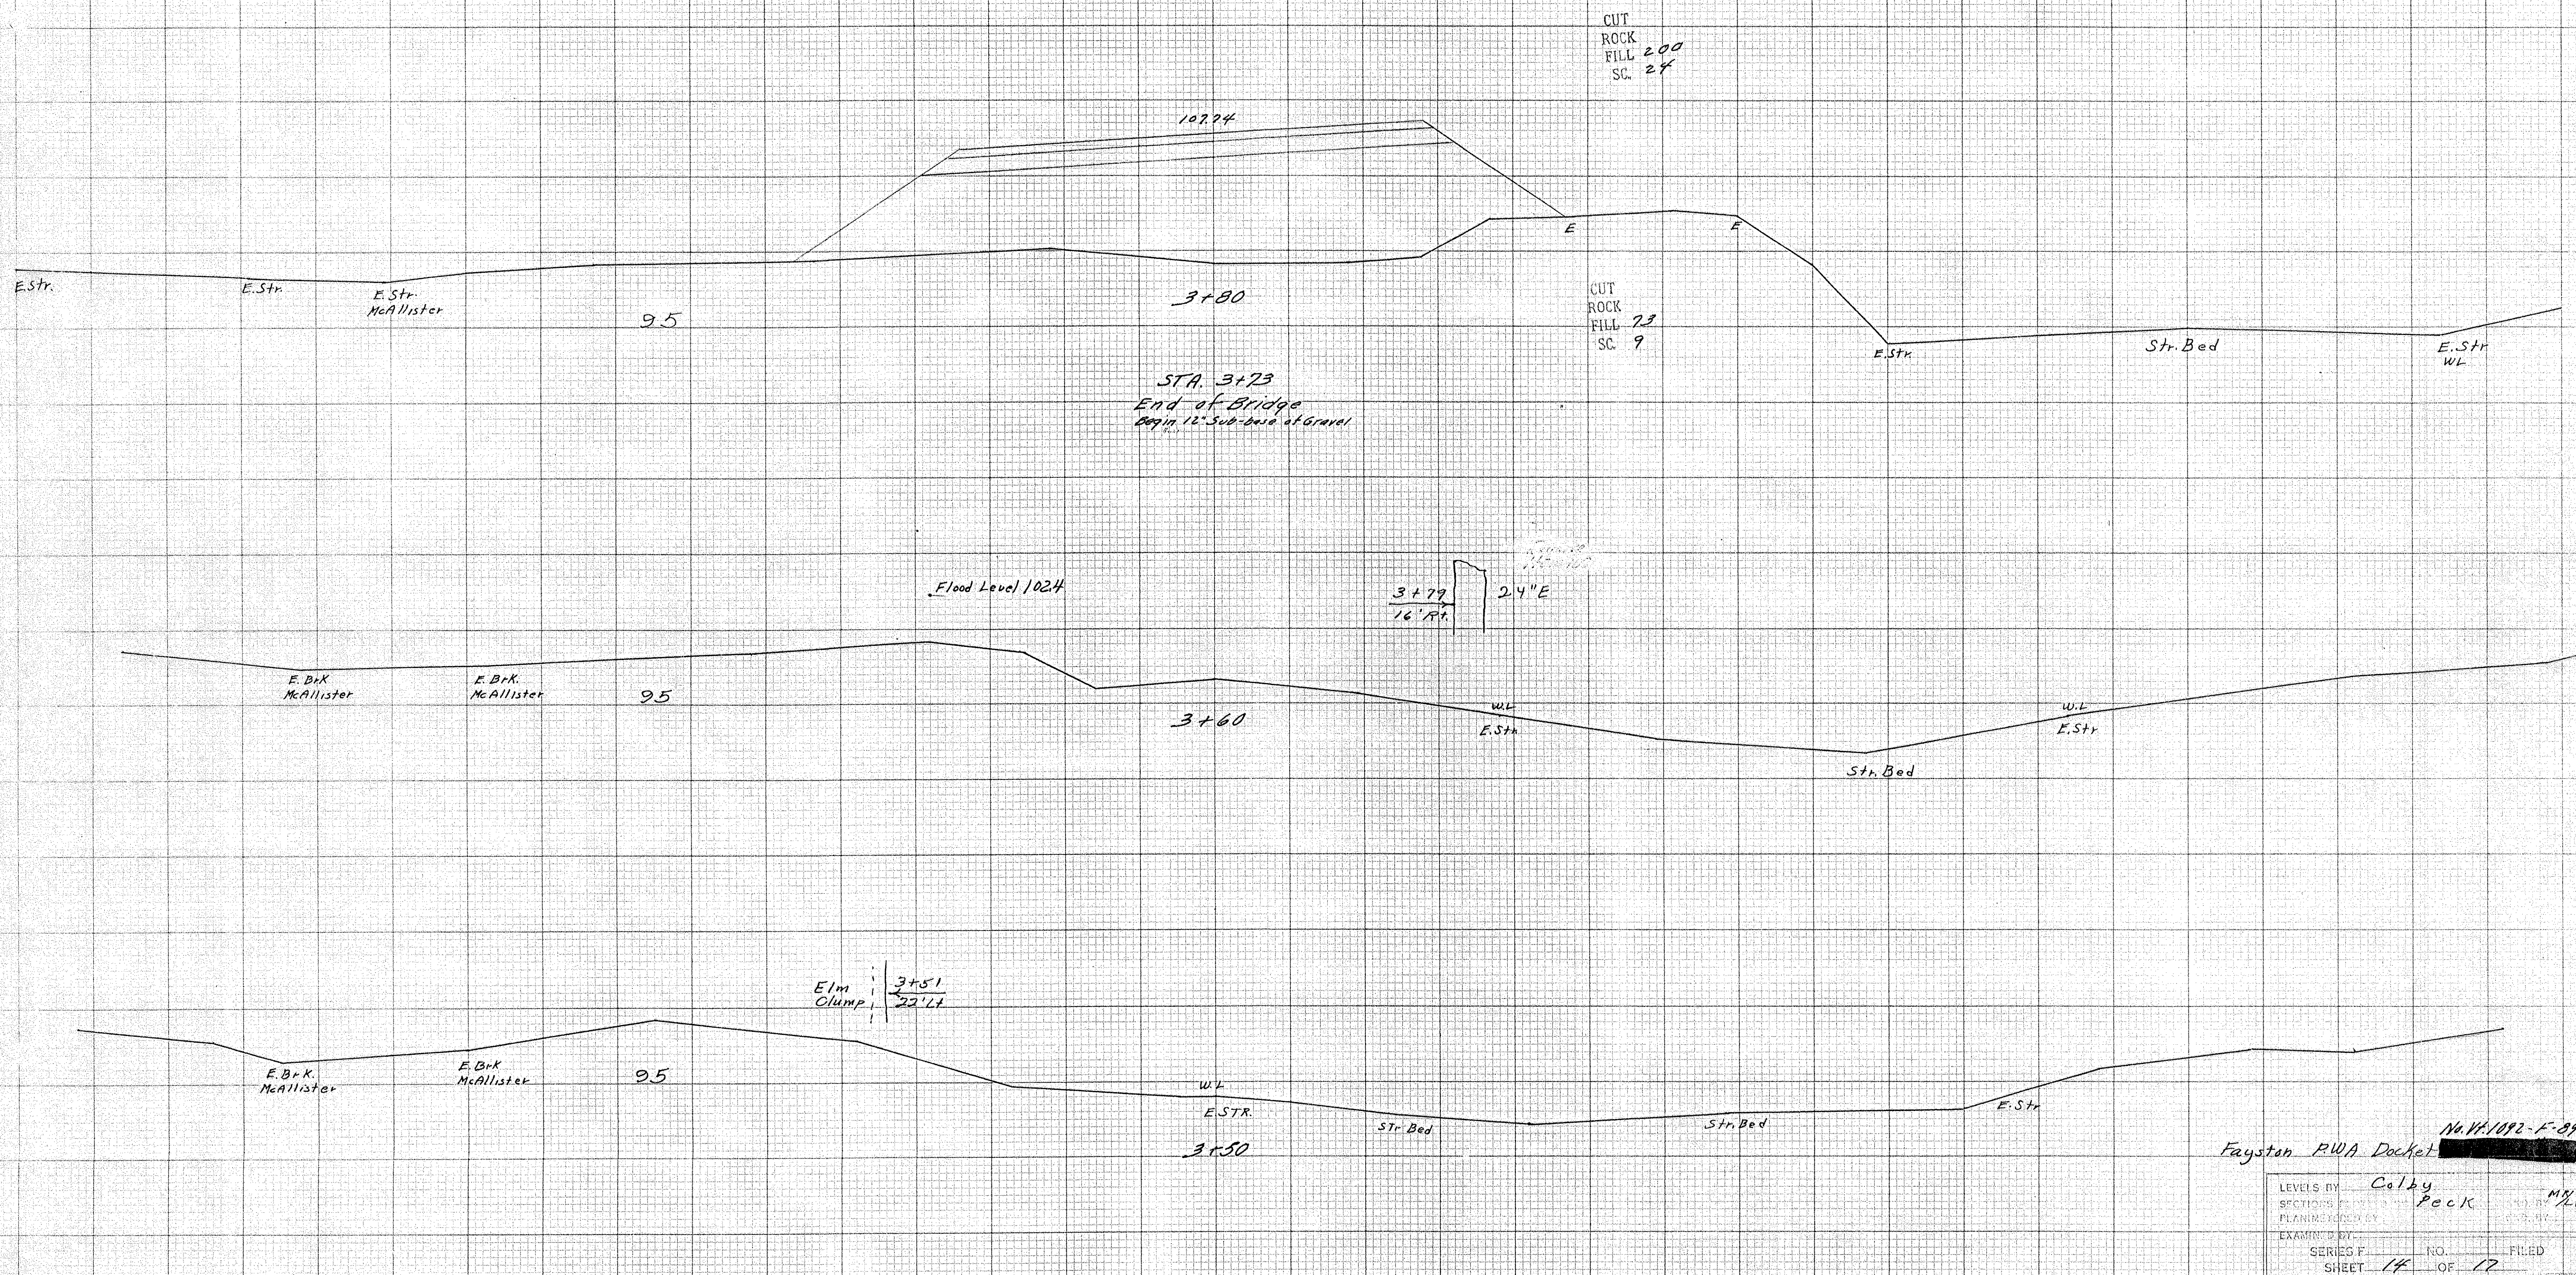

100% STANDARD MARK
RES. 10.000 G.P.
CROSS SECTION 10 X 10
100% BARE PAPER
MADE IN U.S.A.

KEUFFEL & ESSER CO.
NEW YORK

£

100% STANDARD MARK
RES. 10.000 G.P.
CROSS SECTION 10 X 10
100% BARE PAPER
MADE IN U.S.A.

KEUFFEL & ESSER CO.
NEW YORK

Fayston RWA Docket No. 1092-F-89

LEVELS BY	Colby	
SECTIONS BY	Peck	M/P
PLANNING BY		
EXAMINED BY		
SERIES F	NO.	FILED
SHEET 14	OF 17	