


FED. ROAD DIST. NO.		STATE	~~ROAD~~ DIST.	FISCAL YEAR	SHEET NO.	TOTAL SHEET
9		VI.	1092	1939	17	17

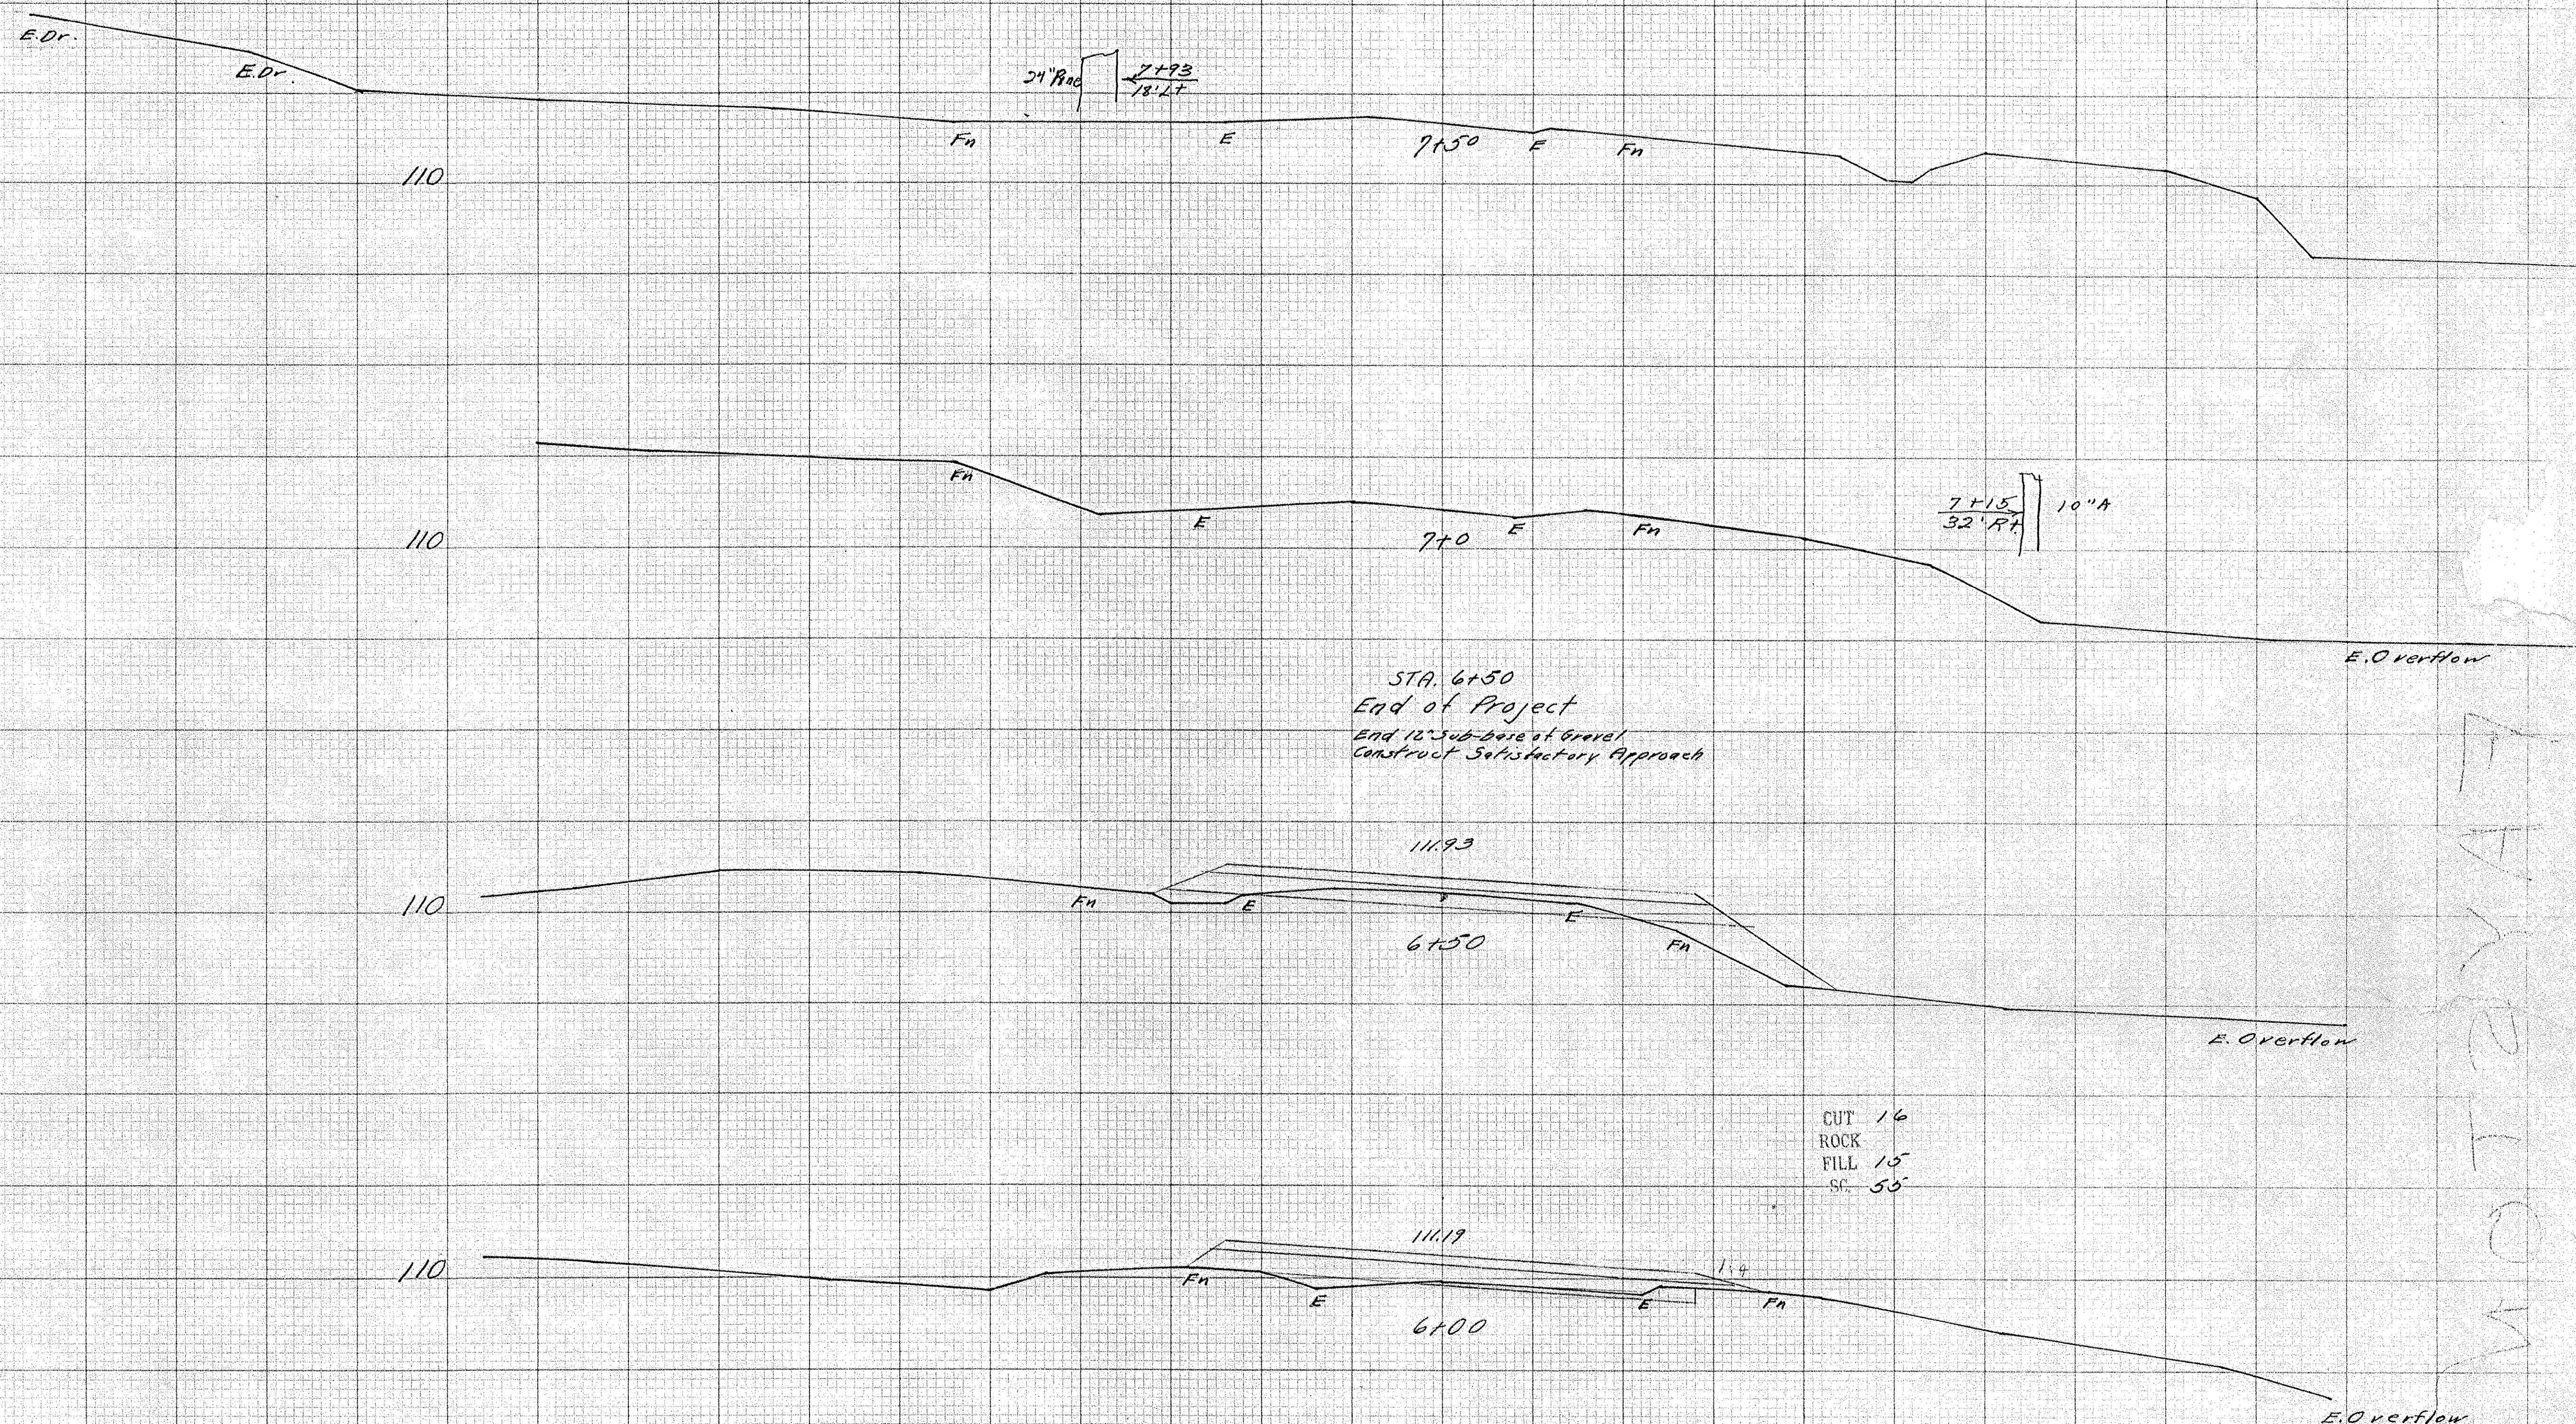

No. 11. 1092-F-67
 Fayston PWA Docket [REDACTED]
 LEVELS BY *Colby*
 STATIONS PLANNED *Rock*
 PLANS, TACKLED *ME*
 EXAMINED BY _____
 SERIES F _____ NO. _____ FILED _____
 SHEET *11* OF *13*