




CONN. PLATE MK. z1a

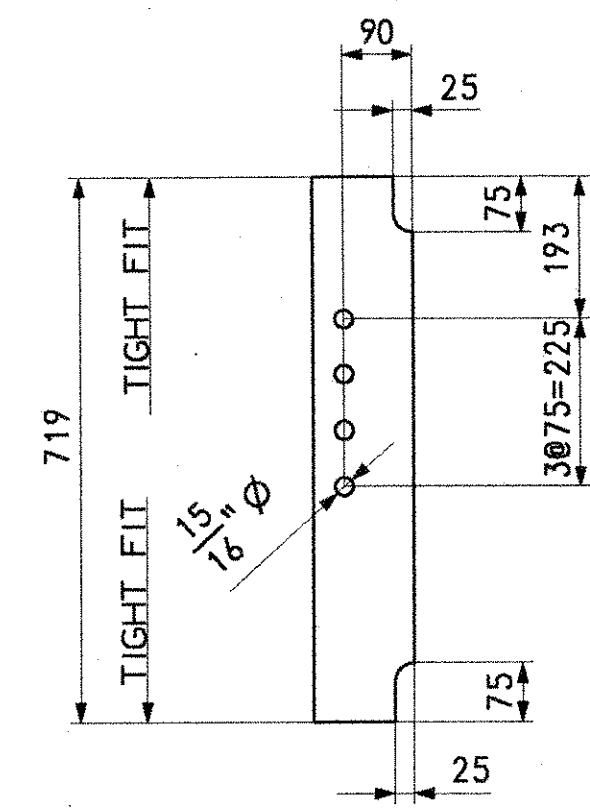

CONN. PLATE MK. z1b

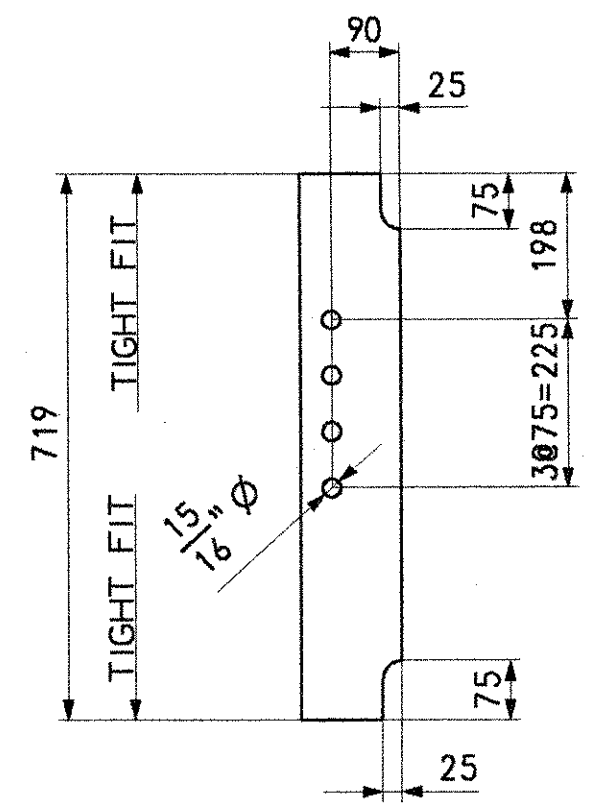

CONN. PLATE MK. z1c

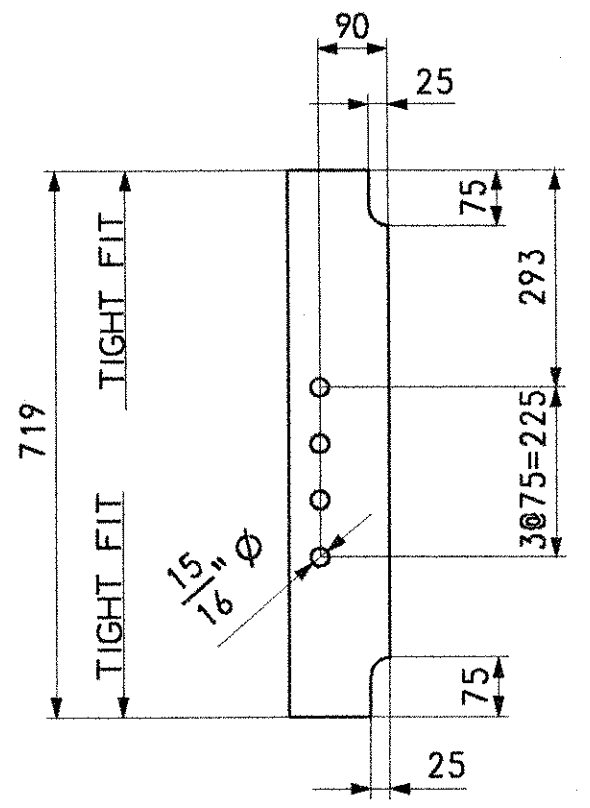

CONN. PLATE MK. z1d

BILL OF MATERIAL

SHIP.	QTY. EA.	MARK	COMM.	DESCRIPTION	LENGTH	SPEC	GRADE	TEST	REMARKS	GRP.	ITEM	SHIP WEIGHT EA. (KG)
1	3	z1a	PL	15.9 x 130	719	M270M	345W			8	1	11.67
2	2	z1a	PL	15.9 x 130	719	M270M	345W			8	1	11.67
1	6	z1b	PL	15.9 x 130	719	M270M	345W			8	1	11.67
2	4	z1b	PL	15.9 x 130	719	M270M	345W			8	1	11.67
1	3	z1c	PL	15.9 x 130	719	M270M	345W			8	1	11.67
2	2	z1c	PL	15.9 x 130	719	M270M	345W			8	1	11.67
1	8	z1d	PL	15.9 x 130	719	M270M	345W			8	1	11.67
2	12	z1d	PL	15.9 x 130	719	M270M	345W			8	1	11.67

RECEIVED
 OK'D BY: VHS OK'D BY: _____
 AUG 21 2006
 RESUBMIT _____ APPROVED As Shld
 BY: WJ DATE: 9/6/06

SHOP DRAWING REVIEW

REVIEWED AS REQUIRED BY THE CONSTRUCTION CONTRACT DOCUMENTS AND APPROVED, BUT ONLY FOR CONFORMANCE TO THE DESIGN CONCEPT OF THE WORK, AND SUBJECT TO FURTHER LIMITATIONS AND REQUIREMENTS CONTAINED IN THE CONSTRUCTION CONTRACT DOCUMENTS.

REJECTED REVISE AND RESUBMIT FURNISH AS CORRECTED

CORRECTIONS OR COMMENTS MADE ON THE SHOP DRAWINGS DURING THIS REVIEW DO NOT RELIEVE CONTRACTOR FROM COMPLIANCE WITH REQUIREMENTS OF THE DRAWINGS AND SPECIFICATIONS. THIS CHECK IS ONLY FOR REVIEW OF GENERAL CONFORMANCE WITH THE DESIGN CONCEPT OF THE PROJECT AND GENERAL COMPLIANCE WITH THE INFORMATION GIVEN IN THE CONTRACT DOCUMENTS. THE CONTRACTOR IS RESPONSIBLE FOR COORDINATING AND CORRELATING ALL QUANTITIES AND DIMENSIONS, SELECTING FABRICATION PROCESSES AND TECHNIQUES OF CONSTRUCTION, COORDINATING HIS WORK WITH THAT OF ALL OTHER TRADES, AND PERFORMING HIS WORK IN A SAFE AND SATISFACTORY MANNER.

VHB Vanasse Hangen Brustlin, Inc.
 Engineers, Planners, and Scientists
 Six Bedford Farms, Nelson Rd.
 Bedford, NH 03110 603 644 0888

Job Number: 50543
 Reviewed By: L.S. GARDNER
 Date: 9/6/06

NOTES:
 HOLES: 15/16" Ø
 BOLTS: NONE
 PAINT: NONE
 FOR GENERAL SHOP NOTES, SEE DWG. GN1.

CODE: 50

NO.	REVISION	BY	DATE

1730 Hempstead Road
 Lancaster, PA 17605-0038
 Phone 717/299-5211

HIGH STEEL STRUCTURES, INC.

STRINGER JOB STANDARDS
 VT 17 OVER-MILL BROOK
 VT 17 STA. 0+944.700 TO STA. 0+968.560
 TOWN OF FALSTON, WASHINGTON COUNTY, VT
 STATE OF VERMONT
 AGENCY OF TRANSPORTATION

STATE CONTRACT BRIDGE NO. 36
 OR REF. NO. _____

CONTRACTOR: **WINTERSET, INC.**

IN CHARGE: **CHRISTMAN (JH)** MADE BY: **ERS** CHK'D BY: **MGK** DATE: **8-7-06**

CONTRACT NUMBER: **VT-06062-1&2** DRAWING NUMBER: **Z1 OF Z2**

FAYSTON