

TO SOUTHBOUND INTERSTATE 91


FROM INTERSTATE 91 SOUTHBOUND

10 INTERSTATE 91 NORTHBOUND

STATION 1+980.00  
BEGIN APPROACH CONSTRUCTION

VT STATE PLANE GRID

VT HIGHWAY DEPT. DISK  
#1BM ELEV. 87.194 M  
SET ON CONCRETE BOX  
CULVERT BEHIND G.R.

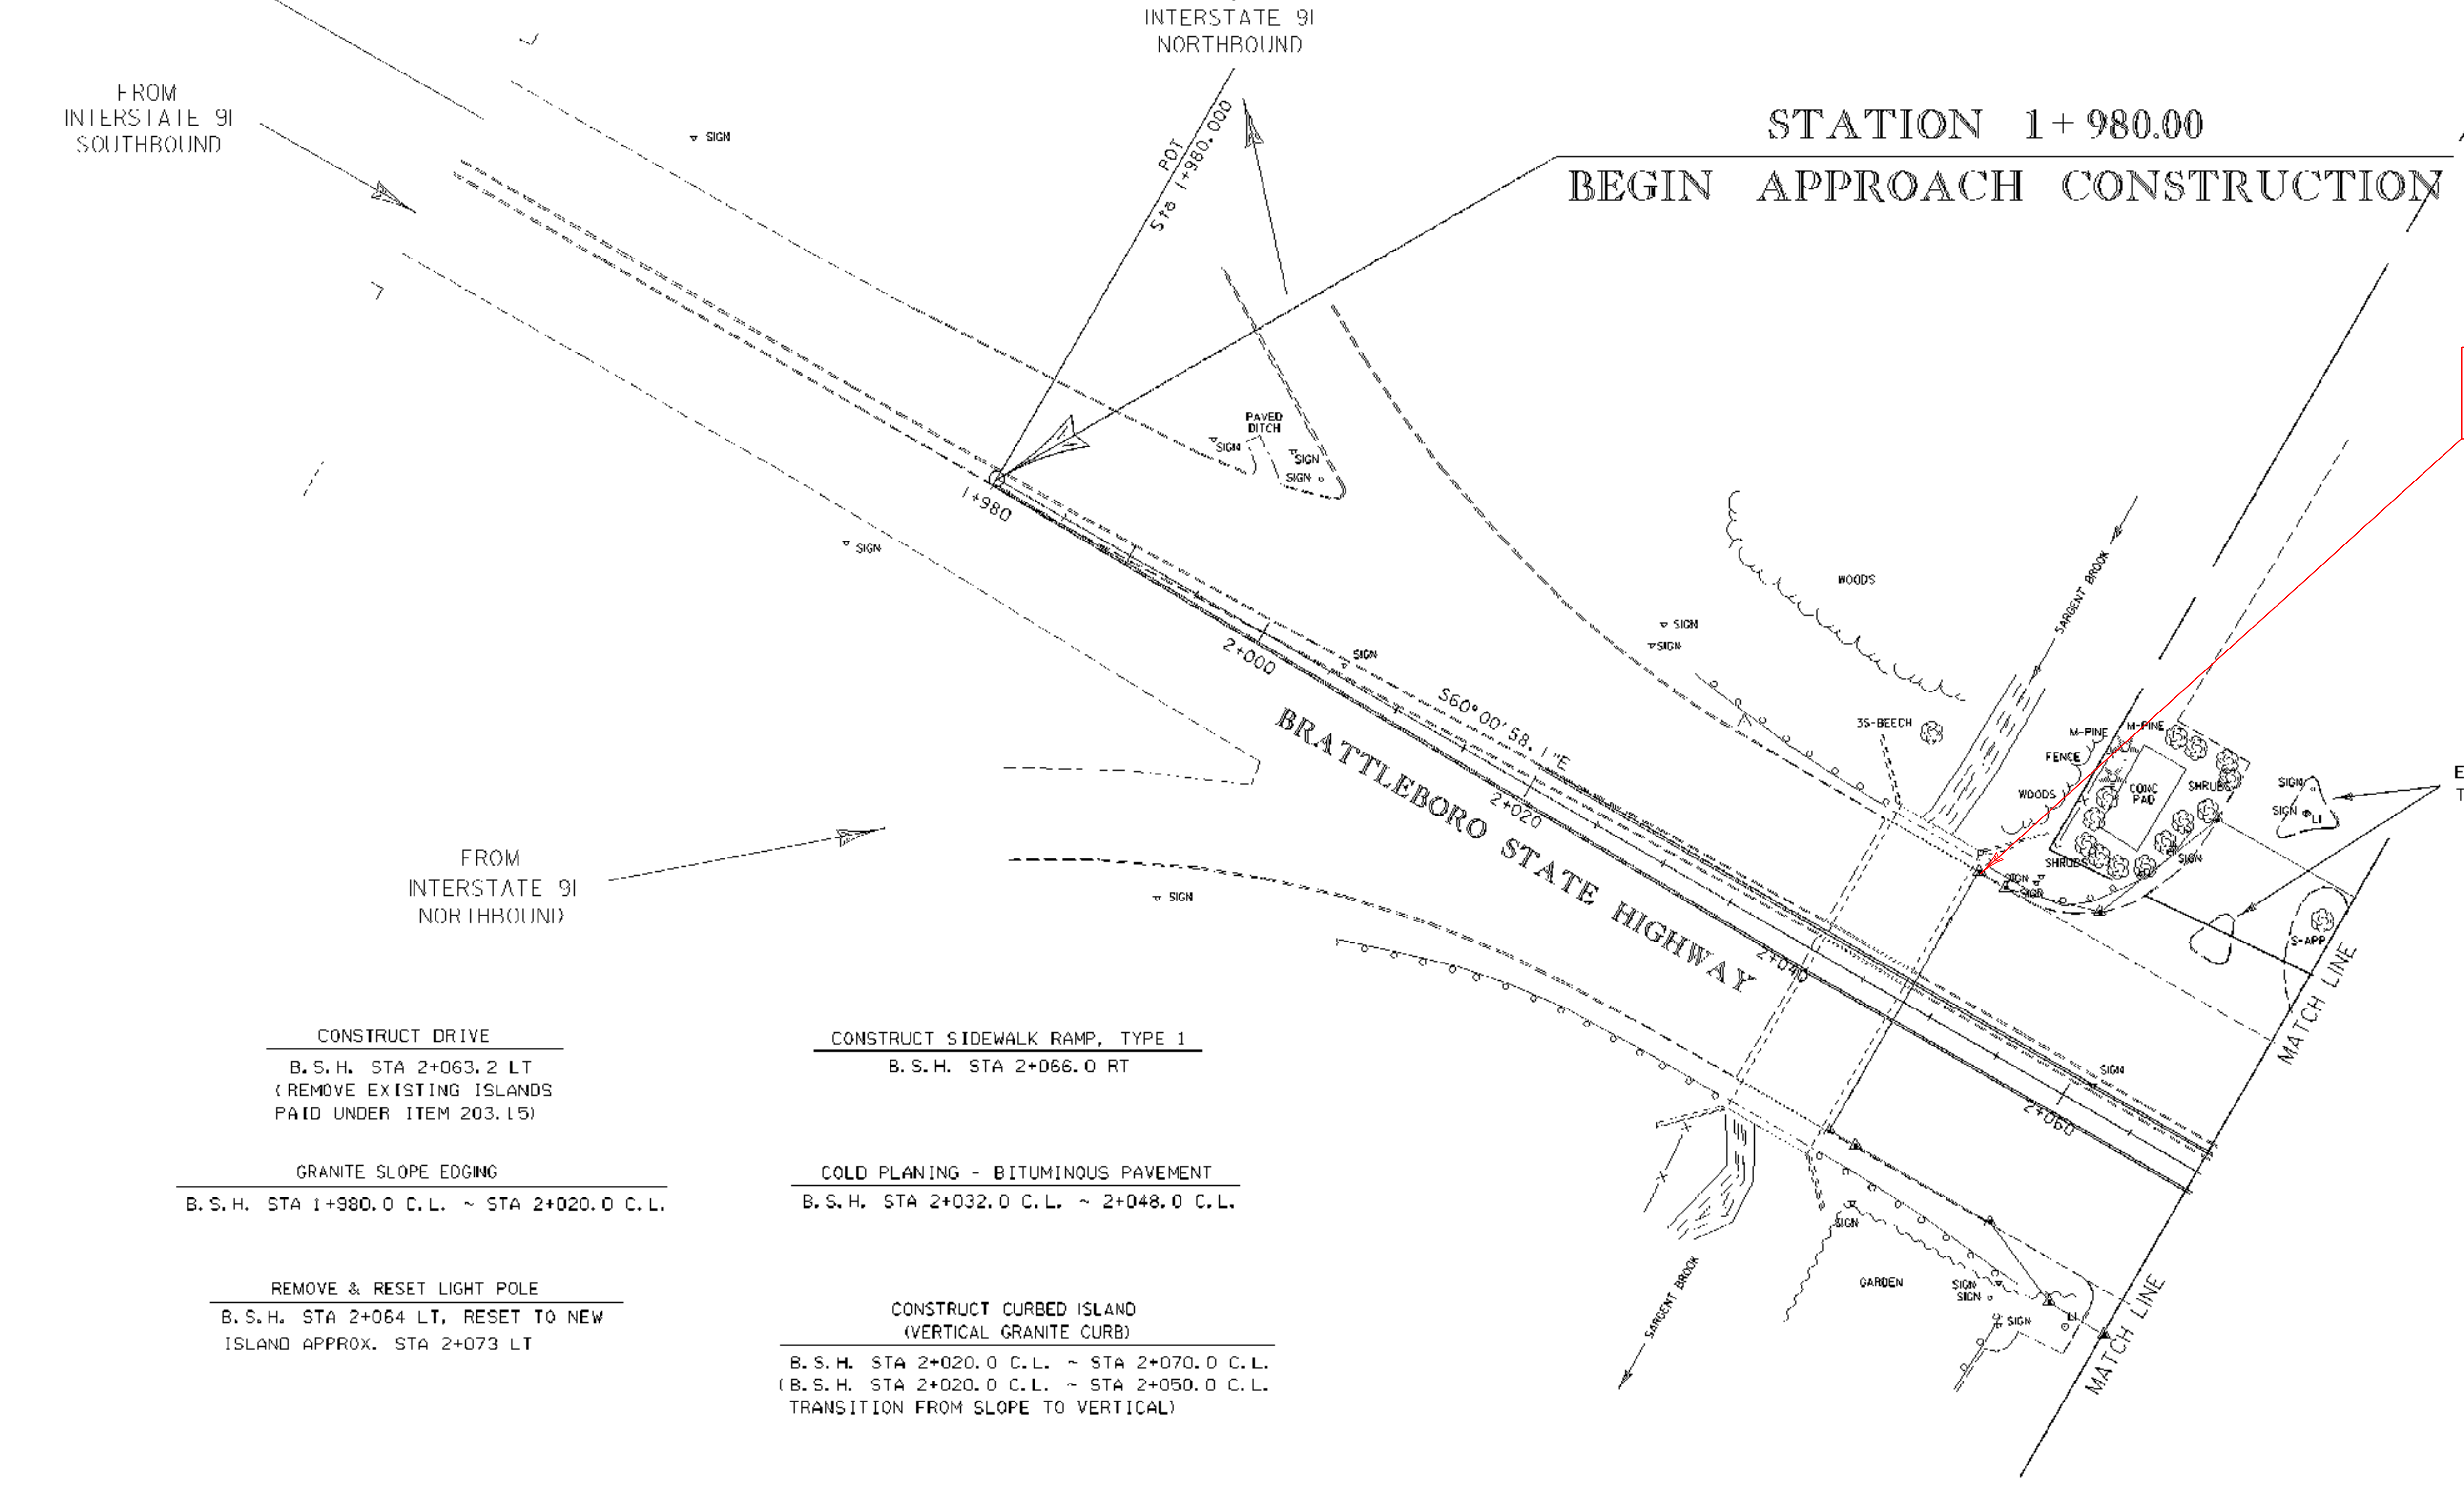

FROM INTERSTATE 91 NORTHBOUND

CONSTRUCT DRIVE  
B. S. H. STA 2+063.2 LT  
(REMOVE EXISTING ISLANDS PAID UNDER ITEM 203.15)

GRANITE SLOPE EDGING  
B. S. H. STA 1+980.0 C.L. ~ STA 2+020.0 C.L.

REMOVE & RESET LIGHT POLE  
B. S. H. STA 2+064 LT, RESET TO NEW ISLAND APPROX. STA 2+073 LT


CONSTRUCT SIDEWALK RAMP, TYPE 1  
B. S. H. STA 2+066.0 RT

COLD PLANING - BITUMINOUS PAVEMENT  
B. S. H. STA 2+032.0 C.L. ~ 2+048.0 C.L.

CONSTRUCT CURBED ISLAND (VERTICAL GRANITE CURB)  
B. S. H. STA 2+020.0 C.L. ~ STA 2+070.0 C.L.  
(B. S. H. STA 2+020.0 C.L. ~ STA 2+050.0 C.L. TRANSITION FROM SLOPE TO VERTICAL)

EXISTING ISLANDS TO BE REMOVED

ROADWAY LAYOUT

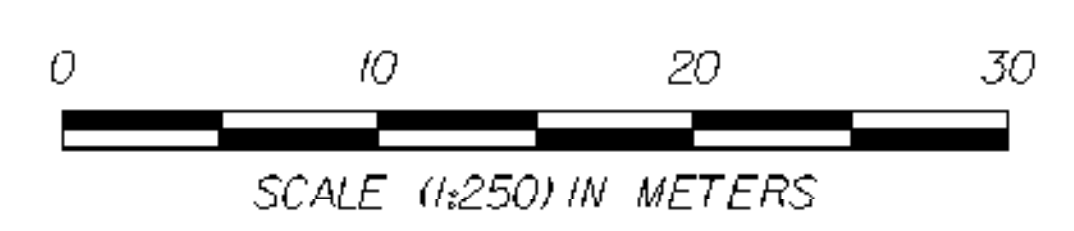

PROJECT:	<b>BRATTLEBORO</b>	PROJECT NO.:	<b>NII 2000(18)</b>
DESIGN FILE NAME:	/sqdc/93d/91/dd/91bdr.dgn	PLOT DATE:	8-APR-1999
IPARM FILE NAME:	03/SIL4.i	SURVEY DATE:	10-95
SURVEYED BY:	R. GILMAN	DRAWN BY:	K. UPNAL
SQUAD LEADER:	S. MENARO	SHEET:	24 OF 67