

STATION 2 + 275.300
 END APPROACH CONSTRUCTION

VT STATE PLANE GRID


COLD PLANING - BITUMINOUS PAVEMENT
 2+225.00 C.L. ~ 2+240.00 C.L.

REMOVAL OF EXISTING CURB
 VT 9 2+233.3 C.L. ~ 2+246.2 C.L.

REMOVING AND RESETTING CURB
 VT 9 2+246.2 C.L. ~ 2+275.3 C.L.

CONSTRUCT CURBED ISLAND
 VT 9 STA. 2+210.0 C ~ STA. 2+222.0 C
 VT 9 STA. 2+210.0 RT ~ STA. 2+226.8 RT
 VT 9 STA. 2+210.0 LT ~ STA. 2+225.8 LT

NOTE: ALL EXISTING SEWER AND WATER
 LINE LOCATIONS ARE APPROXIMATE.

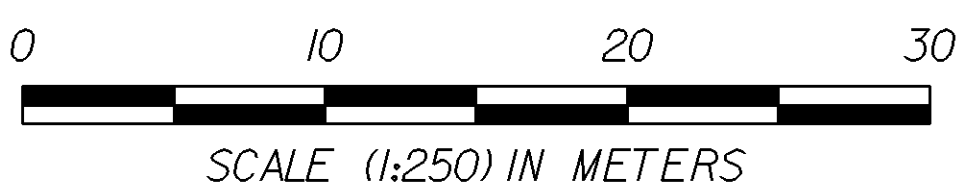

EAST TO
 CHESTERFIELD
 NEW HAMPSHIRE

ROADWAY LAYOUT
Metric

PROJECT:	BRATTLEBORO	PROJECT NO.:	NH 2000(18)
DESIGN FILE NAME:	/sqdc/93d191/dd191bdr.dgn	PLOT DATE:	8-APR-1999
IPARM FILE NAME:	dd191l5.i	SURVEY DATE:	10-95
SURVEYED BY:	R. GILMAN	DRAWN BY:	K. UPMAL
SQUAD LEADER:	S. MENARD	SHEET:	25 OF 67