


Profile

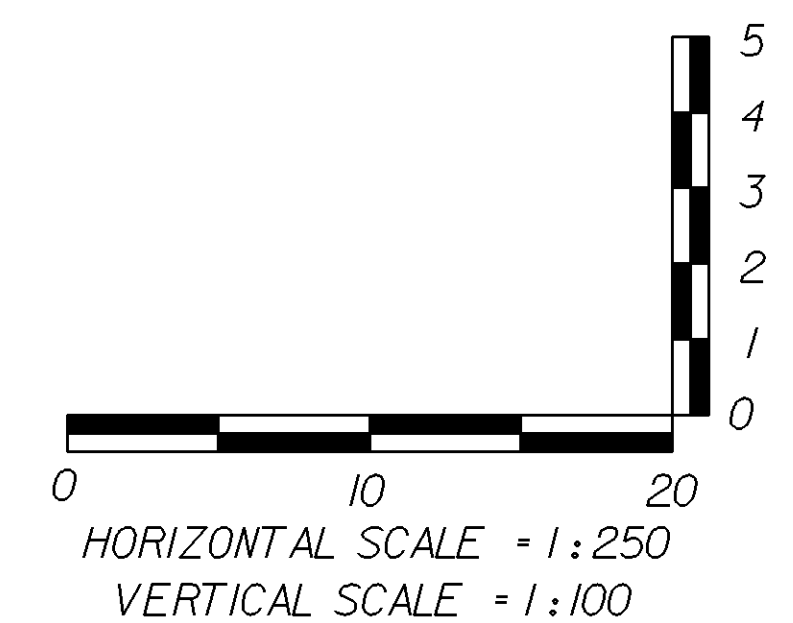

VT. ROUTE 9 -
BRATTLEBORO STATE HIGHWAY

DATUM	
VERTICAL	NAVD88
HORIZONTAL	NAD83(92)

PROJECT:	BRATTLEBORO	PROJECT NO.:	NH 2000(18)
DESIGN FILE NAME:	sqdc/93d191/dd191xsl.dgn	PLOT DATE:	8-APR-1999
IPARM FILE NAME:	dd191p21	SURVEY DATE:	10/95
SURVEYED BY:	R. GILMAN	DRAWN BY:	K. UPMAL
SQUAD LEADER:	S. MENARD	SHEET:	27 OF 57