

- EXISTING DRAINAGE**
- ① US 5 1+062.7 RT ~ 1+04.2 LT  
REMOVE EXISTING 450 mm RCP & DI
  - ② US 5 1+102.8 LT ~ 1+104.1 LT  
REMOVE DI & 1.5 m EXISTING 300 mm CGMP  
& CONNECT TO NEW INLET DI FOR PIPE ②
  - ③ US 5 1+104.7 LT ~ 1+117.4 LT  
REMOVE EXISTING 450 mm RCP & DI
  - ④ US 5 1+118.0 LT ~ 1+123.4 LT  
REMOVE EXISTING 450 mm RCP & DI
  - ⑤ US 5 1+124.1 LT ~ 1+140.0 LT  
REMOVE EXISTING 450 mm RCP & DI
  - ⑥ US 5 1+140.0 LT  
REMOVE EXISTING 450 mm RCP & DI
  - ⑦ US 5 1+140.8 LT ~ 1+152.1 LT  
REMOVE EXISTING 450 mm RCP & DI
  - ⑧ US 5 1+152.4 LT ~ 1+153.4 LT  
REMOVE EXISTING 200 mm CSP & DI
  - ⑨ US 5 1+152.6 LT ~ 1+181.8 LT  
REMOVE EXISTING 450 mm RCP & DI
  - ⑭ VT 9 2+146.8 RT ~ 2+155.5 RT  
REMOVE EXISTING 300 mm RCP & DI
  - ⑮ VT 9 2+156.0 RT ~ 2+161.3 RT  
REMOVE EXISTING 375 mm RCP & DI
  - ⑯ VT 9 2+161.8 RT ~ 2+163.5 RT  
REMOVE EXISTING 150 mm CSP & DI
  - ⑰ VT 9 2+161.7 RT ~ 2+167.4 RT  
REMOVE EXISTING 375 mm RCP & DI
  - ⑱ VT 9 2+167.7 RT ~ 2+173.4 LT  
REMOVE EXISTING 450 mm RCP & DI
  - ⑲ VT 9 2+162.1 LT ~ 2+173.2 LT  
REMOVE EXISTING 375mm RCP & DI
  - ⑳ VT 9 2+157.0 LT ~ 2+161.4 LT  
REMOVE EXISTING 375 mm RCP & DI
  - ㉑ VT 9 2+147.5 LT ~ 2+156.4 LT  
REMOVE EXISTING 375 mm RCP & DI
  - ㉒ VT 9 2+173.8 LT ~ 2+190.9 LT  
REMOVE EXISTING 450 mm RCP & DI
  - ㉓ VT 9 2+191.6 LT ~ 2+242.5 LT  
RETAIN EXISTING 450 mm RCP & REMOVE DI


HANDICAP ACCESS RAMPS

NEW PRECAST DI W/GRATE STA. 2+163.5 RT

STATION 1  
STATION 2 + 140.000 (BRAT)

\* SEE SHEET 34 FOR NEW WATERLINE LOCATION

LAYOUT--EXISTING DRAINAGE

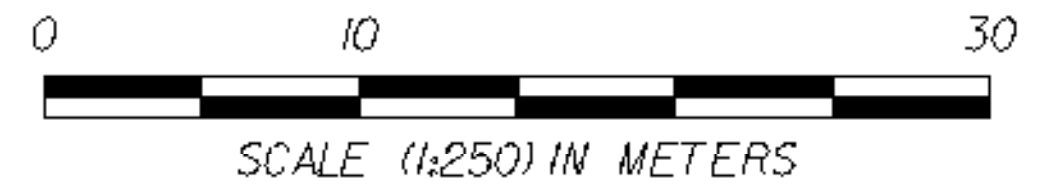

PROJECT:	<b>BRATTLEBORO</b>	PROJECT NO.:	<b>NH 2000(18)</b>
DESIGN FILE NAME:	/sqdc/93d191/dd191bdr.dgn	PLOT DATE:	8-APR-1999
IPARM FILE NAME:	dd191d11	SURVEY DATE:	10-95
SURVEYED BY:	R. GILMAN	DRAWN BY:	K. UPMAL
SQUAD LEADER:	S. MENARD	SHEET:	28 OF 67