


TO
SOUTHBOUND
INTERSTATE 91

FROM
INTERSTATE 91
SOUTHBOUND

TO
INTERSTATE 91
NORTHBOUND


STATION 1+980.00
BEGIN APPROACH CONSTRUCTION

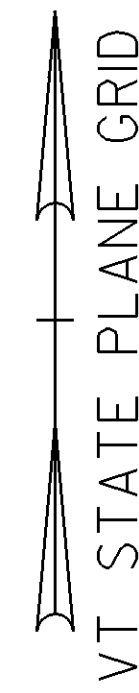

FROM
INTERSTATE 91
NORTHBOUND

EXISTING ISLANDS
TO BE REMOVED

- UNDERDRAIN
- △ B.S.H. 2+055.0 RT ~ US 5 I+090.5 LT
NEW 150 mm X 92 m UNDERDRAIN
W/ F.B. @ 2+055.0 RT
 - △ B.S.H. 2+052.0 LT ~ US 5 I+167.5 LT
NEW 150 mm X 92 m UNDERDRAIN
W/ F.B. @ 2+052.0 LT

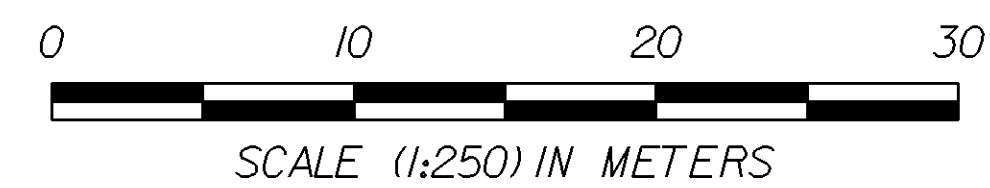

LAYOUT--EXISTING & NEW DRAINAGE



PROJECT:	BRATTLEBORO	PROJECT NO.:	NH 2000(18)
DESIGN FILE NAME:	/sqdc/93d191/dd191bdr.dgn	PLOT DATE:	8-APR-1999
IPARM FILE NAME:	dd191d14.d	SURVEY DATE:	10-95
SURVEYED BY:	R. GILMAN	DRAWN BY:	K. UPMAL
SQUAD LEADER:	S. MENARD	SHEET:	31 OF 67