


VT STATE PLANE GRID

STATION 2 + 275.300 END APPROACH CONSTRUCTION


- 23 VT 9 2+191.6 LT ~ 2+242.5 LT **THIS DI MAY HAVE BEEN LEFT IN PLACE?!**
RETAIN EXISTING 450 mm RCP & REMOVE DI
- 24 VT 9 2+243.0 RT ~ LT
RETAIN EXISTING 375 mm RCP & DI

- UNDERDRAIN
- 6 VT 9 2+183.0 LT ~ 2+225.0 LT
NEW 150 mm X 42 m UNDERDRAIN
W/ F.B. @ 2+183.0 LT
 - 7 VT 9 2+225.0 LT ~ RT
NEW 150 mm X 20 m CARRIER PIPE
 - 8 VT 9 2+183.0 RT ~ 2+243.0 RT
NEW 150 mm X 60 m UNDERDRAIN
W/ F.B. @ 2+183.0 RT

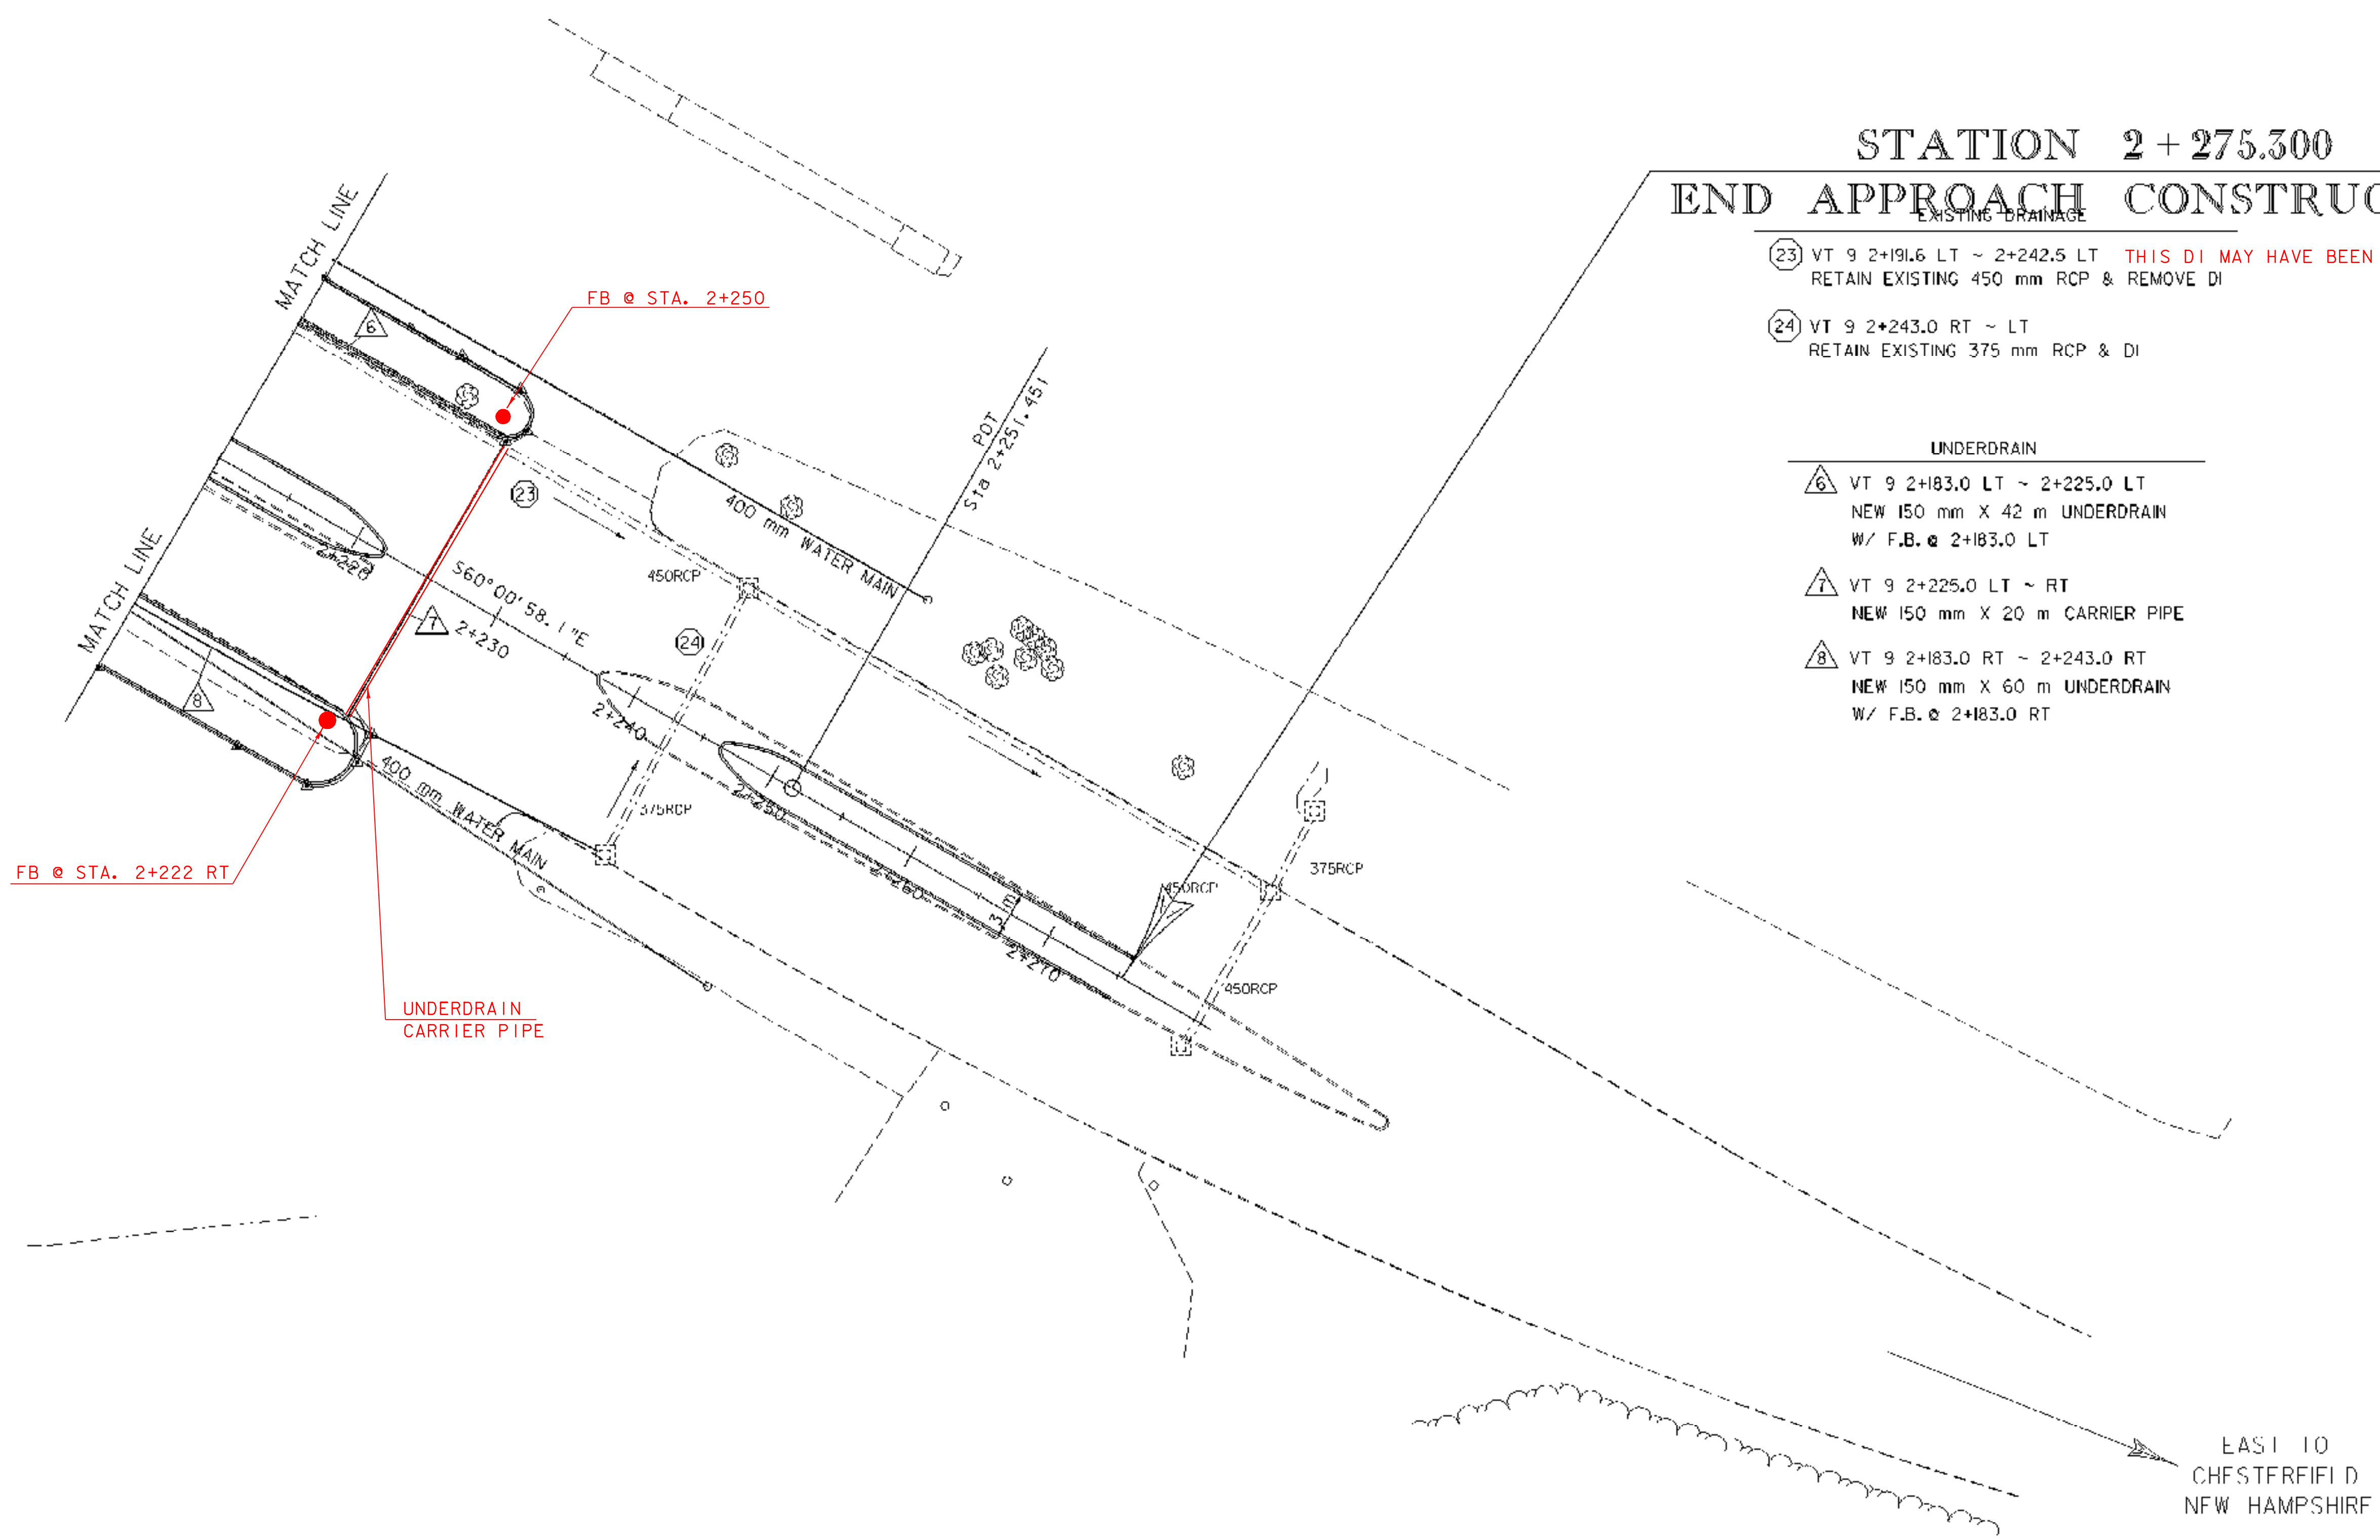

EAST 10
CHESTERFIELD
NEW HAMPSHIRE

LAYOUT--EXISTING & NEW DRAINAGE

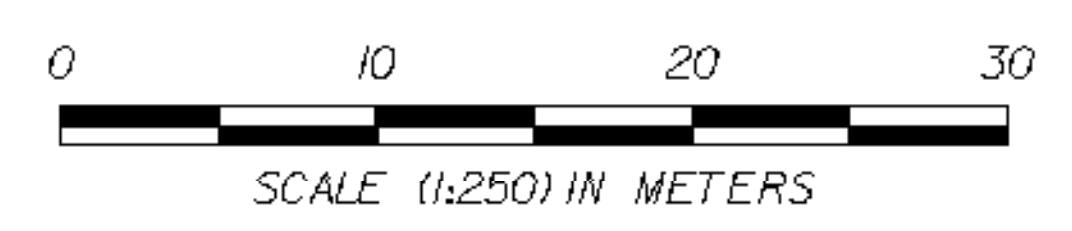

PROJECT:	BRATTLEBORO	PROJECT NO.:	NH 2000(18)
DESIGN FILE NAME:	/sqdc/93dl9l/dl9lbr.dgn		
IPARM FILE NAME:	dd9ld5j	PLOT DATE:	8-APR-1999
SURVEYED BY:	R. GILMAN	SURVEY DATE:	10-95
SQUAD LEADER:	S. MENARD	DRAWN BY:	K. UPMAL
		SHEET:	32 OF 67