


DATUM	_____
VERTICAL	_____
HORIZONTAL	_____

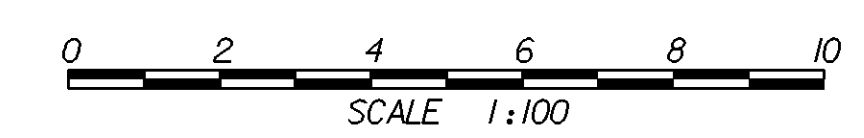

U.S. RTE. 5--NORTH SECTION

PROJECT:	BRATTLEBORO	PROJECT NO.:	NH_2000(18)
DESIGN FILE NAME:	Zsdc\z33d19\zdd19\z33.dwg	PLOT DATE:	8-APR-1999
IPARM FILE NAME:	ddl9lx06.l	SURVEY DATE:	
SURVEYED BY:		DRAWN BY:	SQUAD_C
SQUAD LEADER:	MENARD	SHEET:	57 OF 67