


DATUM	_____
VERTICAL	_____
HORIZONTAL	_____

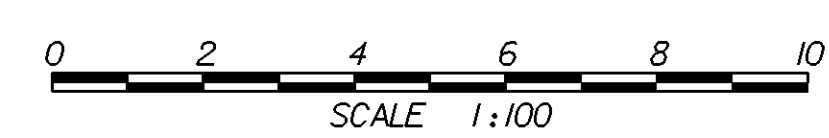

U.S. RTE. 5--NORTH SECTION	
PROJECT: BRATTLEBORO	PROJECT NO.: NH_2000(18)
DESIGN FILE NAME: Zsdc\23d\19\dd19\183.dwg	PLOT DATE: 8-APR-1999
IPARM FILE NAME: dd19\183.dwg	SURVEY DATE:
SURVEYED BY:	DRAWN BY: SQUAD_C
SQUAD LEADER: MENARD	SHEET: 58 OF 67