


DATUM	_____
VERTICAL	_____
HORIZONTAL	_____

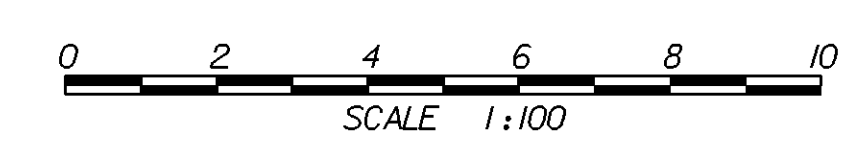

BRATTLEBORO ST. HWY.	
PROJECT: BRATTLEBORO	PROJECT NO.: NH 2000(18)
DESIGN FILE NAME: /sdc/93d19/ddd19/s3.dgn	PLOT DATE: 8-APR-1999
IPARM FILE NAME: ddi91x9a.l	SURVEY DATE:
SURVEYED BY:	DRAWN BY: SQUAD_C
SQUAD LEADER: MENARD	SHEET: 58A OF 67