


DATUM
 VERTICAL _____
 HORIZONTAL _____

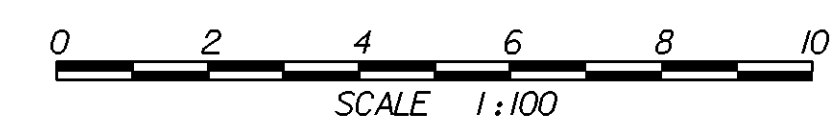

BRATTLEBORO ST. HWY.	
PROJECT: BRATTLEBORO	PROJECT NO.: NH_2000(18)
DESIGN FILE NAME: sdc\293d191\dd191x33.dgn	PLOT DATE: 8-APR-1999
IPARM FILE NAME: dd191x09.i	SURVEY DATE:
SQUAD LEADER: MENARD	DRAWN BY: SQUAD_C
	SHEET: 60 OF 67