


CROSS SECTION--CIRCULAR ROADWAY AND CENTRAL ISLAND

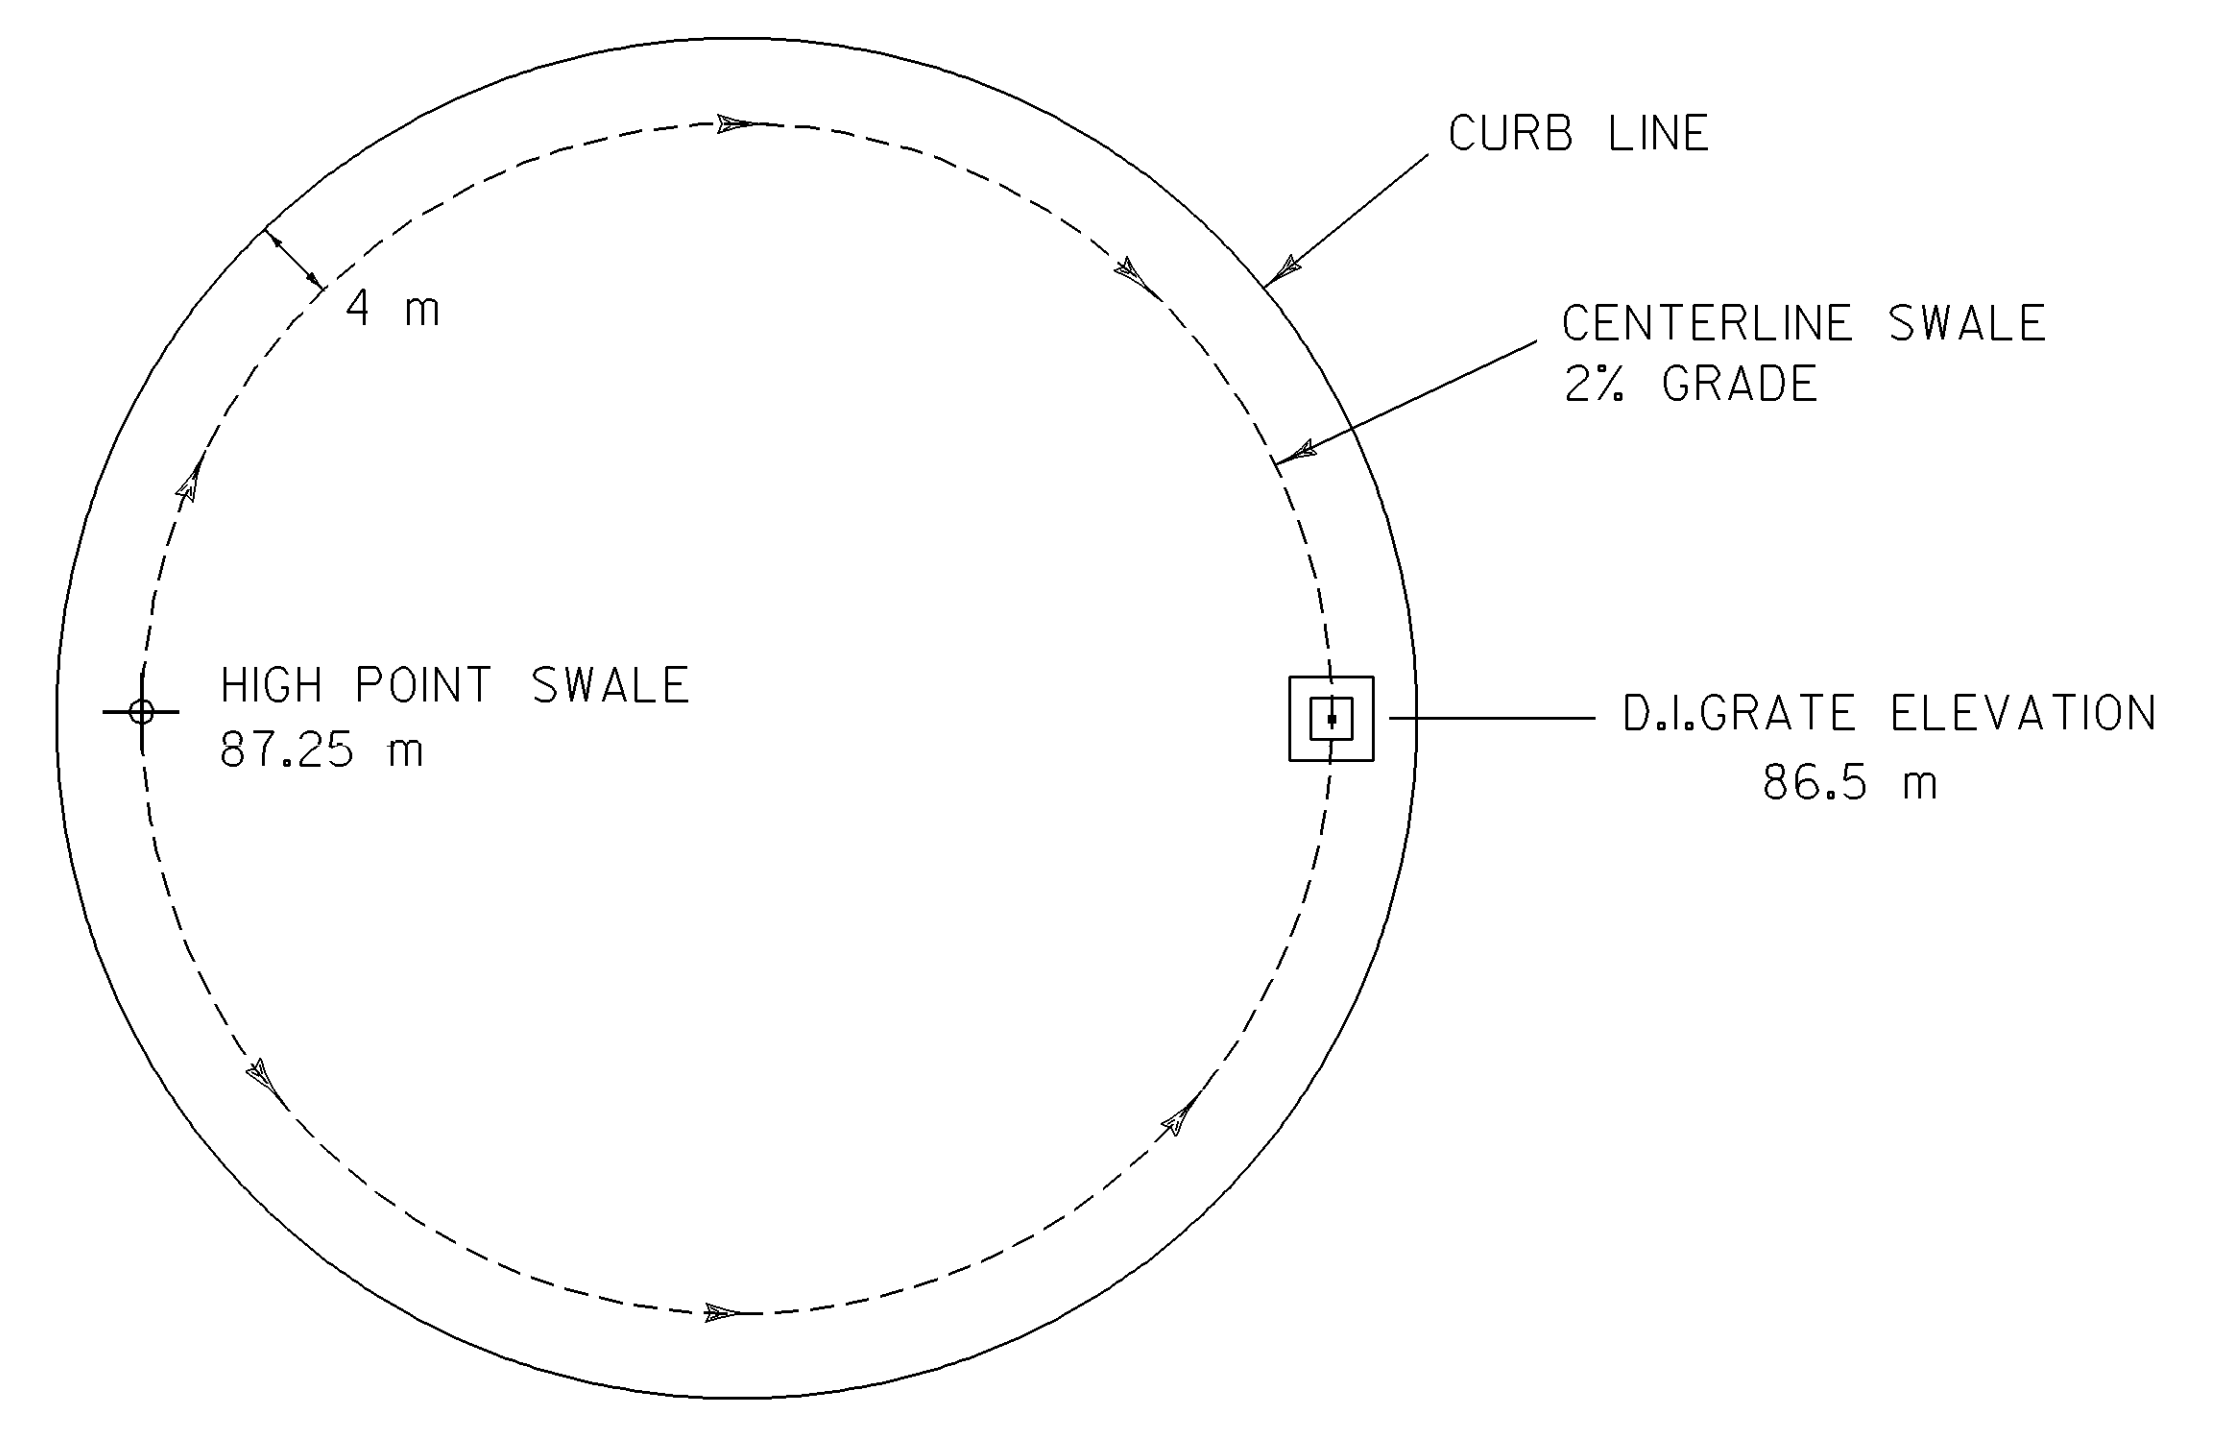

DRAINAGE DIAGRAM

DATUM	
VERTICAL	_____
HORIZONTAL	_____

PROJECT:	BRATTLEBORO	PROJECT NO.:	NH_2000(18)
DESIGN FILE NAME:	Z:\sdc\23d191\dd191xs3.dgn		
IPARM FILE NAME:	dd191xl1	PLOT DATE:	8-APR-1999
SURVEYED BY:		SURVEY DATE:	
SQUAD LEADER:	MENARD	DRAWN BY:	SQUAD_C
		SHEET:	62 OF 67