


DATUM
 VERTICAL _____
 HORIZONTAL _____

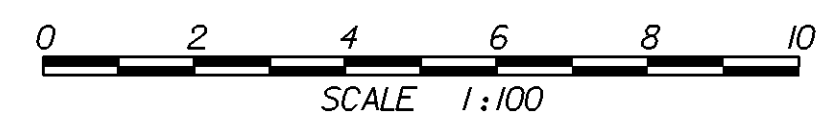

PROJECT:		PROJECT NO.:
BRATTLEBORO		NH 2000(18)
DESIGN FILE NAME: Zsqdc\93d191\dd191xs2.dwg		PLOT DATE: 8-APR-1999
IPARM FILE NAME: dd191x12.1	SURVEY DATE:	
SURVEYED BY:	DRAWN BY: SQUAD_C	
SQUAD LEADER: MENARD	SHEET: 63 OF 67	

VT. RTE. 9