


DATUM	
VERTICAL	_____
HORIZONTAL	_____

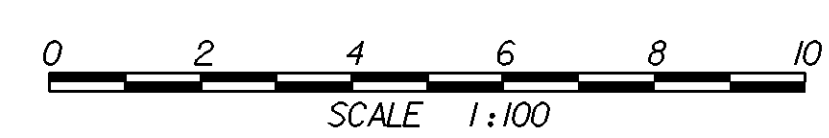

VT. RTE. 9	
PROJECT: BRATTLEBORO	PROJECT NO.: NH 2000(18)
DESIGN FILE NAME: Zsqdc\93d19\dd19\ss3.dwg	PLOT DATE: 8-APR-1999
IPARM FILE NAME: dd19\15.t	SURVEY DATE:
SURVEYED BY:	DRAWN BY: SQUAD_C
SQUAD LEADER: MENARD	SHEET: 66 OF 67