


DATUM
 VERTICAL _____
 HORIZONTAL _____

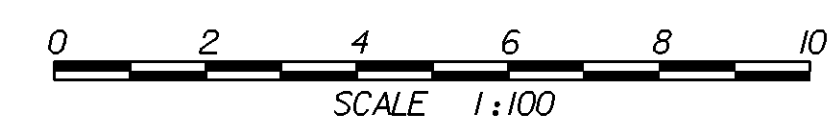

VT. RTE. 9	
PROJECT: BRATTLEBORO	PROJECT NO.: NH 2000(18)
DESIGN FILE NAME: Zsdc\93d19\dd19\ss3.dwg	PLOT DATE: 8-APR-1999
IPARM FILE NAME: dd19\16.i	SURVEY DATE:
SURVEYED BY:	DRAWN BY: SQUAD C
SQUAD LEADER: MENARD	SHEET: 67 OF 67