

# RIGHT - OF - WAY DETAIL SHEET


TABLE OF PROPERTY ACQUISITION

PARCEL NO.	PROPERTY OWNER	SHEET NO.	BEGINNING STATION	ENDING STATION	TAKE	REMAINDER	RIGHT			RECORDING DATA				REMARKS	
					AREA±	AREA±	TYPE	(T)(P)	AREA ±	TITLE	DATE	TOWN / CITY	BOOK		PAGE
1A	WOODSTOCK ASSOCIATES, INC.	11	3+68.35 RT.	4+60.84 RT.			CONST.	(T)	3032 SF±	WD	11/29/05	WOODSTOCK	195	110-112	INCLUDES SNOWFENCE
1B		11	5+29.61 RT.	5+68.29 RT.			CONST.	(T)	299 SF±						INCLUDES PDF & EROSION CONTROL
1C		11	6+01.53 RT.	6+53.99 CL	1111SF±		ALL R.T. & I.								HWY. EASE. U.S. RTE. 4 (T.H. 1)
2	DUNLEAVY, CHRISTINE Z.	11	6+09.67 CL	6+60.86 LT.	1079 SF±		ALL R.T. & I.			WD	12/13/05	WOODSTOCK	195	334-335	HWY. EASE. U.S. RTE. 4 (T.H. 1)
3	MCGEE, JOAN M.	11	6+53.99 CL 6+72.33 LT. 6+82.78 LT.	6+98.87 LT. 7+01.78 LT. 6+99.69 LT.	976 SF±		ALL R.T. & I. CONST. CHANNEL	 (T) (P)	 357 SF± 66 SF±	WD	10/07/05	WOODSTOCK	194	181-182	HWY. EASE. U.S. RTE. 4 (T.H. 1)
4A	MANDEL, DAVID B. & KATHIE	11	7+82.40 RT. 7+77.76 RT. 7+53.80 RT. 8+55.68 RT.	8+03.20 RT. 8+07.34 RT. 8+13.91 RT. 8+67.80 RT.	34 SF±		SLOPE INSTALL EXCEPT & RESERVE	 (P) (T)	 49 SF± 176 SF±	WD	11/29/05	WOODSTOCK	195	105-107	SNOW FENCE & EROSION CONTROL WOOD FENCE
4B		11	6+46.92 RT. 6+64.67 RT. 6+53.04 RT.	6+93.66 CL 6+88.01 RT. 6+87.78 RT.	1006 SF±		ALL R.T. & I. CHANNEL CONST.	 (P) (T)	 32 SF± 395 SF±						HWY. EASE. U.S. RTE. 4 (T.H. 1)
5	VERIZON NEW ENGLAND, INC.														UTILITY
6	CENTRAL VERMONT PUBLIC SERVICE CORPORATION														UTILITY
7	WOODSTOCK AQUEDUCT COMPANY														UTILITY

TABLE OF REVISIONS

REVISION NO.	SHEET NO.	DESCRIPTION	DATE
1	10,11	PARCEL NO. 2 DUNLEAVY. DELETE CONST. (T). DELETE SUB-PARCEL 2A. PER C.O. 9408. MADE BY: M.R. APPROVED BY: R.P.D.	03/16/05
2	10,11	PARCEL NO. 4 MANDEL. ADD LANDSCAPE (T) AT STATION 7+50 RT. ~ 8+25+00 RT. PER C.O. 9409. MADE BY: M.R. APPROVED BY: R.P.D.	03/16/05
3	10,11	PARCEL NO. 4 MANDEL. REMOVE LANDSCAPE (T) AT STA. 7+50 RT. ~ 8+25+00 RT. PER C.O. 9423. MADE BY: M.R. APPROVED BY: R.P.D.	06/01/05
4	10,11	PARCEL NO. 3 MCGEE. REMOVE F. ALLEN MCGEE FROM PLANS AND DOCUMENTS. PER C.O. 9430. MADE BY: M.R. APPROVED BY: R.P.D.  PAPER PRINTS TO STRUCTURES 9/14/06	07/11/05

PLAN LEGEND

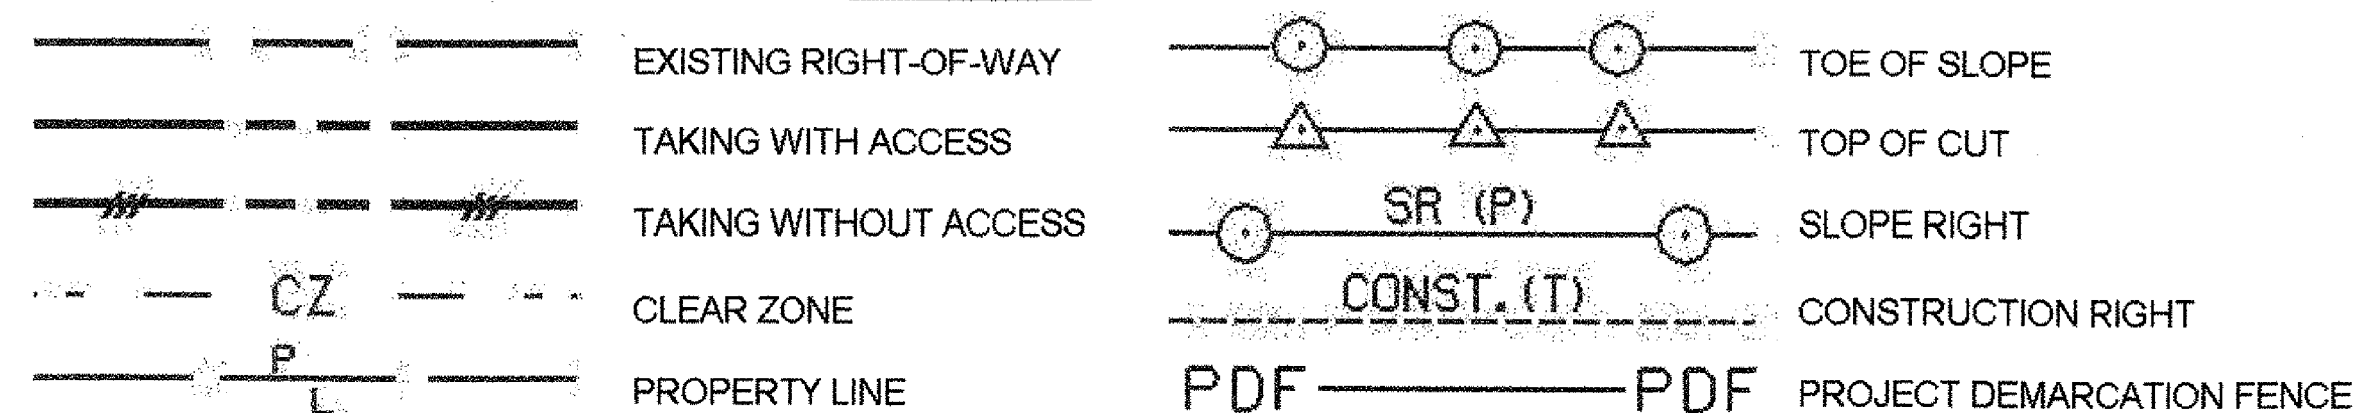

- (P) -PERMANENT
- (T) -TEMPORARY
- DR. -DRAINAGE RIGHT
- DIT. -DITCHING RIGHT
- CH. -CHANNEL RIGHT
- DRIVE -DRIVE RIGHT
- CUL. -CULVERT RIGHT
- C&T -CLEARING & TRIMMING RIGHT
- SR -SLOPE RIGHT
- UE -UTILITY EASEMENT

APPROVED: ROGER P. DUMAS DATE: 02-02-05  
CHIEF, PLANS & TITLES

PLOT DATE 09/14/06

PROJECT NAME: **WOODSTOCK**  
PROJECT NUMBER: **BHF 020-2(32)**

SEP 14 2006

FILE NAME: **93J028**  
PROJECT LEADER: **C. WILLIAMS**  
DESIGNED BY:  
R.O.W. SHEET 10 OF 11

PLOT DATE:  
DRAWN BY: **MR**  
CHECKED BY: **RF**  
SHEET **9** OF **71**