

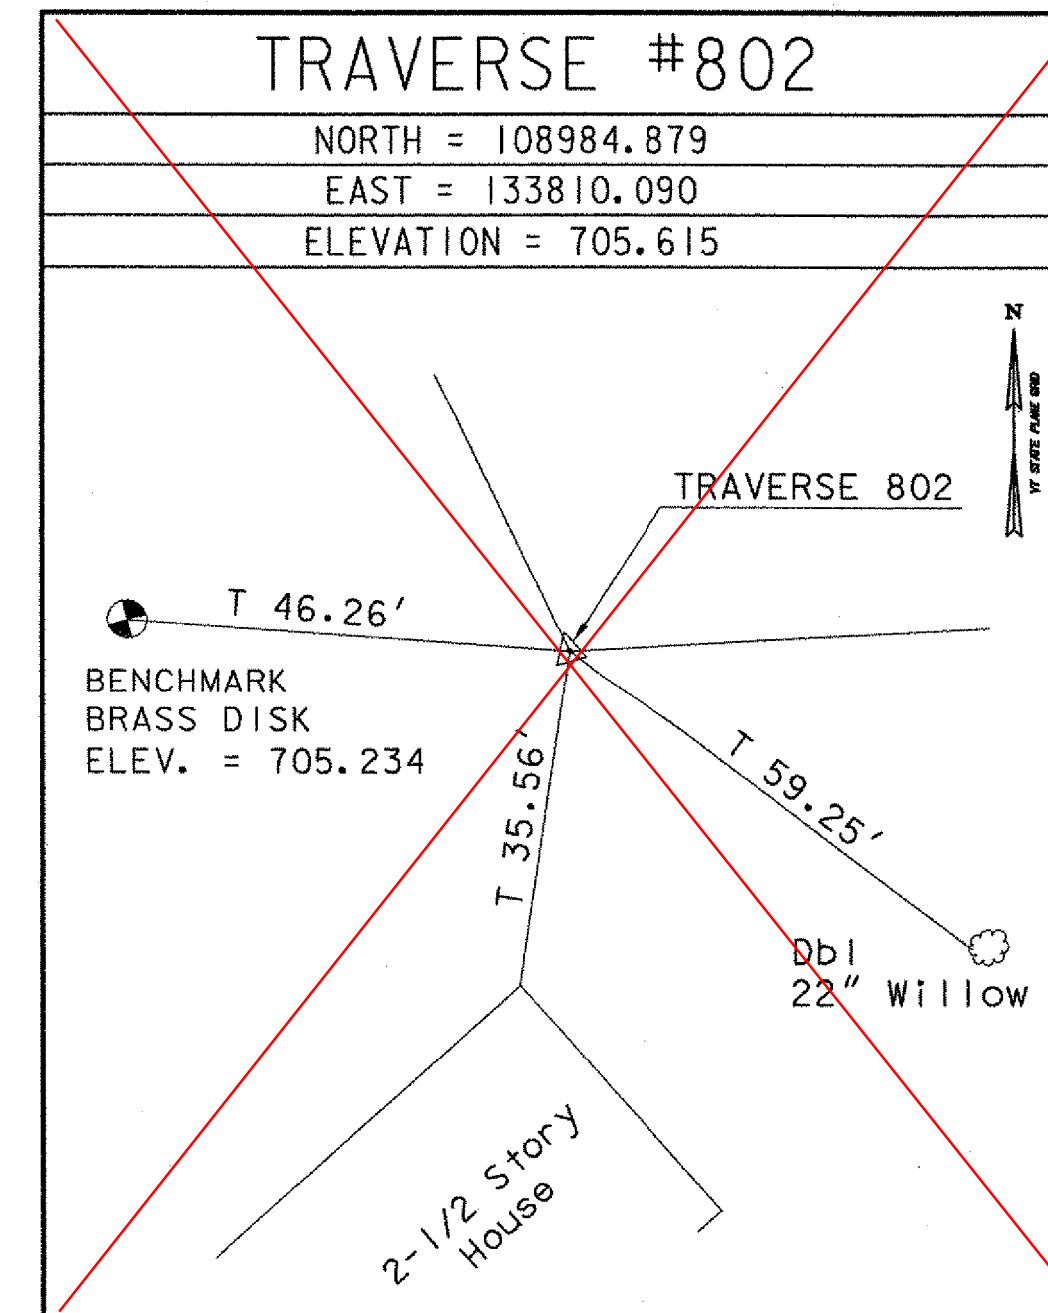
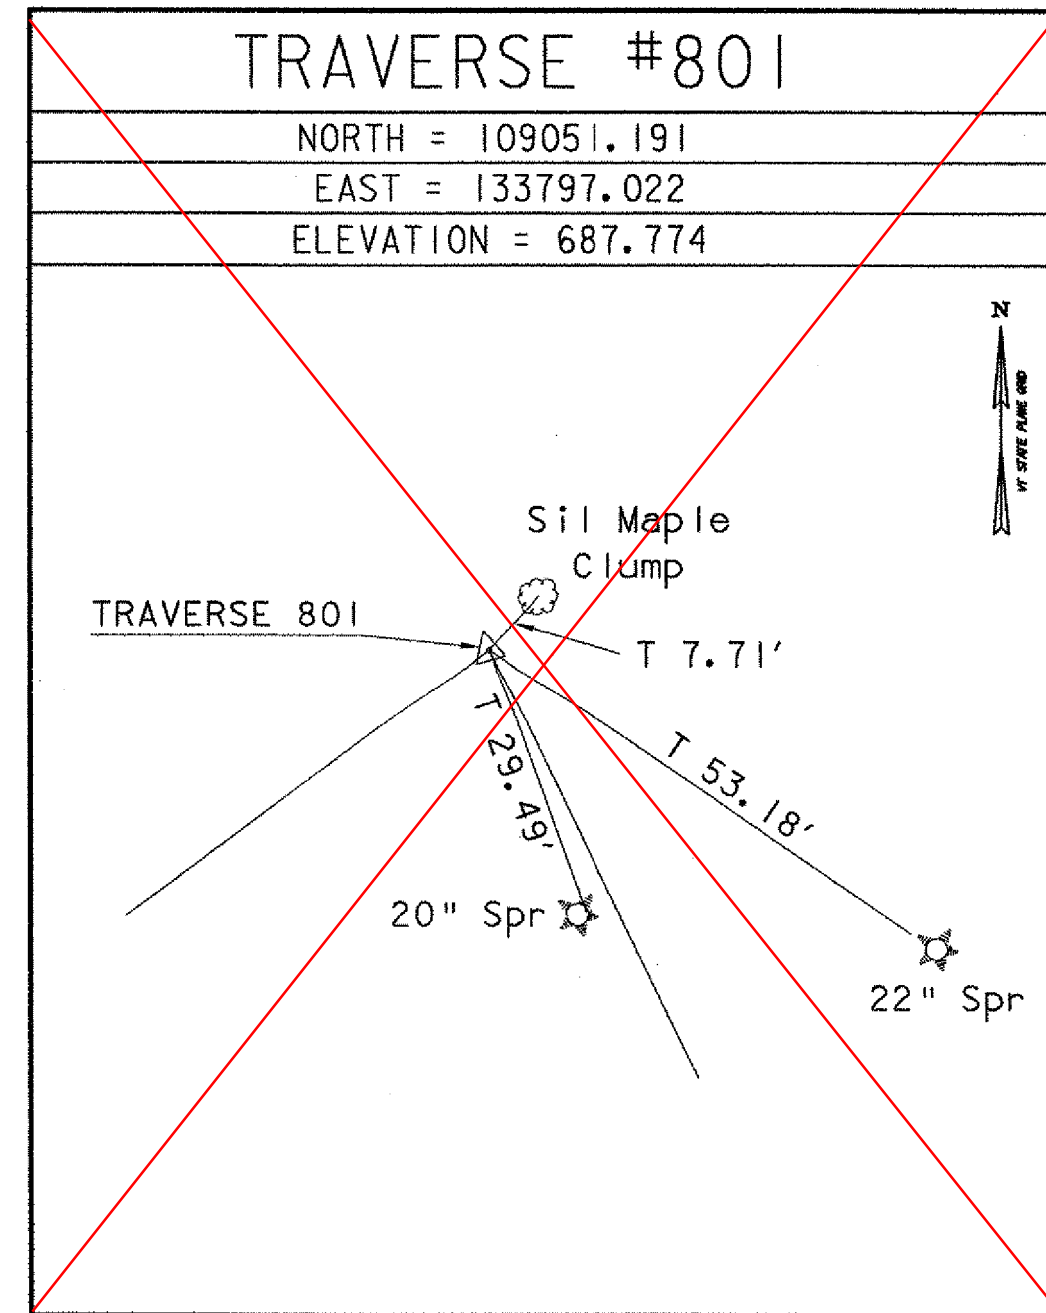
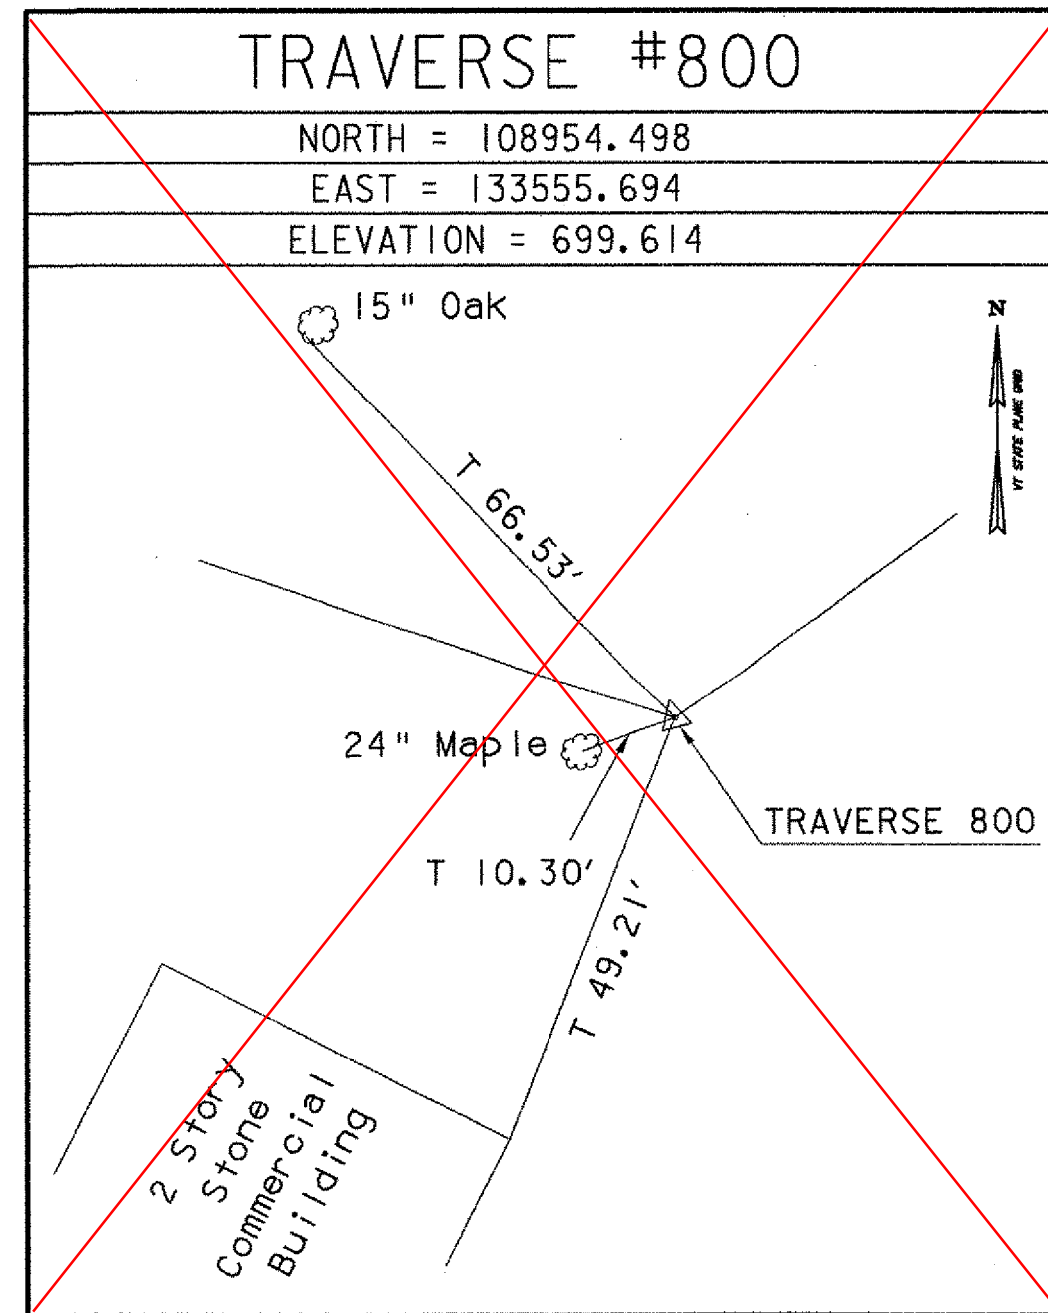
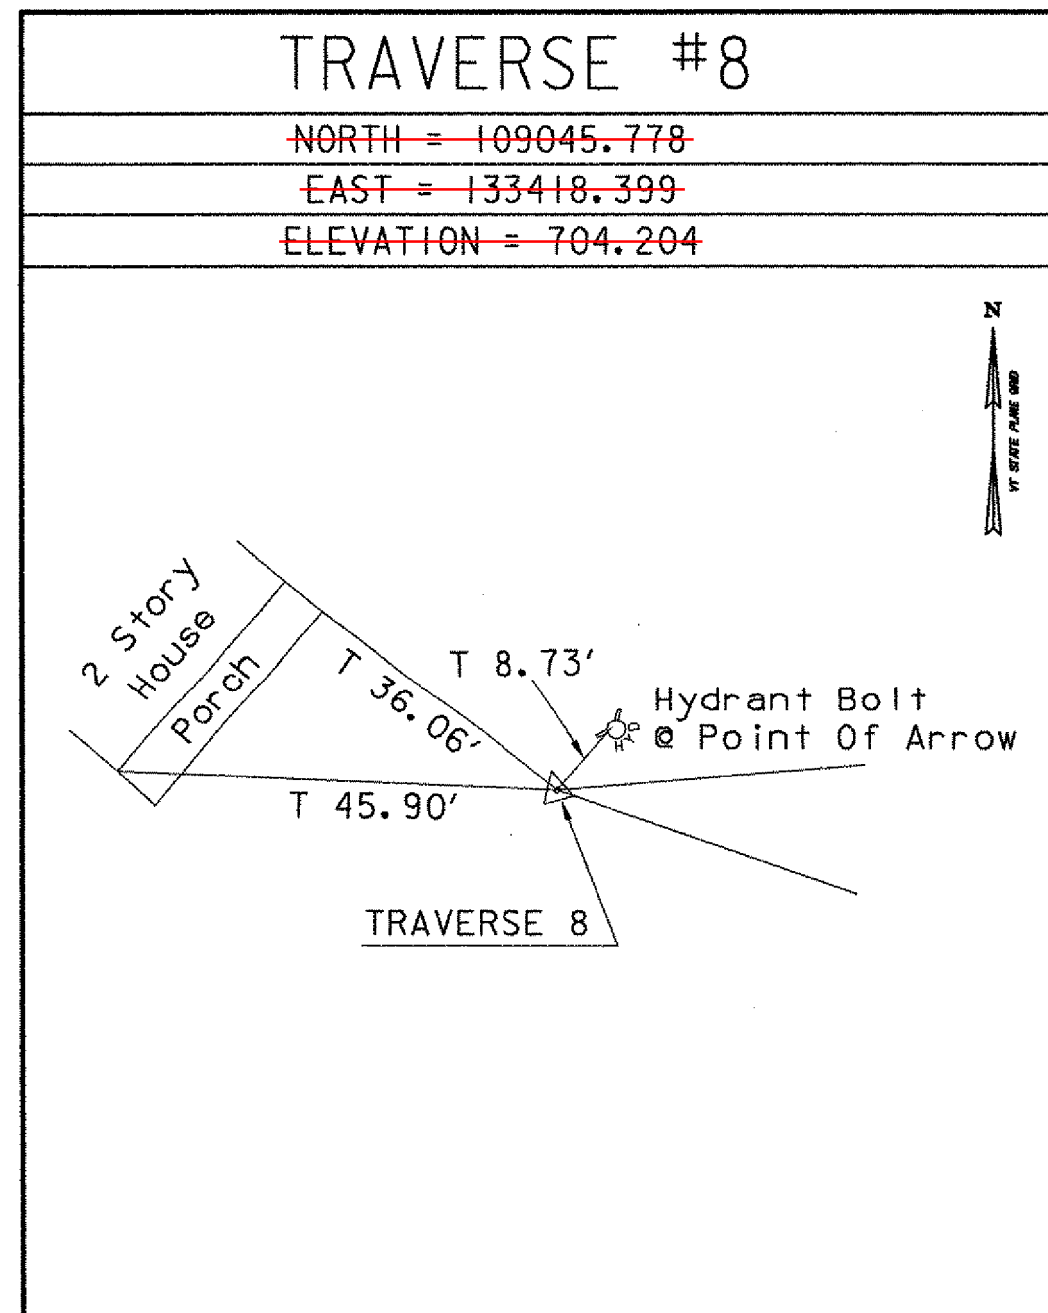
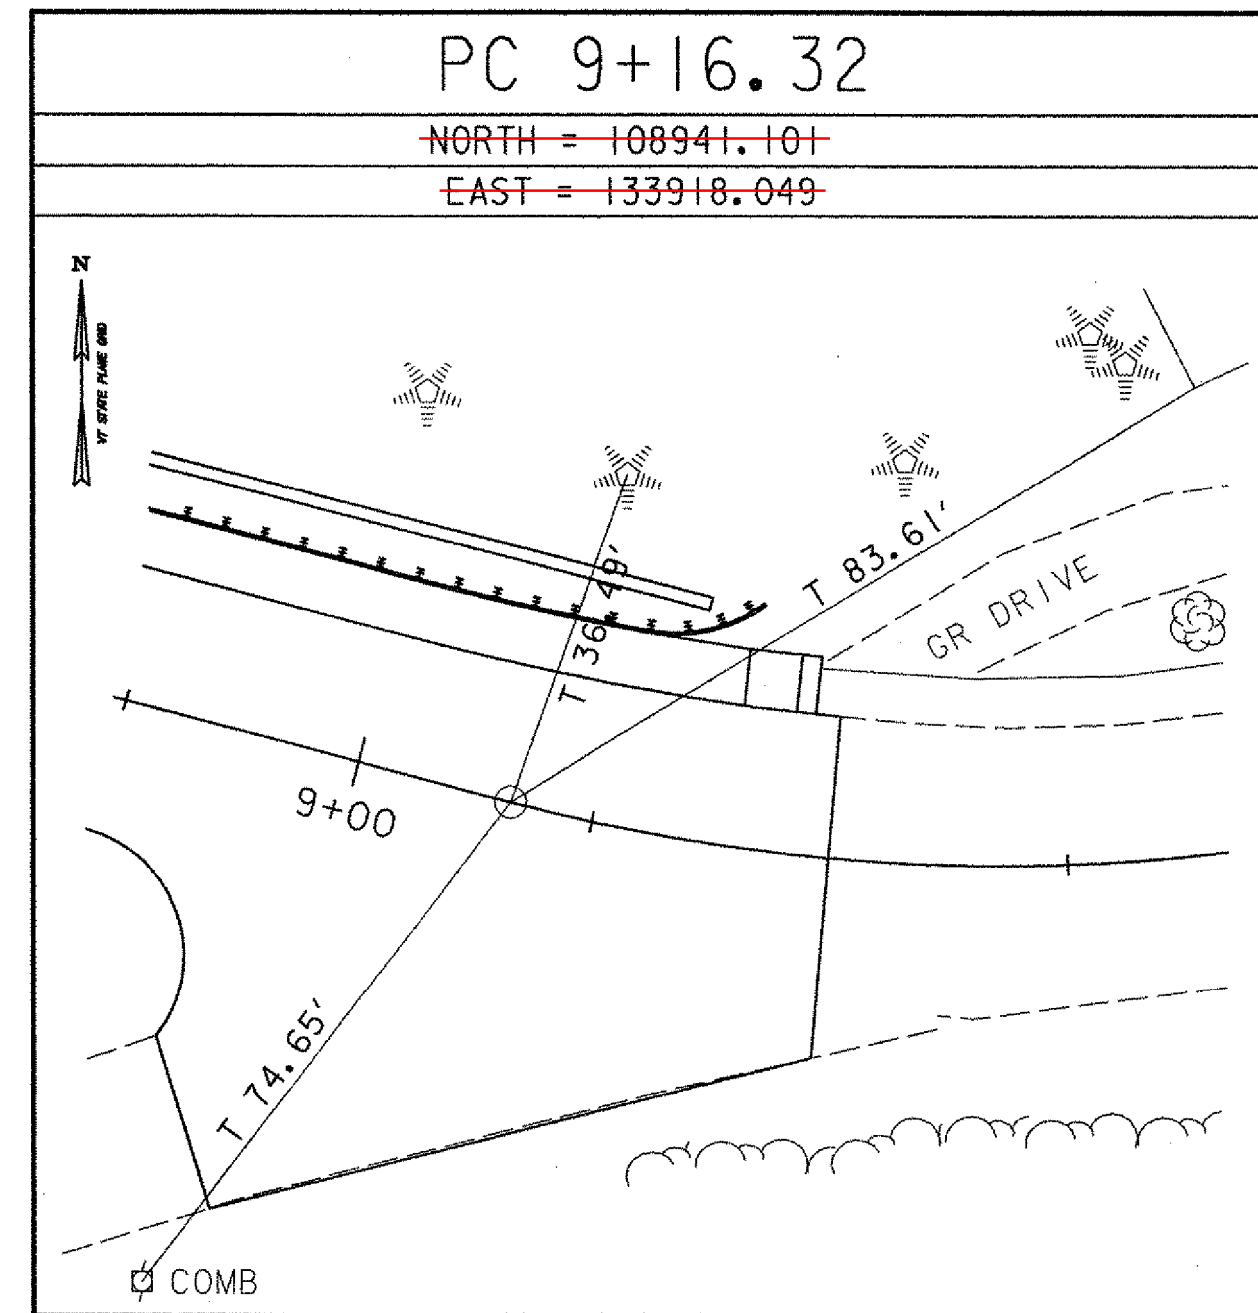


TRAVERSE TIES

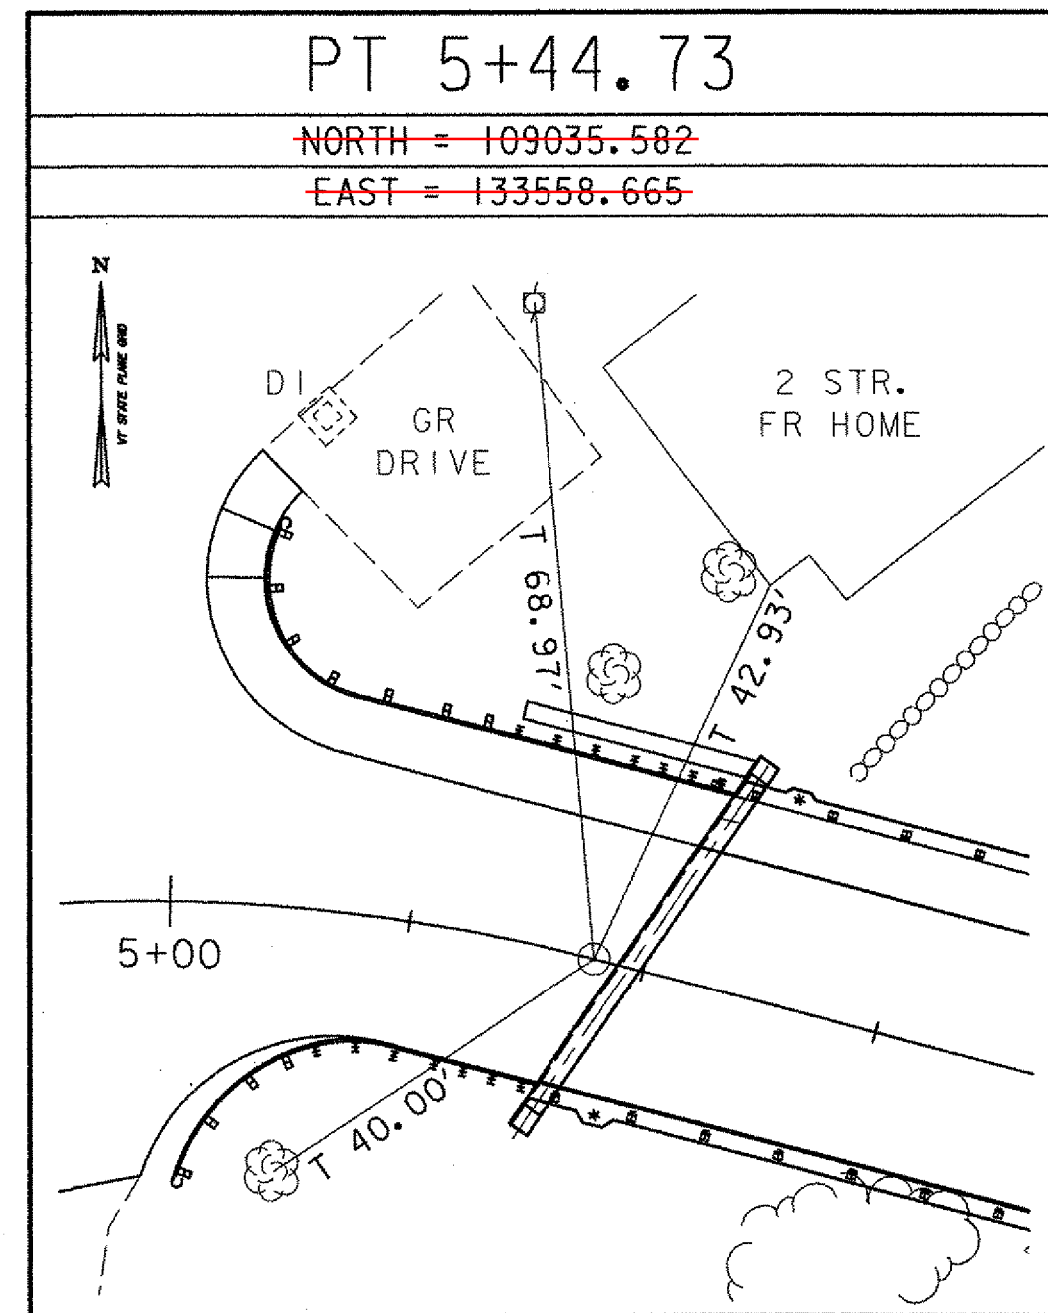

ALIGNMENT TIES

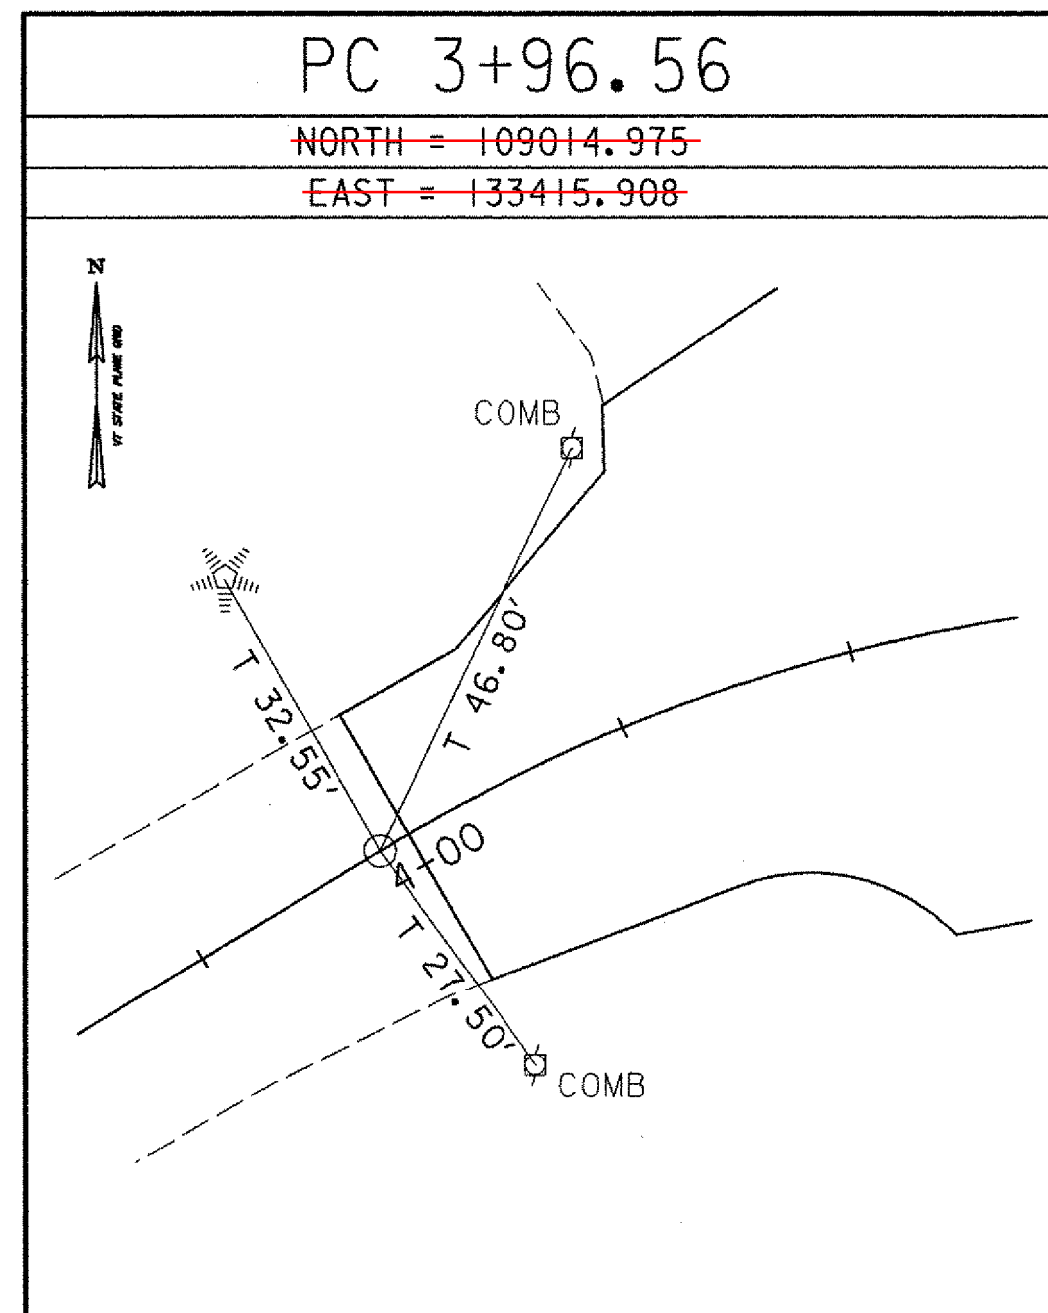

DATUM	
VERTICAL	NAVD 88
HORIZONTAL	NAD 83 (92)

STATE OF VERMONT AGENCY OF TRANSPORTATION	
Town Of WOODSTOCK	Bridge No. 50
Highway No. U.S. ROUTE 4	Log Sta. Surv. Sta.
U.S. ROUTE 4 OVER OTTAUQUECHEE RIVER	
SURVEY TIE SHEET	
Designed By BRUNO ASSOC.	Drawn By B. J. MASSE
Checked By BRUNO/B. J. M.	Bridge Design Supervisor M. A. COLGAN Date 9/06
PROJECT WOODSTOCK	PROJECT NO. BHF 020-2 (32)
I.G.C. Info.	
Bridge Sheet No. ZJ028TIE	Sheet 10 of 71

VHB Vanasse Hangen Brustlin, Inc.