


US ROUTE 4 PROFILE

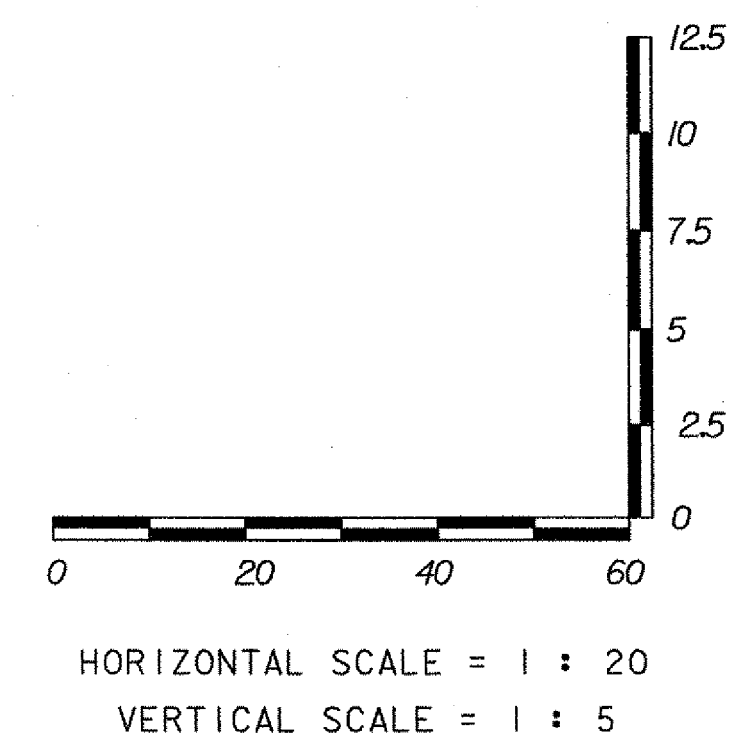

STATE OF VERMONT AGENCY OF TRANSPORTATION	
Town Of WOODSTOCK	Bridge No. 50
Highway No. U. S. ROUTE 4	Log Sta. Surv. Sta.
U. S. ROUTE 4 OVER OTTAUQUECHEE RIVER	
PROFILE	
Designed By B. J. MASSE	Drawn By B. J. MASSE
Checked By K. G. KRETSCH	Bridge Design Supervisor M. A. COLGAN
Date 10/06	Date 10/06
PROJECT WOODSTOCK	PROJECT NO. BHF 020-2 (32)
I.G.C. Info.	
Bridge Sheet No. ZJ028PRF	Sheet 13 of 71

VHB Vanasse Hangen Brustlin, Inc.