


PLAN
SCALE: 1/4" = 1'-0"

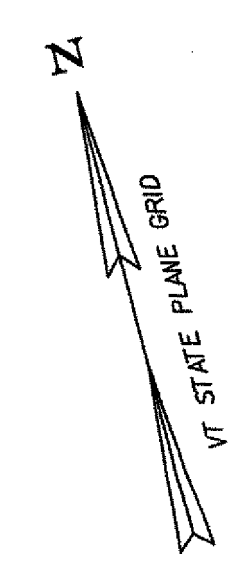

NOTE:
1. SEE SHEET 29 FOR NOTES, SHEET 32 FOR TYPICAL SECTIONS FOR EACH UNIT, AND SHEET 35 FOR SCUPPER DETAILS.

STATE OF VERMONT AGENCY OF TRANSPORTATION	
Town Of WOODSTOCK	Bridge No. 50
Highway No. U. S. ROUTE 4	Log Sta. Surv. Sta.
U. S. ROUTE 4 OVER OTTAUQUECHEE RIVER	
SPAN 3 FRAMING PLAN	
Designed By K. G. KRETSCH	Drawn By B. J. MASSE
Checked By S. M. HODGDON	Date 9/06
Bridge Design Supervisor M. A. COLGAN	Date 9/06
PROJECT WOODSTOCK	PROJECT NO. BHF 020-2 (32)
I.G.C. Info.	
Bridge Sheet No. ZJ028DK3	Sheet 31 of 71

VHB Vanasse Hangen Brustlin, Inc.