
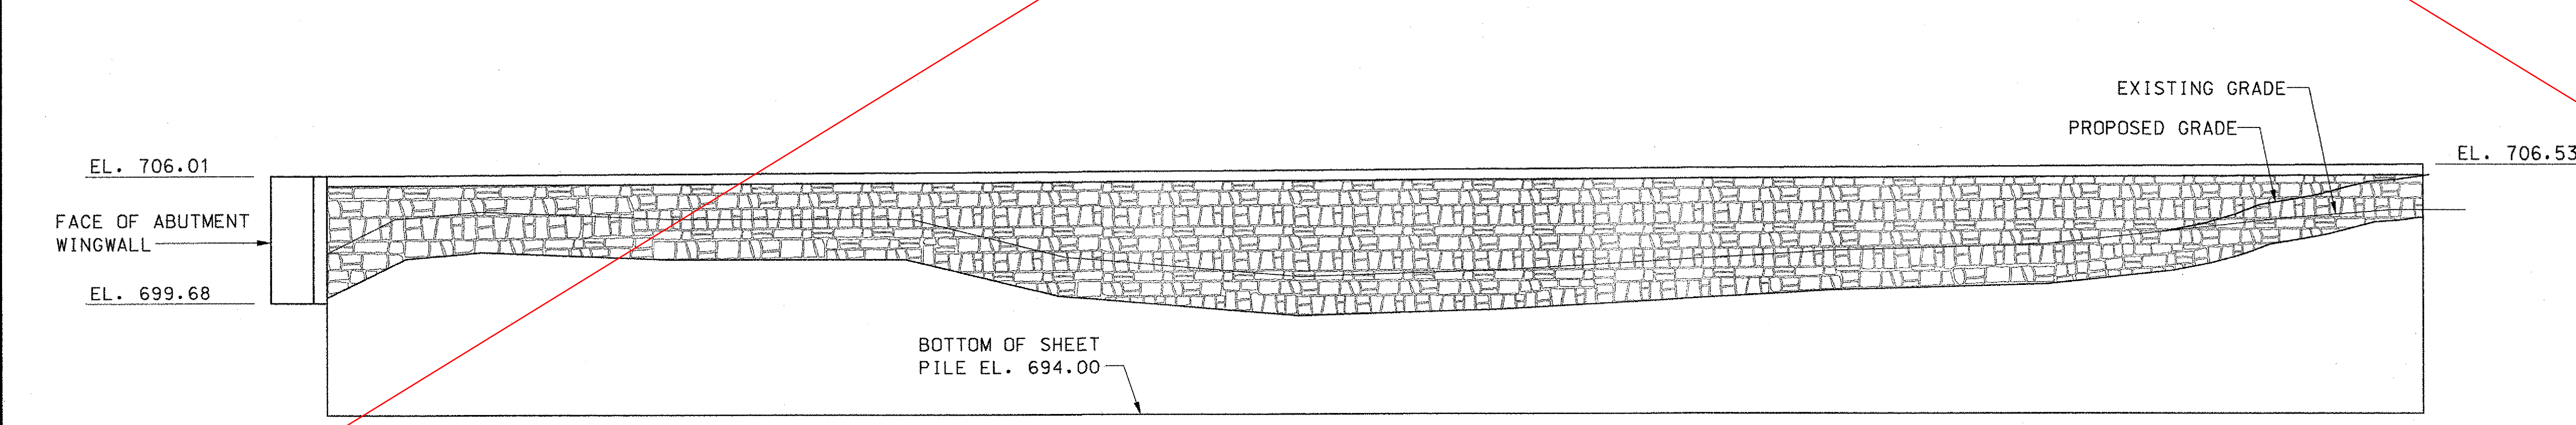


**ELEVATION**  
**NE RETAINING WALL**  
 SCALE: 1" = 5'

SUPERCEDED BY VALUE ENGINEERING  
 RETAINING WALL DESIGN SHEETS 1 & 2  
 DATED 5/9/2007.

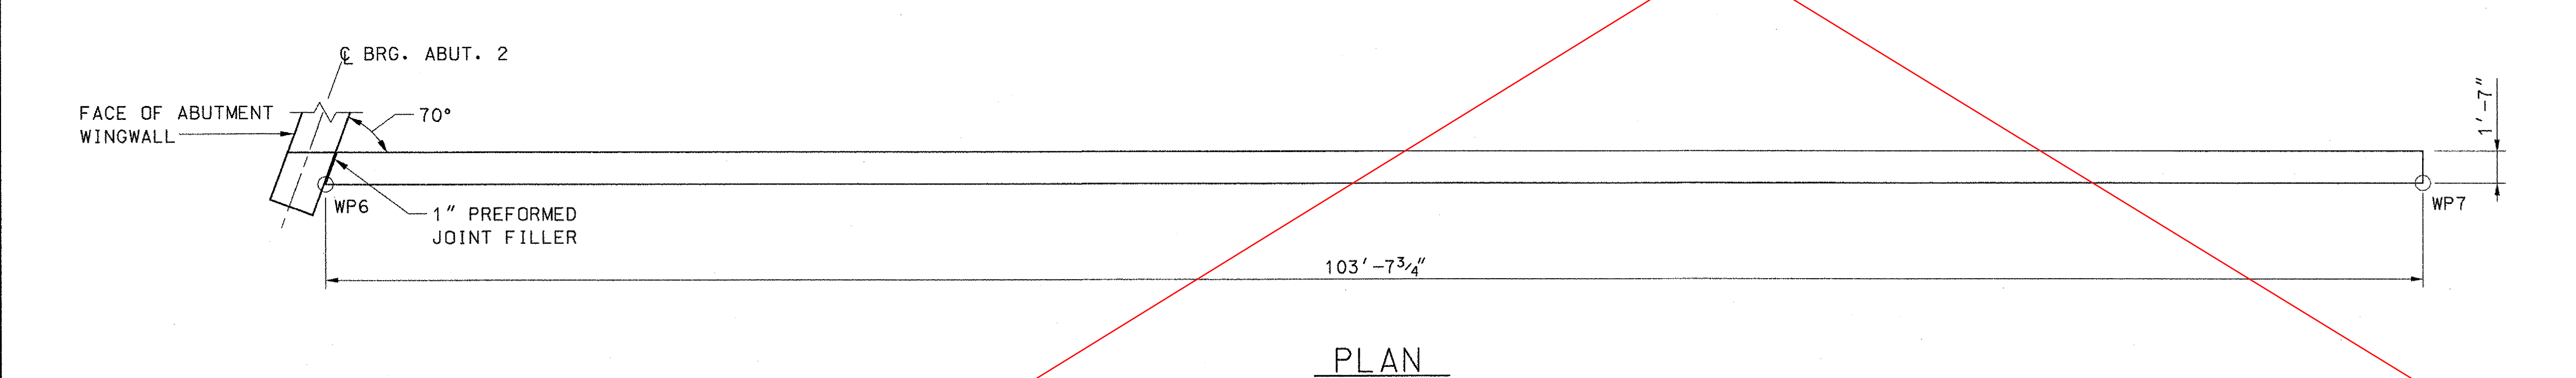

**ELEVATION**  
**SE RETAINING WALL**  
 SCALE: 1" = 5'

**STATE OF VERMONT**  
**AGENCY OF TRANSPORTATION**

Town Of	WOODSTOCK	Bridge No.	50
Highway No.	U.S. ROUTE 4	Log Sta.	
	U.S. ROUTE 4 OVER OTTAUQUECHEE RIVER	Surv. Sta.	
<b>RETAINING WALL LAYOUT (2 OF 2)</b>			
Designed By	W. M. MOSHER	Drawn By	B. J. MASSE
Checked By	K. G. KRETSCH	Bridge Design Supervisor	M. A. COLGAN
Date	9/06	Date	9/06
PROJECT	WOODSTOCK	PROJECT NO.	BHF 020-2 (32)

**VHB Vanasse Hangen Brustlin, Inc.**