


**ELEVATION**  
**NE RETAINING WALL**  
 SCALE: 1" = 5'

SUPERCEDED BY VALUE ENGINEERING  
 RETAINING WALL DESIGN SHEETS 1 & 2  
 DATED 5/9/2007.

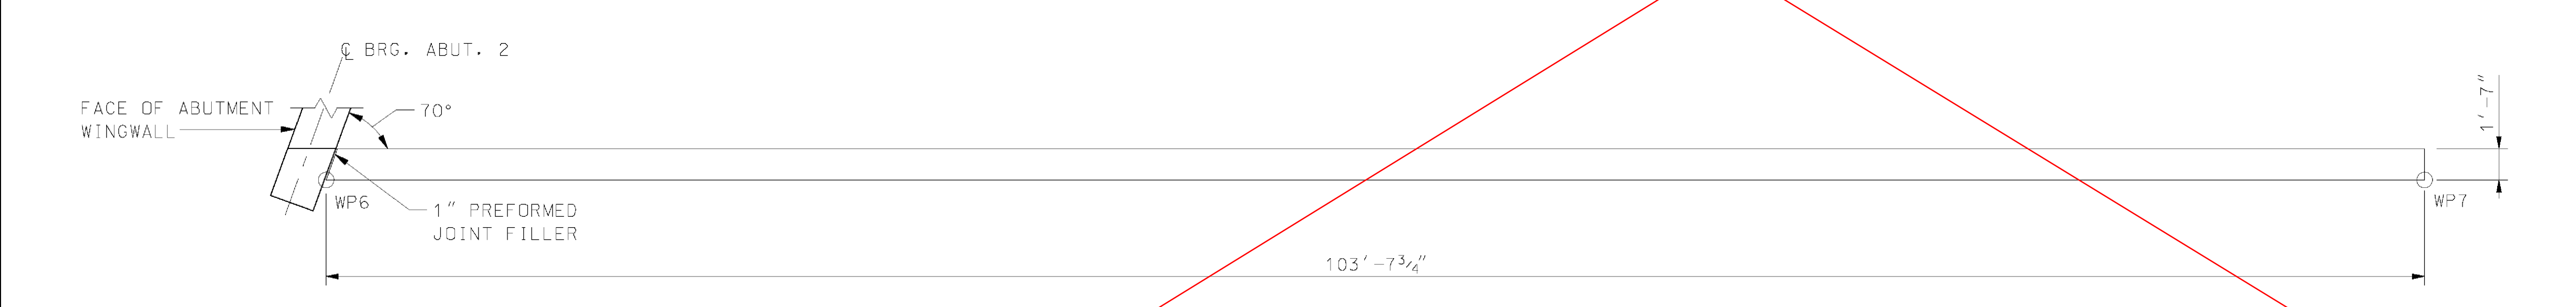

**PLAN**

**ELEVATION**  
**SE RETAINING WALL**  
 SCALE: 1" = 5'

**STATE OF VERMONT**  
**AGENCY OF TRANSPORTATION**

Town of WOODSTOCK Bridge No. 50  
 Highway No. U.S. ROUTE 4 Log Sta. / Surv. Sta.

**U.S. ROUTE 4 OVER OTTAUQUECHEE RIVER**  
**RETAINING WALL LAYOUT (2 OF 2)**

Designed By W. M. MOSHER Drawn By B. J. MASSE  
 Checked By K. G. KRETSCH Date 10/06 Bridge Design Supervisor M. A. COLGAN Date 10/06

PROJECT WOODSTOCK PROJECT NO. BHF 020-2 (32)

I.G.C. Info. Bridge Sheet No. ZJ028RW2-R Sheet 43R of 71

NO.	DESCRIPTION	BY	DATE
1	ELEVATION REVISIONS	JAM	5/07

**VHB Vanasse Hangen Brustlin, Inc.**