


PLAN

DATE: 9/17/54  
 APPROVED: *J. Perkins*  
 DISTRICT ENGINEER  
 CORRECT: *A. D. DeLoe*  
 BRIDGE ENGINEER  
 DATE: Sept. 24, 1954  
 APPROVED: *H. E. August*  
 CHIEF ENGINEER

NOTE: ANY FURTHER INFORMATION CONCERNING FINAL QUANTITIES, AMOUNTS OR OTHER DETAILS RELATIVE TO THIS PROJECT MAY BE FOUND IN EITHER THE FIELD BOOKS OR THE ESTIMATE FILE.

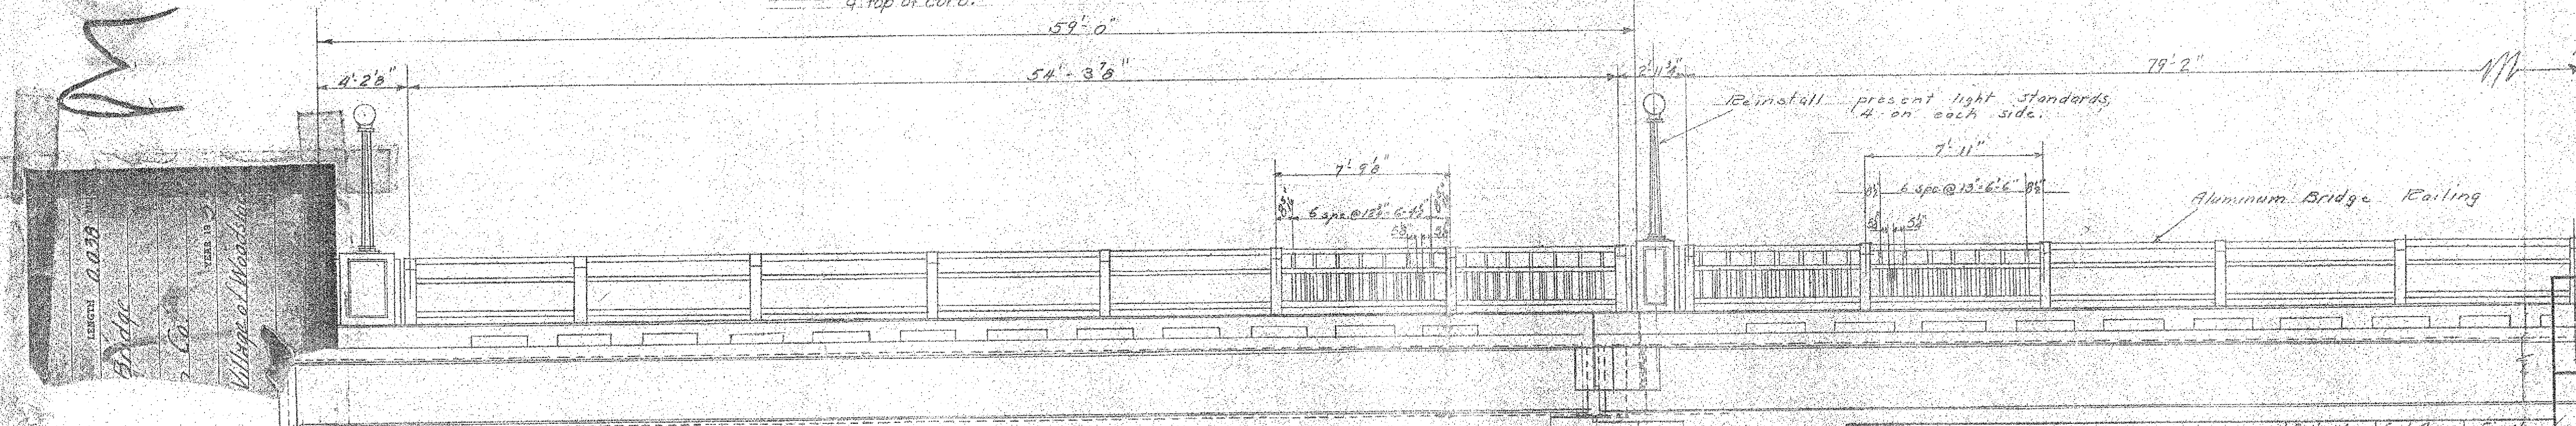

SECTION A-A

WOODSTOCK  
 MAR 1054 U.S.4 DR. 50

STATE OF VERMONT  
 DEPARTMENT OF HIGHWAYS  
 TOWN OF WOODSTOCK  
 ROAD No. USA BRIDGE No.  
 MARBLE BRIDGE  
 NEW SIDEWALK CURB & RAILINGS  
 SCALE: 1/4" = 1'-0"  
 SURVEYED BY: JLN  
 DRAWN BY: SN CHECKED BY: JLN  
 PROJECT No. SA 8-24  
 SHEET 1 OF 3

PROJECT NAME & NUMBER	TYPE	PAVEMENT AREA
WOODSTOCK (Marble Bridge) J.A. 8-1954		
RECORD PLANS		
MATERIALS		
CEMENT - Alpha Portland Cement ✓	BRIDGE PAINT - E.F. King Co. Norwood, Mass. ✓	
REINFORCING IRON - Truscon Steel Co. ✓		
CONTRACTOR - Miller Construction Co.		
RESIDENT ENGR. - M.H. Churchill ✓	CONTRACT DATED - Dec. 17, 1954 ✓	
INSPECTOR	CONTRACT STARTED - May 21, 1955 ✓	
RECORD PLANS - A.B. Mac Dougal ✓	CONTRACT COMPLETED - June 21, 1955 ✓	
	CONTRACT ACCEPTED - July 13, 1955 ✓	

ITEM NO.	ITEM	Estimate Quantity	Inst. Prop. Quantity	Final Quantity
101-B	Solid Rock Excavation	60 cy	235 cy	241 cy
109	Maint. of Traffic for Bridge Projects	1-LS	1-LS	1-LS
381	Bit Conc. Pavt for Bridge Floors	8.7 cu	61.7 cu	72.7 cu
401-B	Concrete (Class "B")	70 cy	124 cy	204 cy
402	Reinforcing Steel	5487 lbs	3627 lbs	3680 lbs
403-A	Structural Steel (Cleaning Paints only)	1-LS	1-LS	1-LS
407	Asphalting Asbestos Coating	45 sq	45 sq	93 sq
572	Bridge Railing (Wrought Iron)	376.11	376.11	409.11
573-A	Lighting System	1-LS	1-LS	1-LS

Town of Woodstock, Vt. 05445  
 General & Mill Co. Inc. Co.  
 Record Plans & Specifications  
 Contract No. 1054-24  
 Date: 9/17/54