



* TRANSITION TO 0.021 CROSS SLOPE FROM STA 5+00 TO BRIDGE


5+00
BEGIN PROJECT

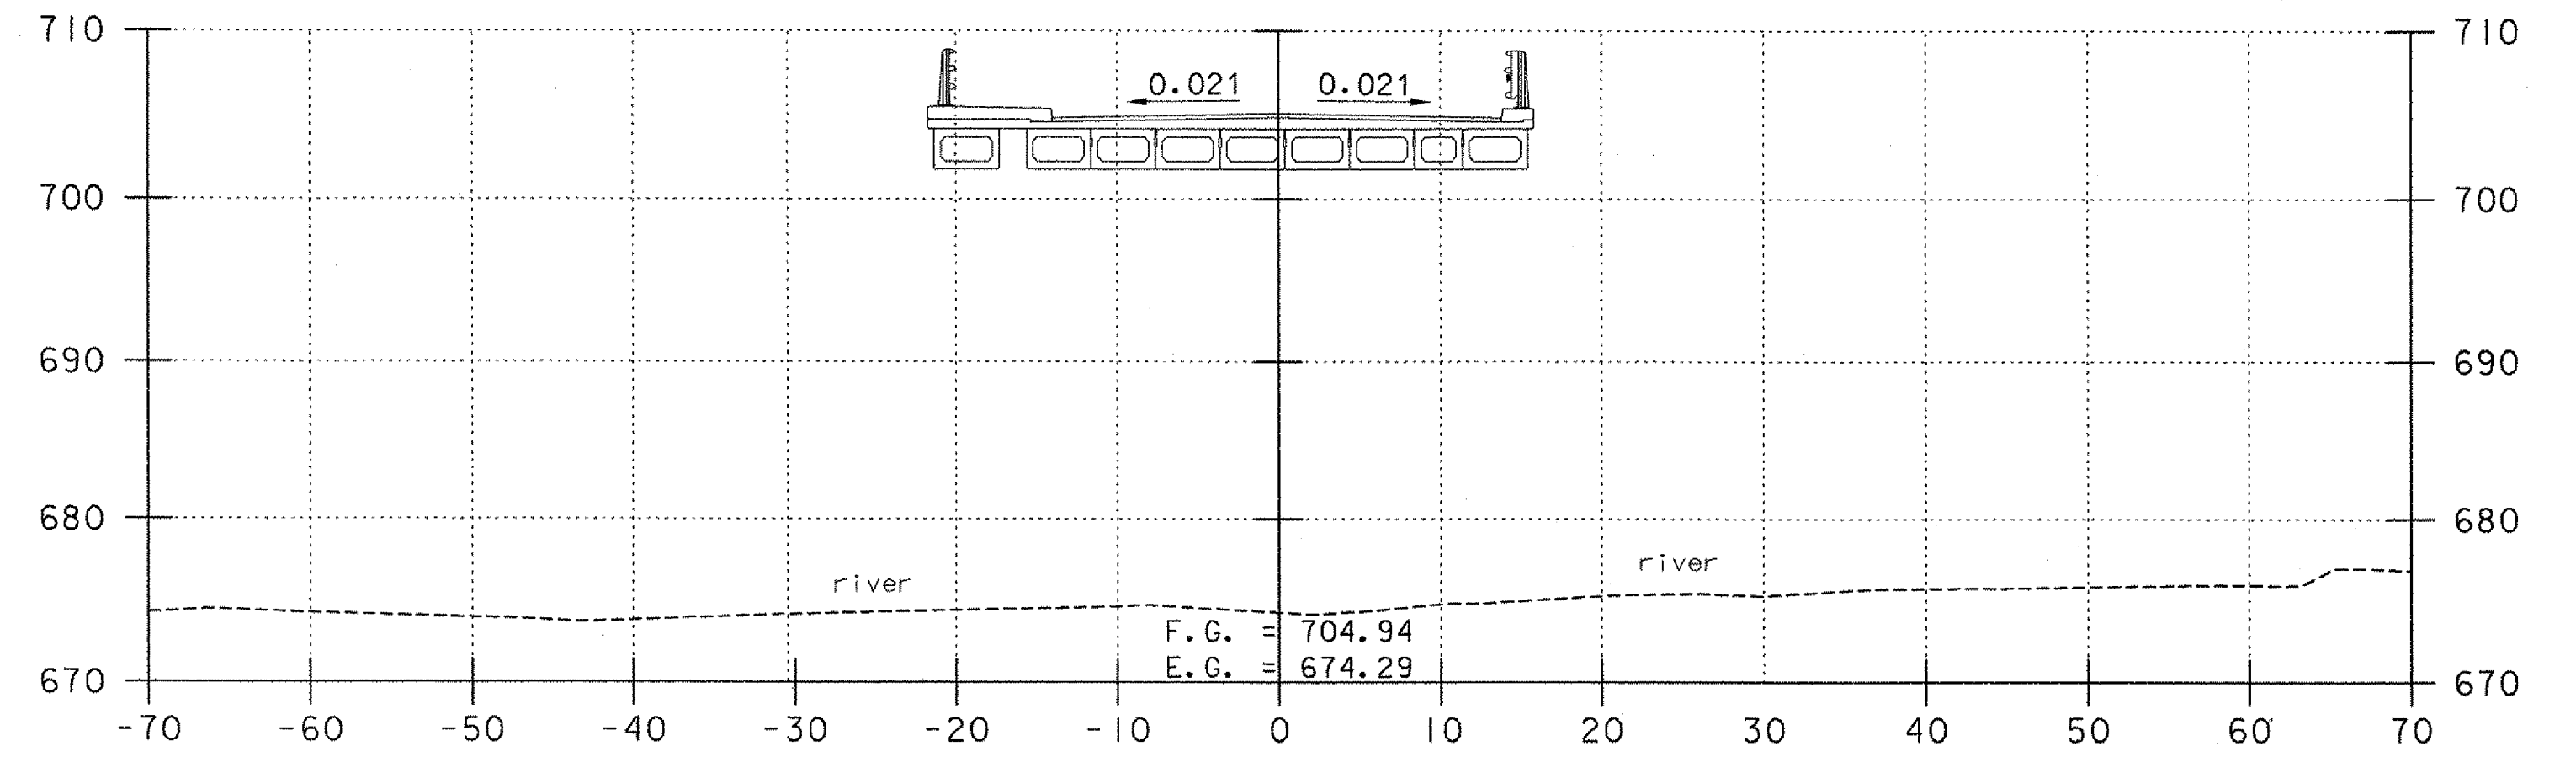


6+50

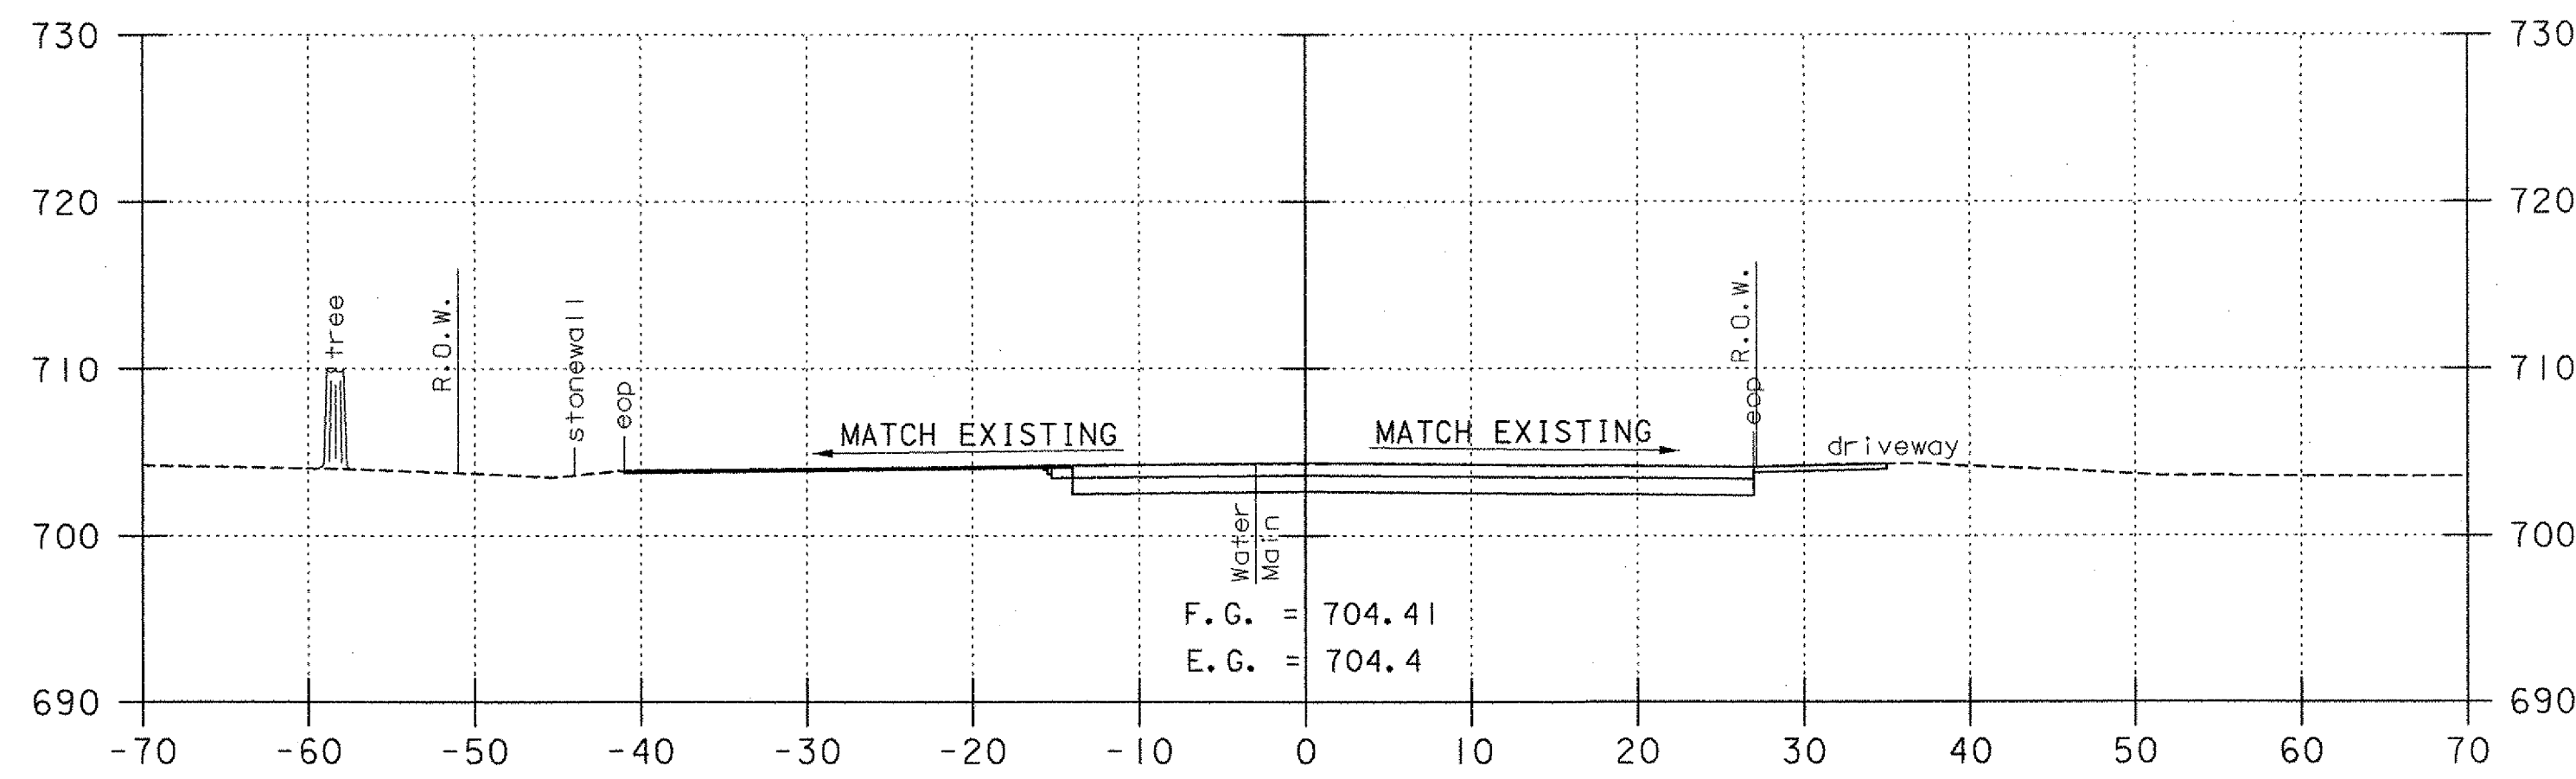


4+50

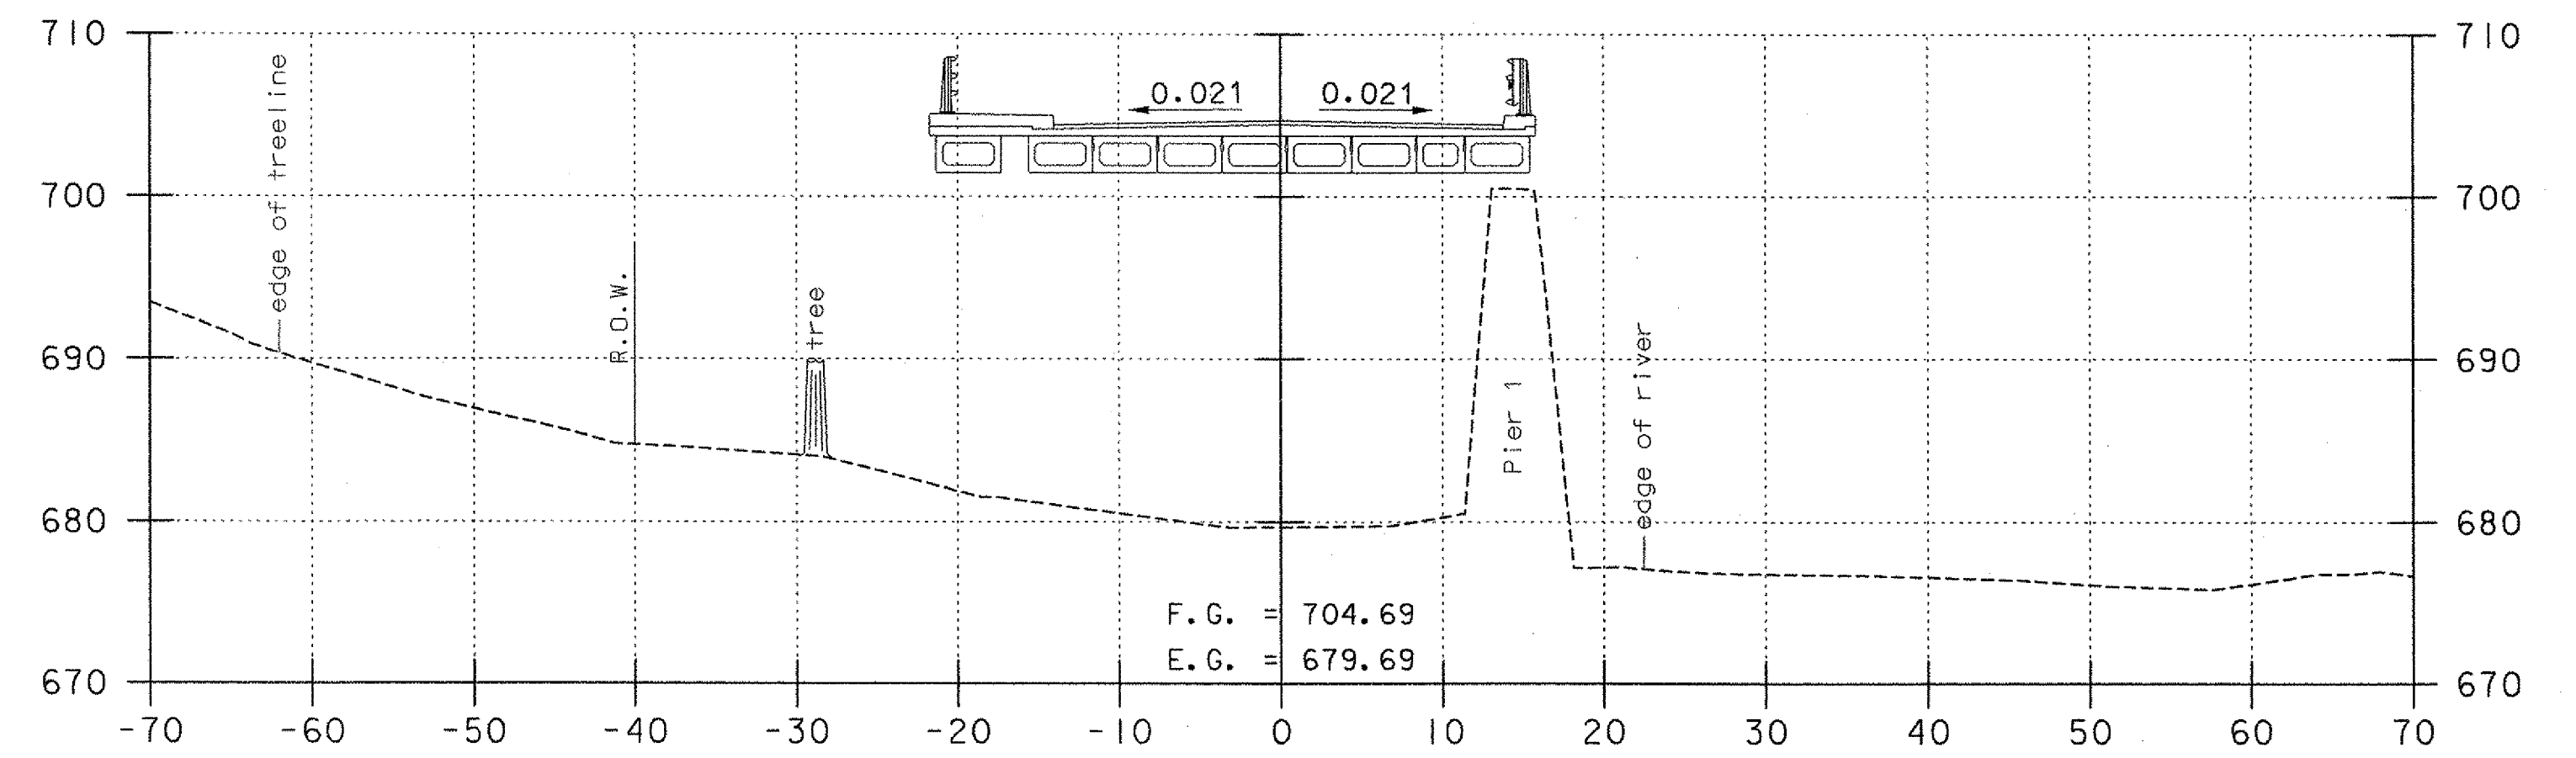

6+00

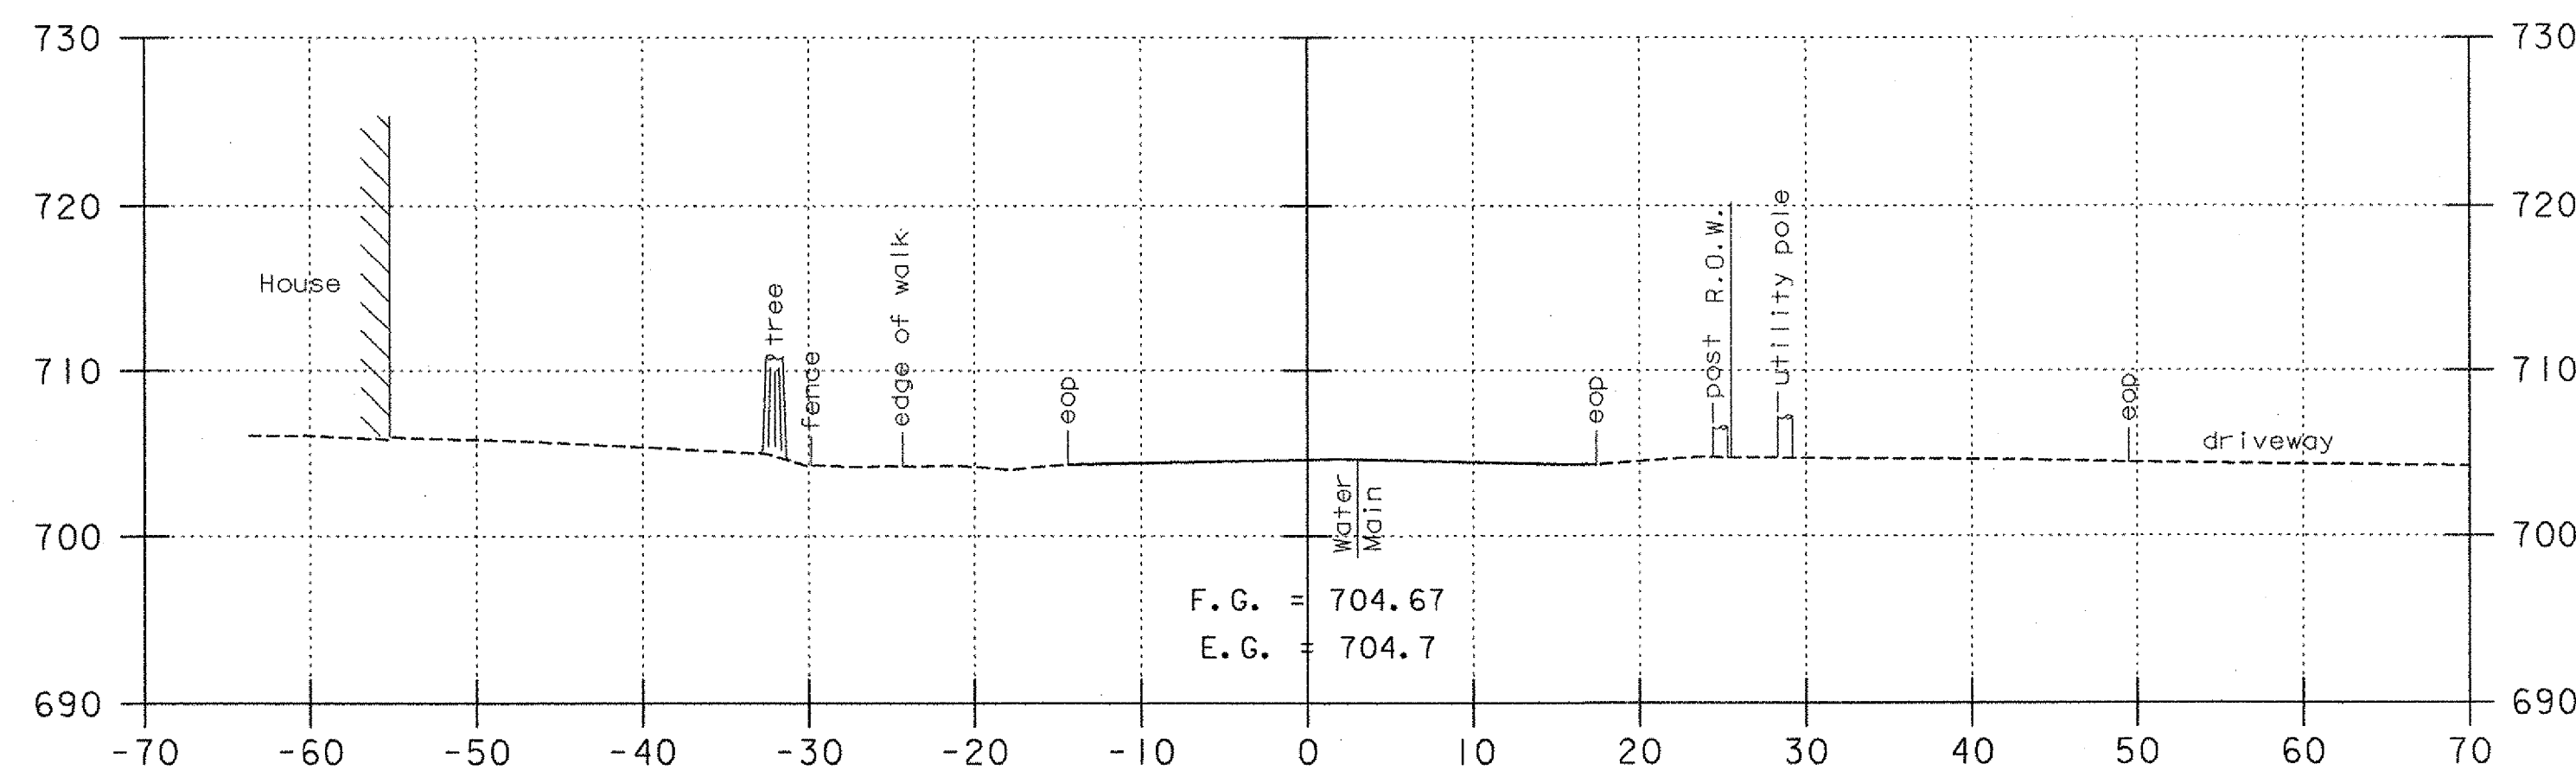

4+00
BEGIN APPROACH

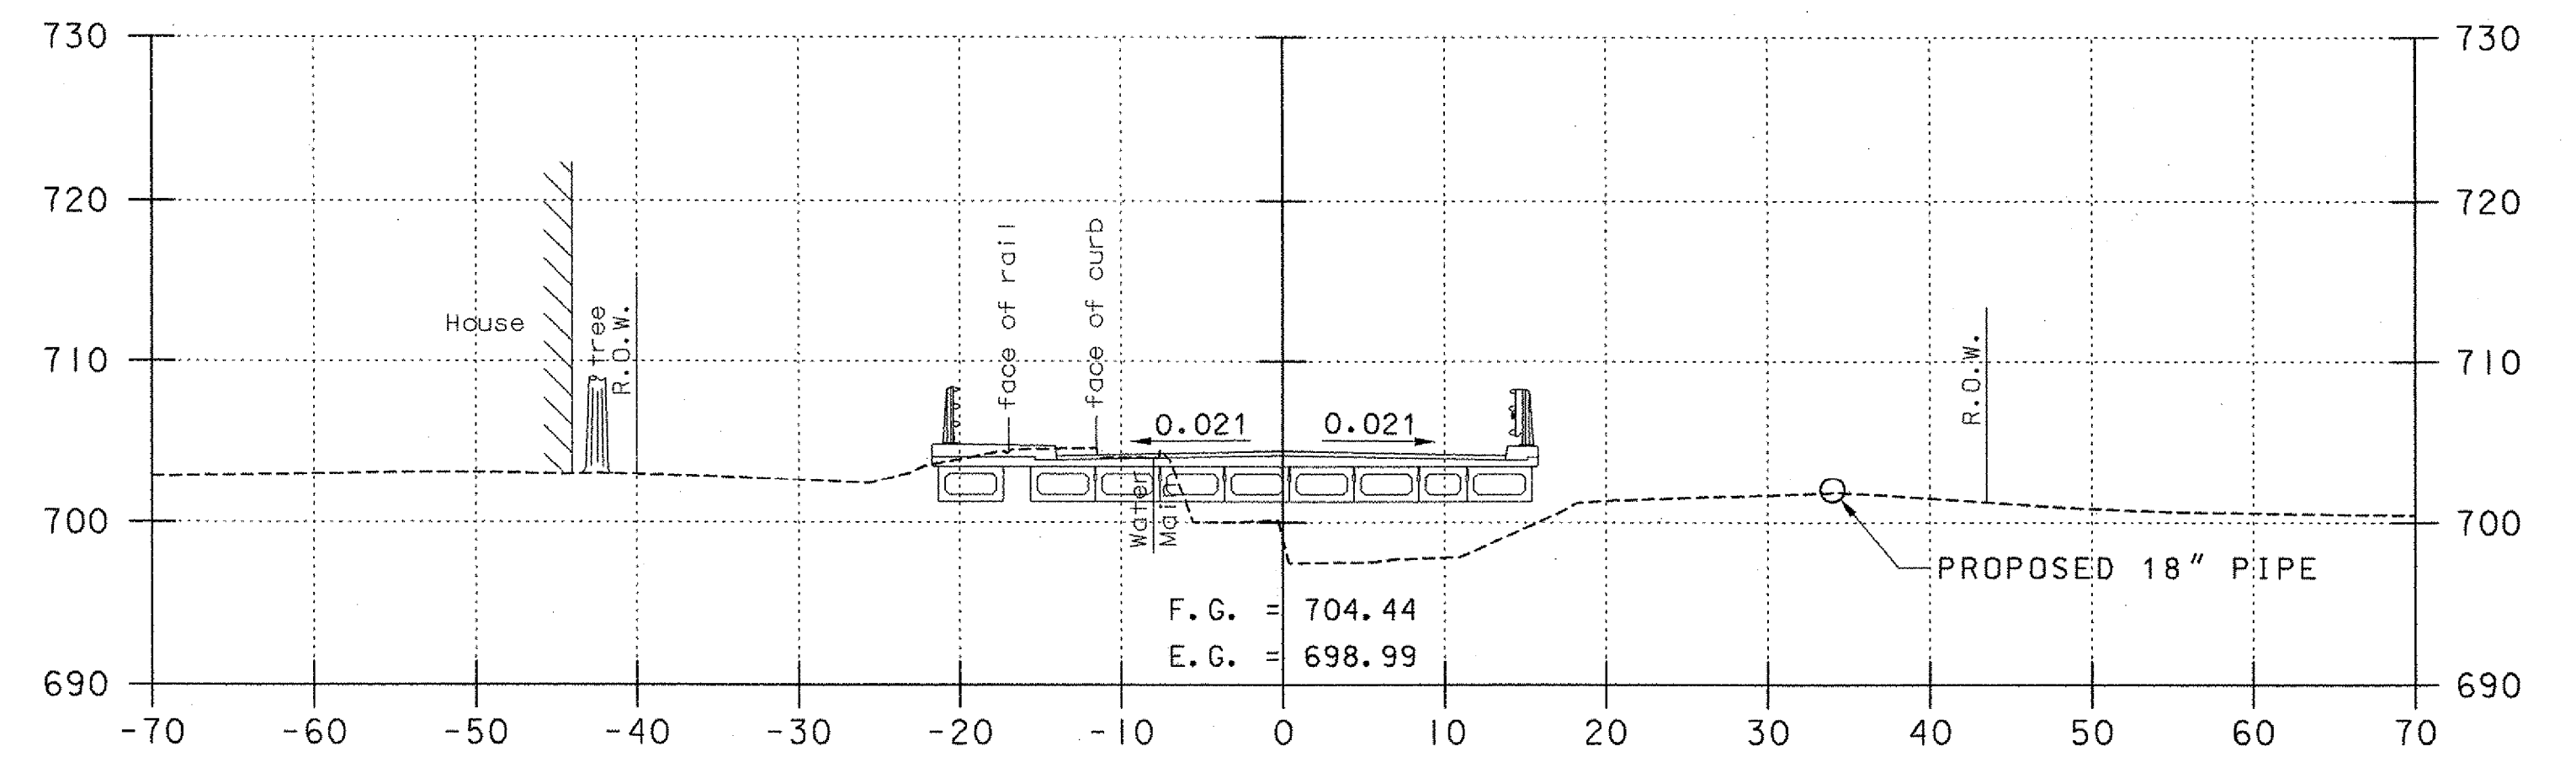

5+50
BEGIN BRIDGE
STA 5+47.50

US ROUTE 4 CROSS SECTIONS

FROM STA 4+00 TO STA 6+50
 PROJECT NAME WOODSTOCK
 PROJECT NO. BHF 020-2 (32)
 SURVEYED BY BRUNO ASSOCIATES, INC.
 SHEET 67 OF 71

SCALE 1" = 10'

VHB Vanasse Hangen Brustlin, Inc.