


50+50

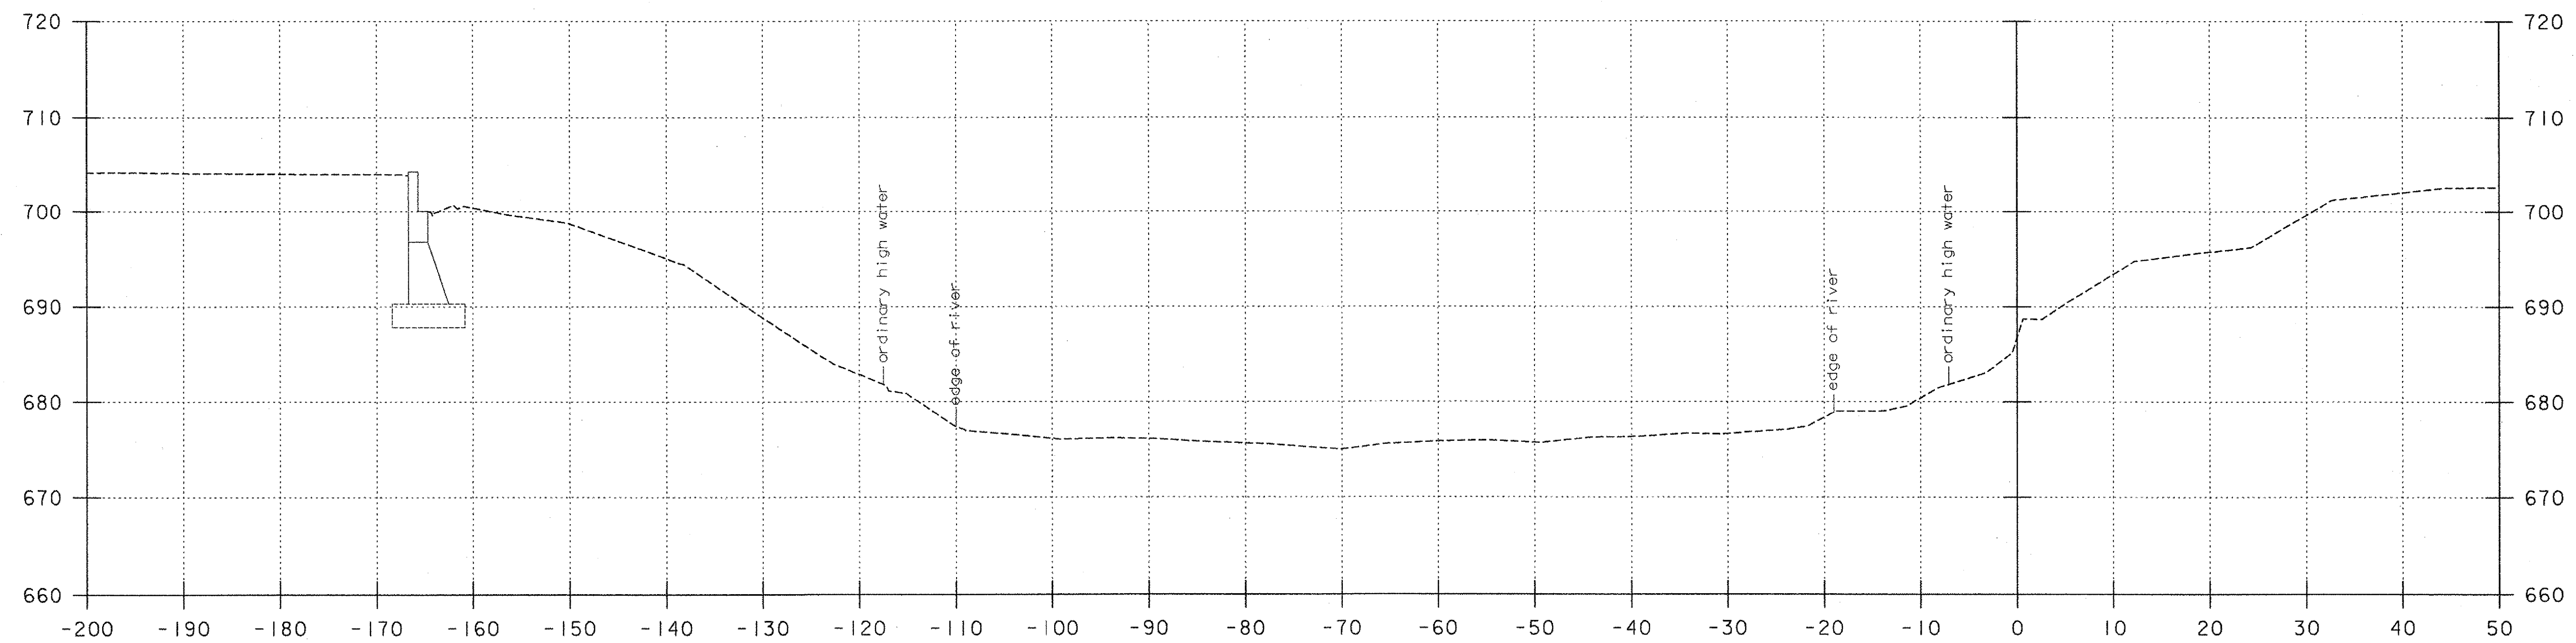

50+25

CHANNEL CROSS SECTIONS

FROM STA 50+25 TO STA 50+50  
 PROJECT NAME WOODSTOCK  
 PROJECT NO. BHF 020-2 (32)  
 SURVEYED BY BRUNO AASSOCIATES, INC.  
 SHEET 69 OF 71

SCALE 1" = 10'

**VHB Vanasse Hangen Brustlin, Inc.**