


51+50

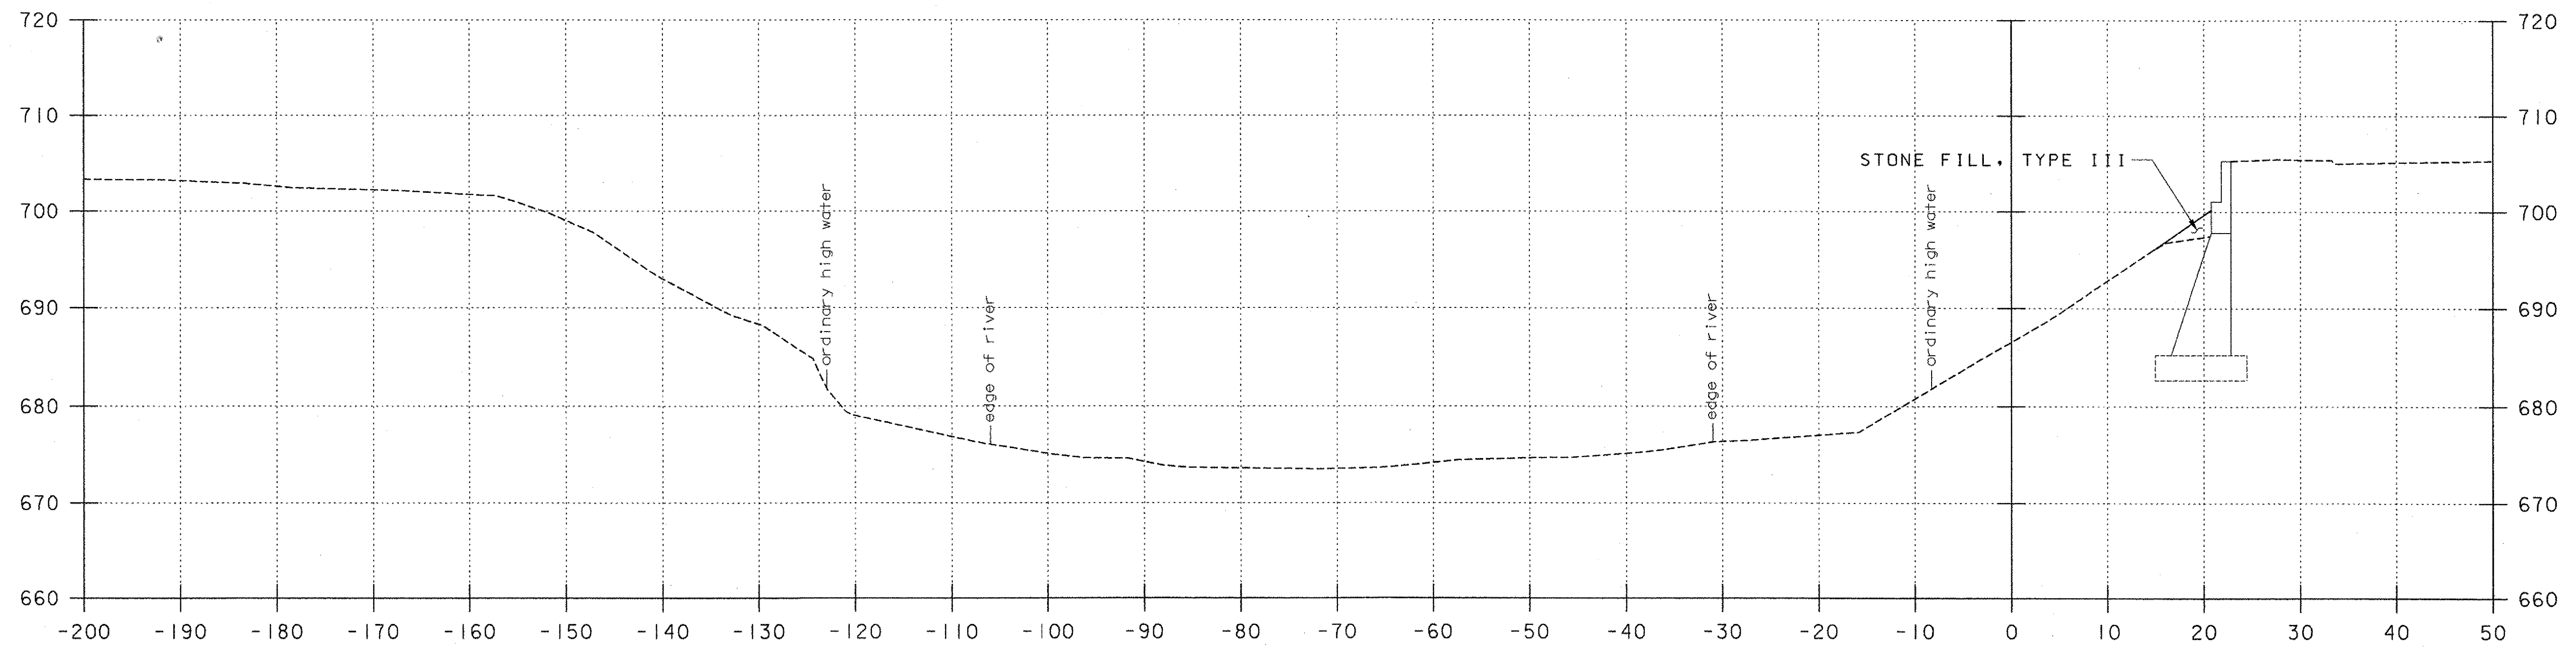

51+25

CHANNEL CROSS SECTIONS

SCALE 1" = 10'

**VHB Vanasse Hangen Brustlin, Inc.**

FROM STA 51+25	TO STA 51+50
PROJECT NAME	WOODSTOCK
PROJECT NO.	BHF 020-2 (32)
SURVEYED BY	BRUNO ASSOCIATES, INC.
SHEET 71 OF 71	