


SECTION B-B

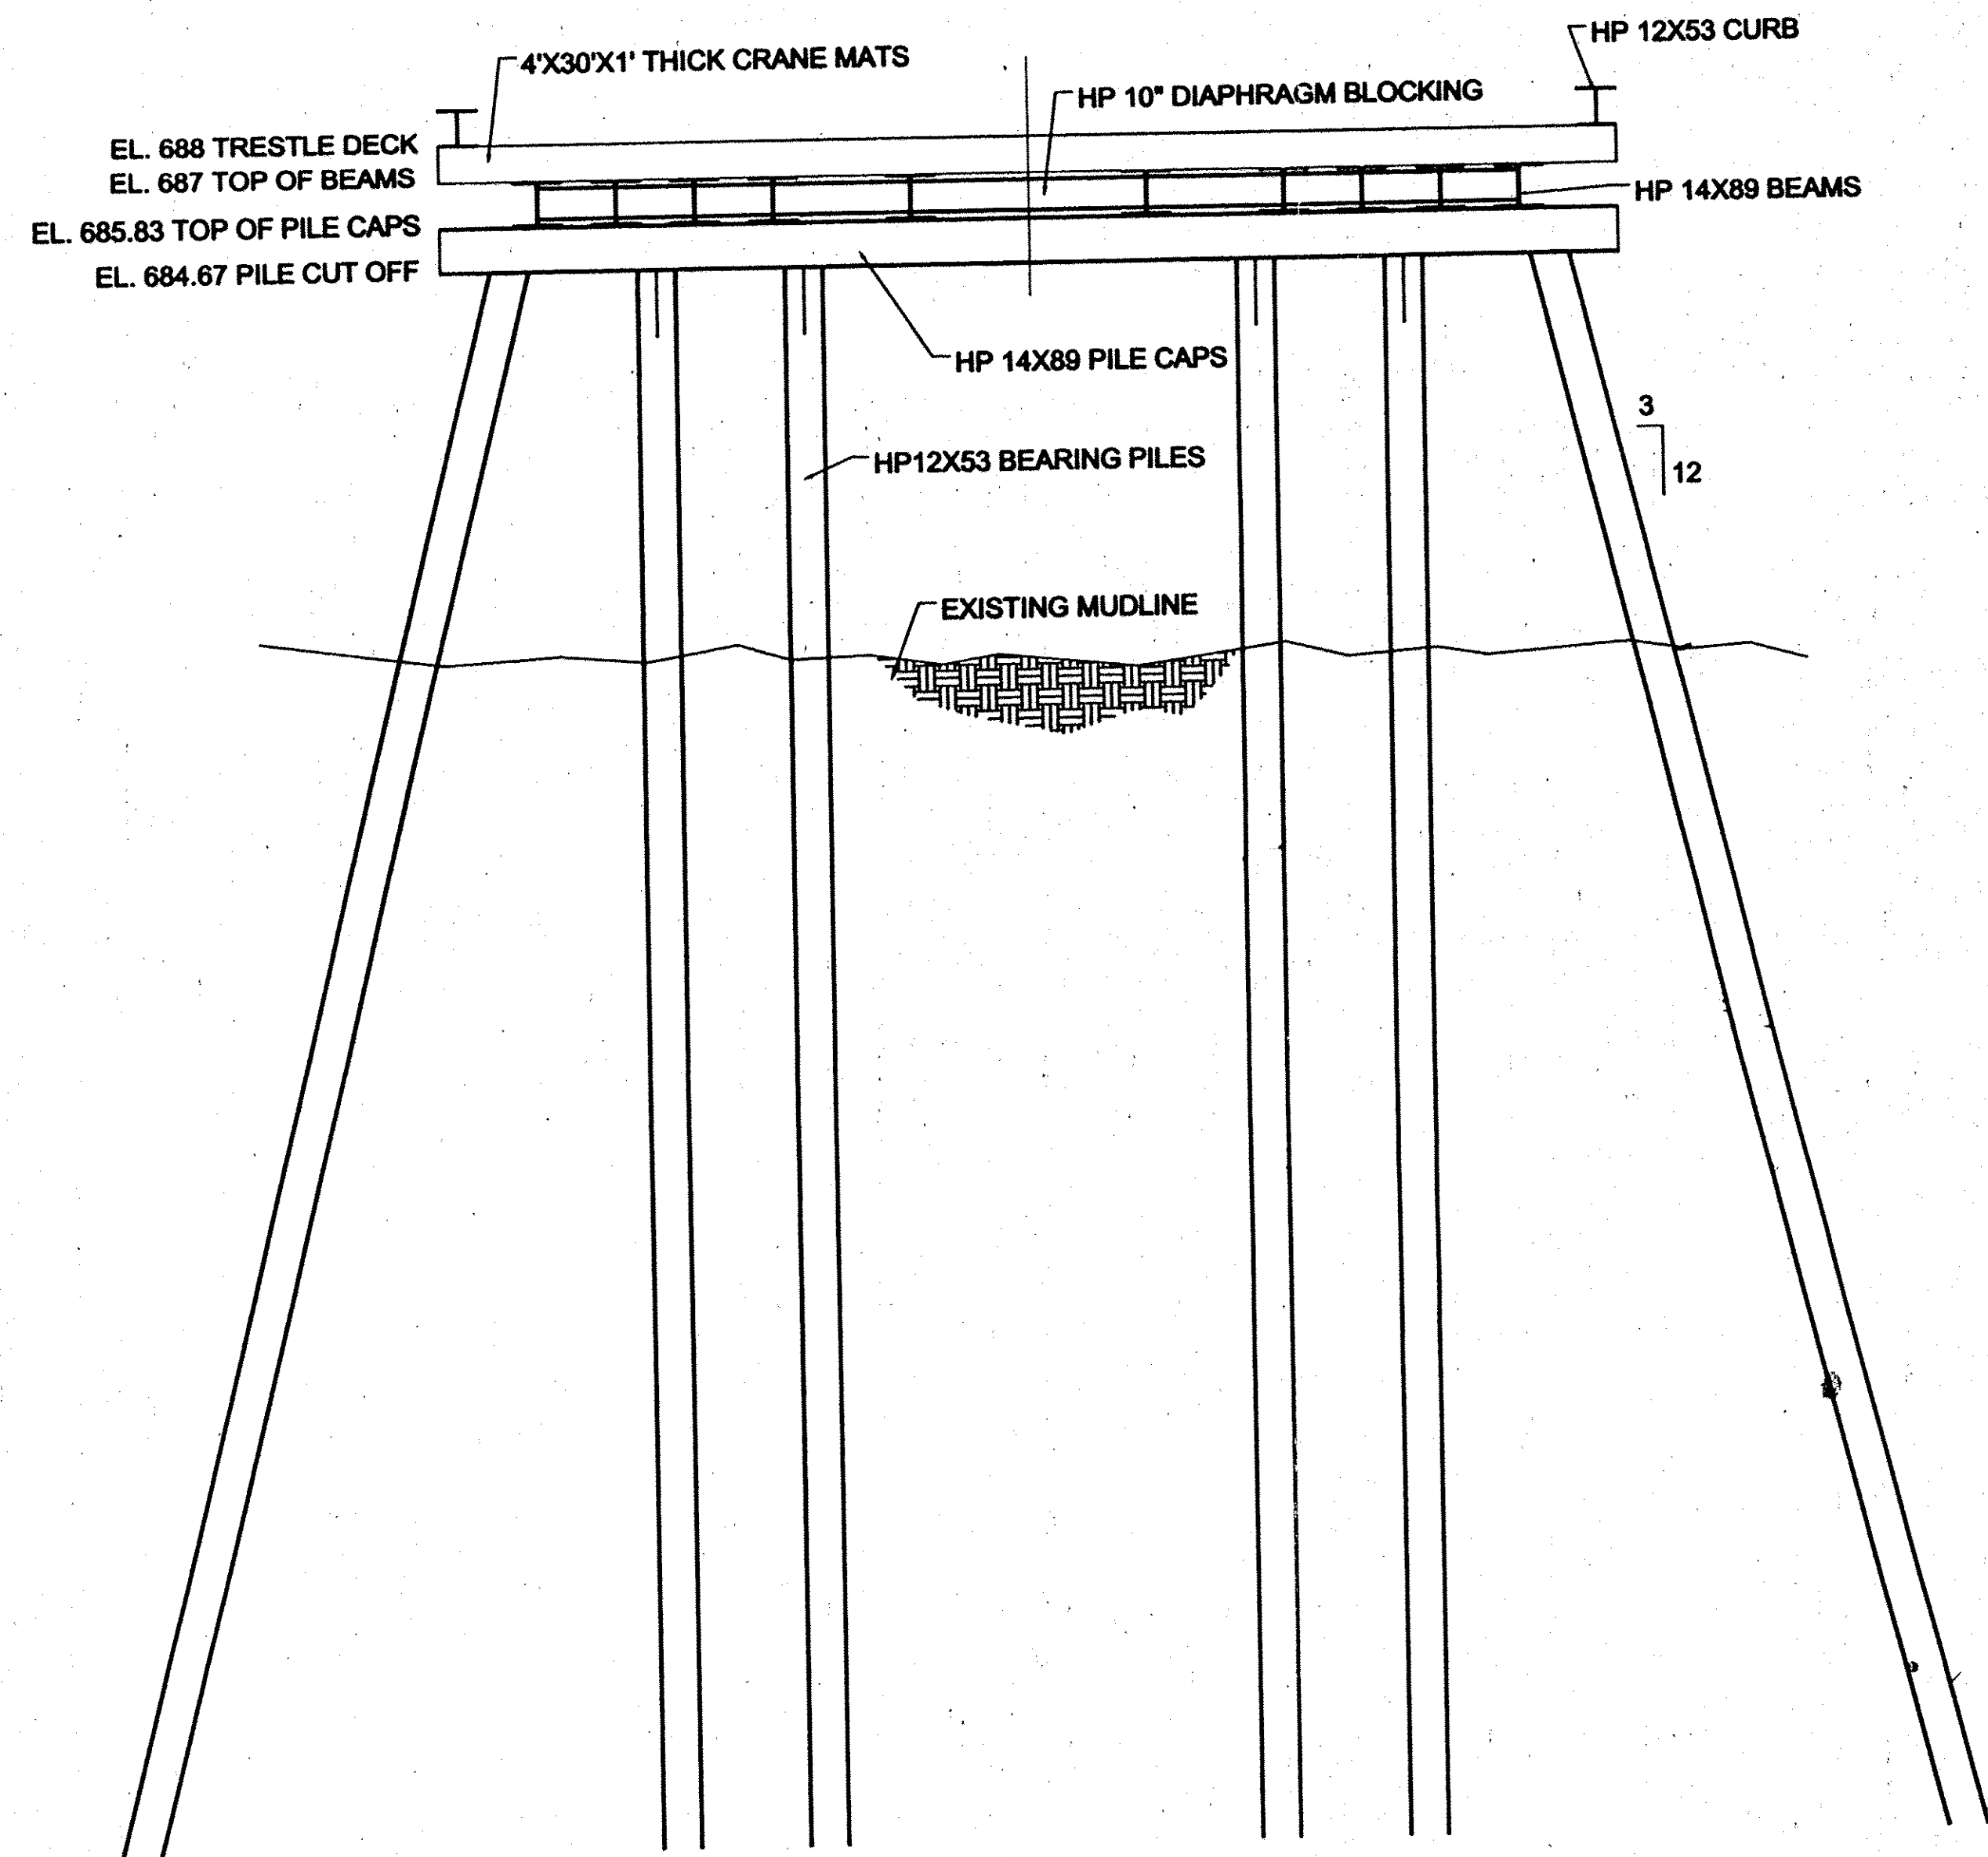

SECTION C-C

H.B. FLEMING 89 PLEASANT AVE. SOUTH PORTLAND, ME 04106 P: 207-799-8514 F: 207-799-8538 www.hbfleming.com	TITLE: DETAILS AND SECTIONS
	PROJECT: RT. 4 BRIDGE TRESTLE
	LOCATION: WOODSTOCK, VT
	DATE: 4/16/07
	SCALE: 1"=5'