


PROJECT NAME _____
 QUALIFIED JOINT WELDING PROCEDURE PROJECT NUMBER _____
 PROCEDURE SPECIFICATION _____

Material specification A36: A572: 65RB
 Welding process FCAW
 Manual or machine SEMI-AUTOMATIC
 Position of welding FLAT for groove welds Horizontal for fillet welds 1G: 2F
 Filler metal specification RHS 5.20
 Filler metal classification ALLOY RODS DUAL SHIELD TI Ti HTR (E71T-1)
 Flux N/A
 Shielding gas CO₂ Flow rate 35 CFH
 Single or multiple pass SINGLE AND MULTIPLE
 Single or multiple arc SINGLE ELECTRICAL STICK-OUT 3/8"-3/4"
 Welding current DC
 Polarity REVERSE
 Welding progression N/A
 Root treatment NONE
 Preheat and interpass temperature 50 to 3/8" THK: 70 to 1/8" THK: 150 to 2 1/2" THK
 Postheat treatment NONE
 Supported temp Q07 and Q08

WELDING PROCEDURE
 DESIGNED BY _____
 DRAWN BY Jux

Pass no.	Electrode size	Welding current		Travel speed (I.P.M.)	Weld size (in)
		Amperes	Volts		
GROOVE WELDS					
1	.045	220-240	26-28	16-18	3/16"
1	.045	220-240	26-28	10-12	1/4"
all	.045	220-240	26-28	14-16	3/16"
FILLET WELDS					
FILLET WELDS SHALL EQUAL 1/4 OF t BUT NOT MORE THAN 3/8"					
SEE PROCEDURE DS-16 FOR PARAMETERS OF FILLET WELDS					

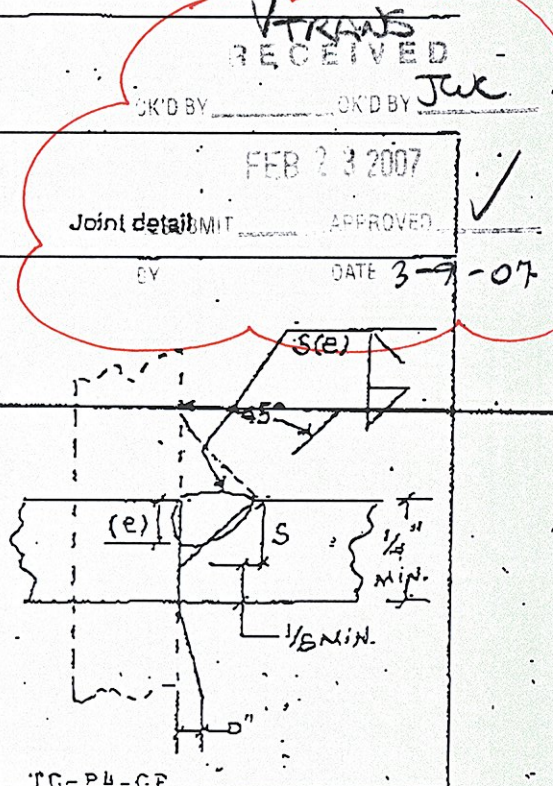

This procedure may vary due to fabrication sequence, fit-up, pass size, etc., within the limitation of variables given in Section 5.

Procedure no. DS-13 Contractor Merrimack Sheet Metal, Inc.
 Revision no. _____ Authorized by Scott Blandette
 Form E-2 Date 1/26/07

RECEIVED
 FEB 23 2007
 APPROVED
 DATE 3-7-07