


L.B. Foster Co.
WELDING PROCEDURE SPECIFICATION

Page 2 of 2
2F AL (AWS 59)

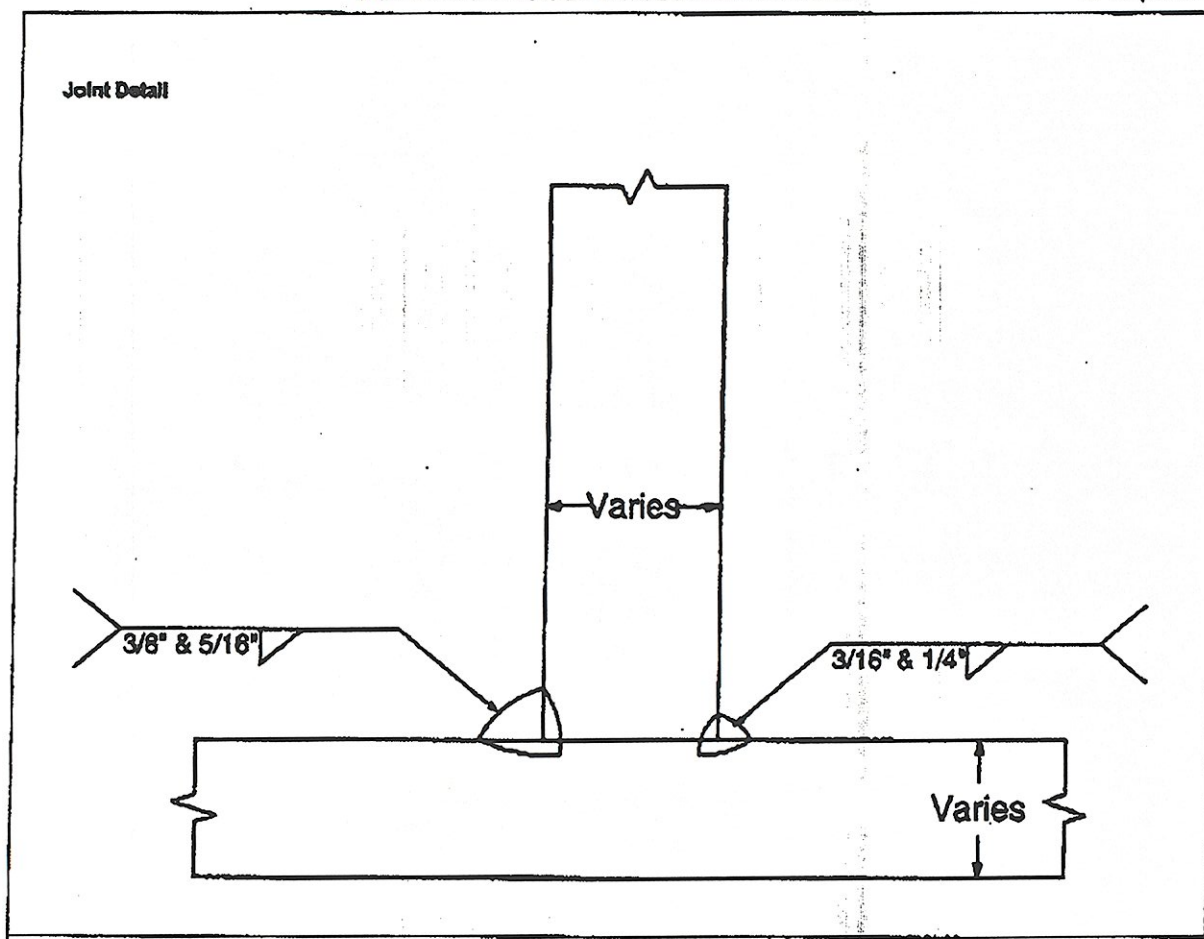

MEMO
Supporting PQRs: PQR AL122, AL-100

TRANS
RECEIVED

CK'D BY _____ OK'D BY JWC

FEB 08 2007

RESUBMIT _____ APPROVED ✓

BY _____ DATE 2-16-07