


SEE SHEET 2 FOR INDEX OF SHEETS

STATE OF VERMONT AGENCY OF TRANSPORTATION



PROPOSED IMPROVEMENT BRIDGE PROJECT TOWN OF BRATTLEBORO COUNTY OF WINDHAM

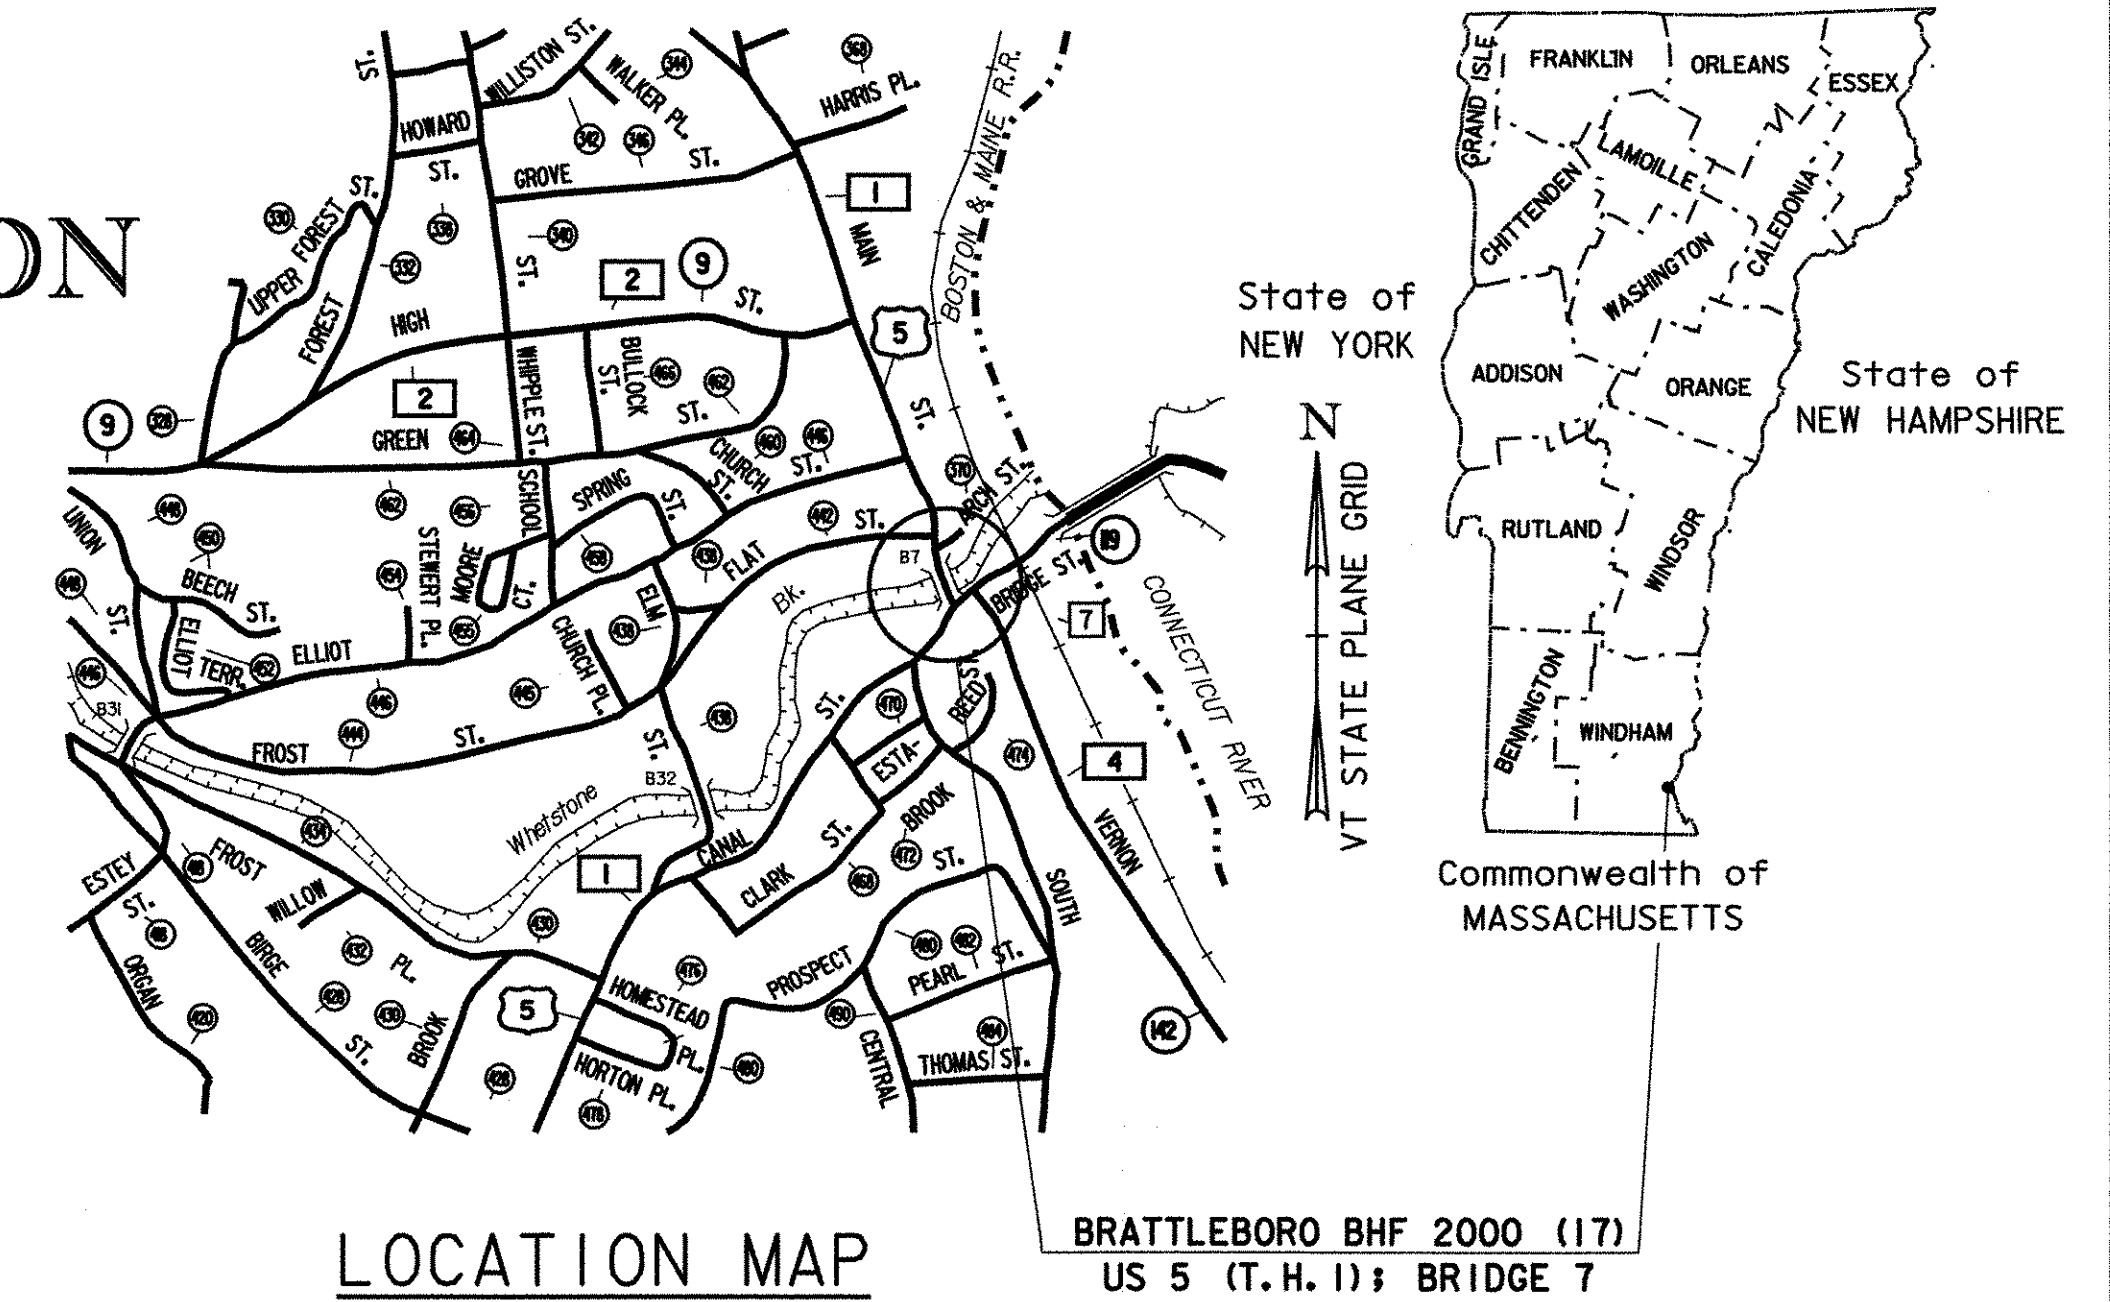


ROUTE NO : US 5 (T. H. 1) BRIDGE NO : 7

PROJECT LOCATION : BEGINNING APPROXIMATELY 0.010 KM FROM THE INTERSECTION OF US 5, VT 119, AND VT 142 AND PROCEEDING NORTHERLY FOR APPROXIMATELY 0.020 KM.

PROJECT DESCRIPTION : THE PROJECT SHALL CONSIST OF THE REHABILITATION OF BRIDGE NO. 7 ALONG WITH RELATED ROADWAY APPROACH WORK.

LENGTH OF STRUCTURE : 20.355 METERS.
LENGTH OF ROADWAY : 0.000 METERS.
LENGTH OF PROJECT : 20.355 METERS.

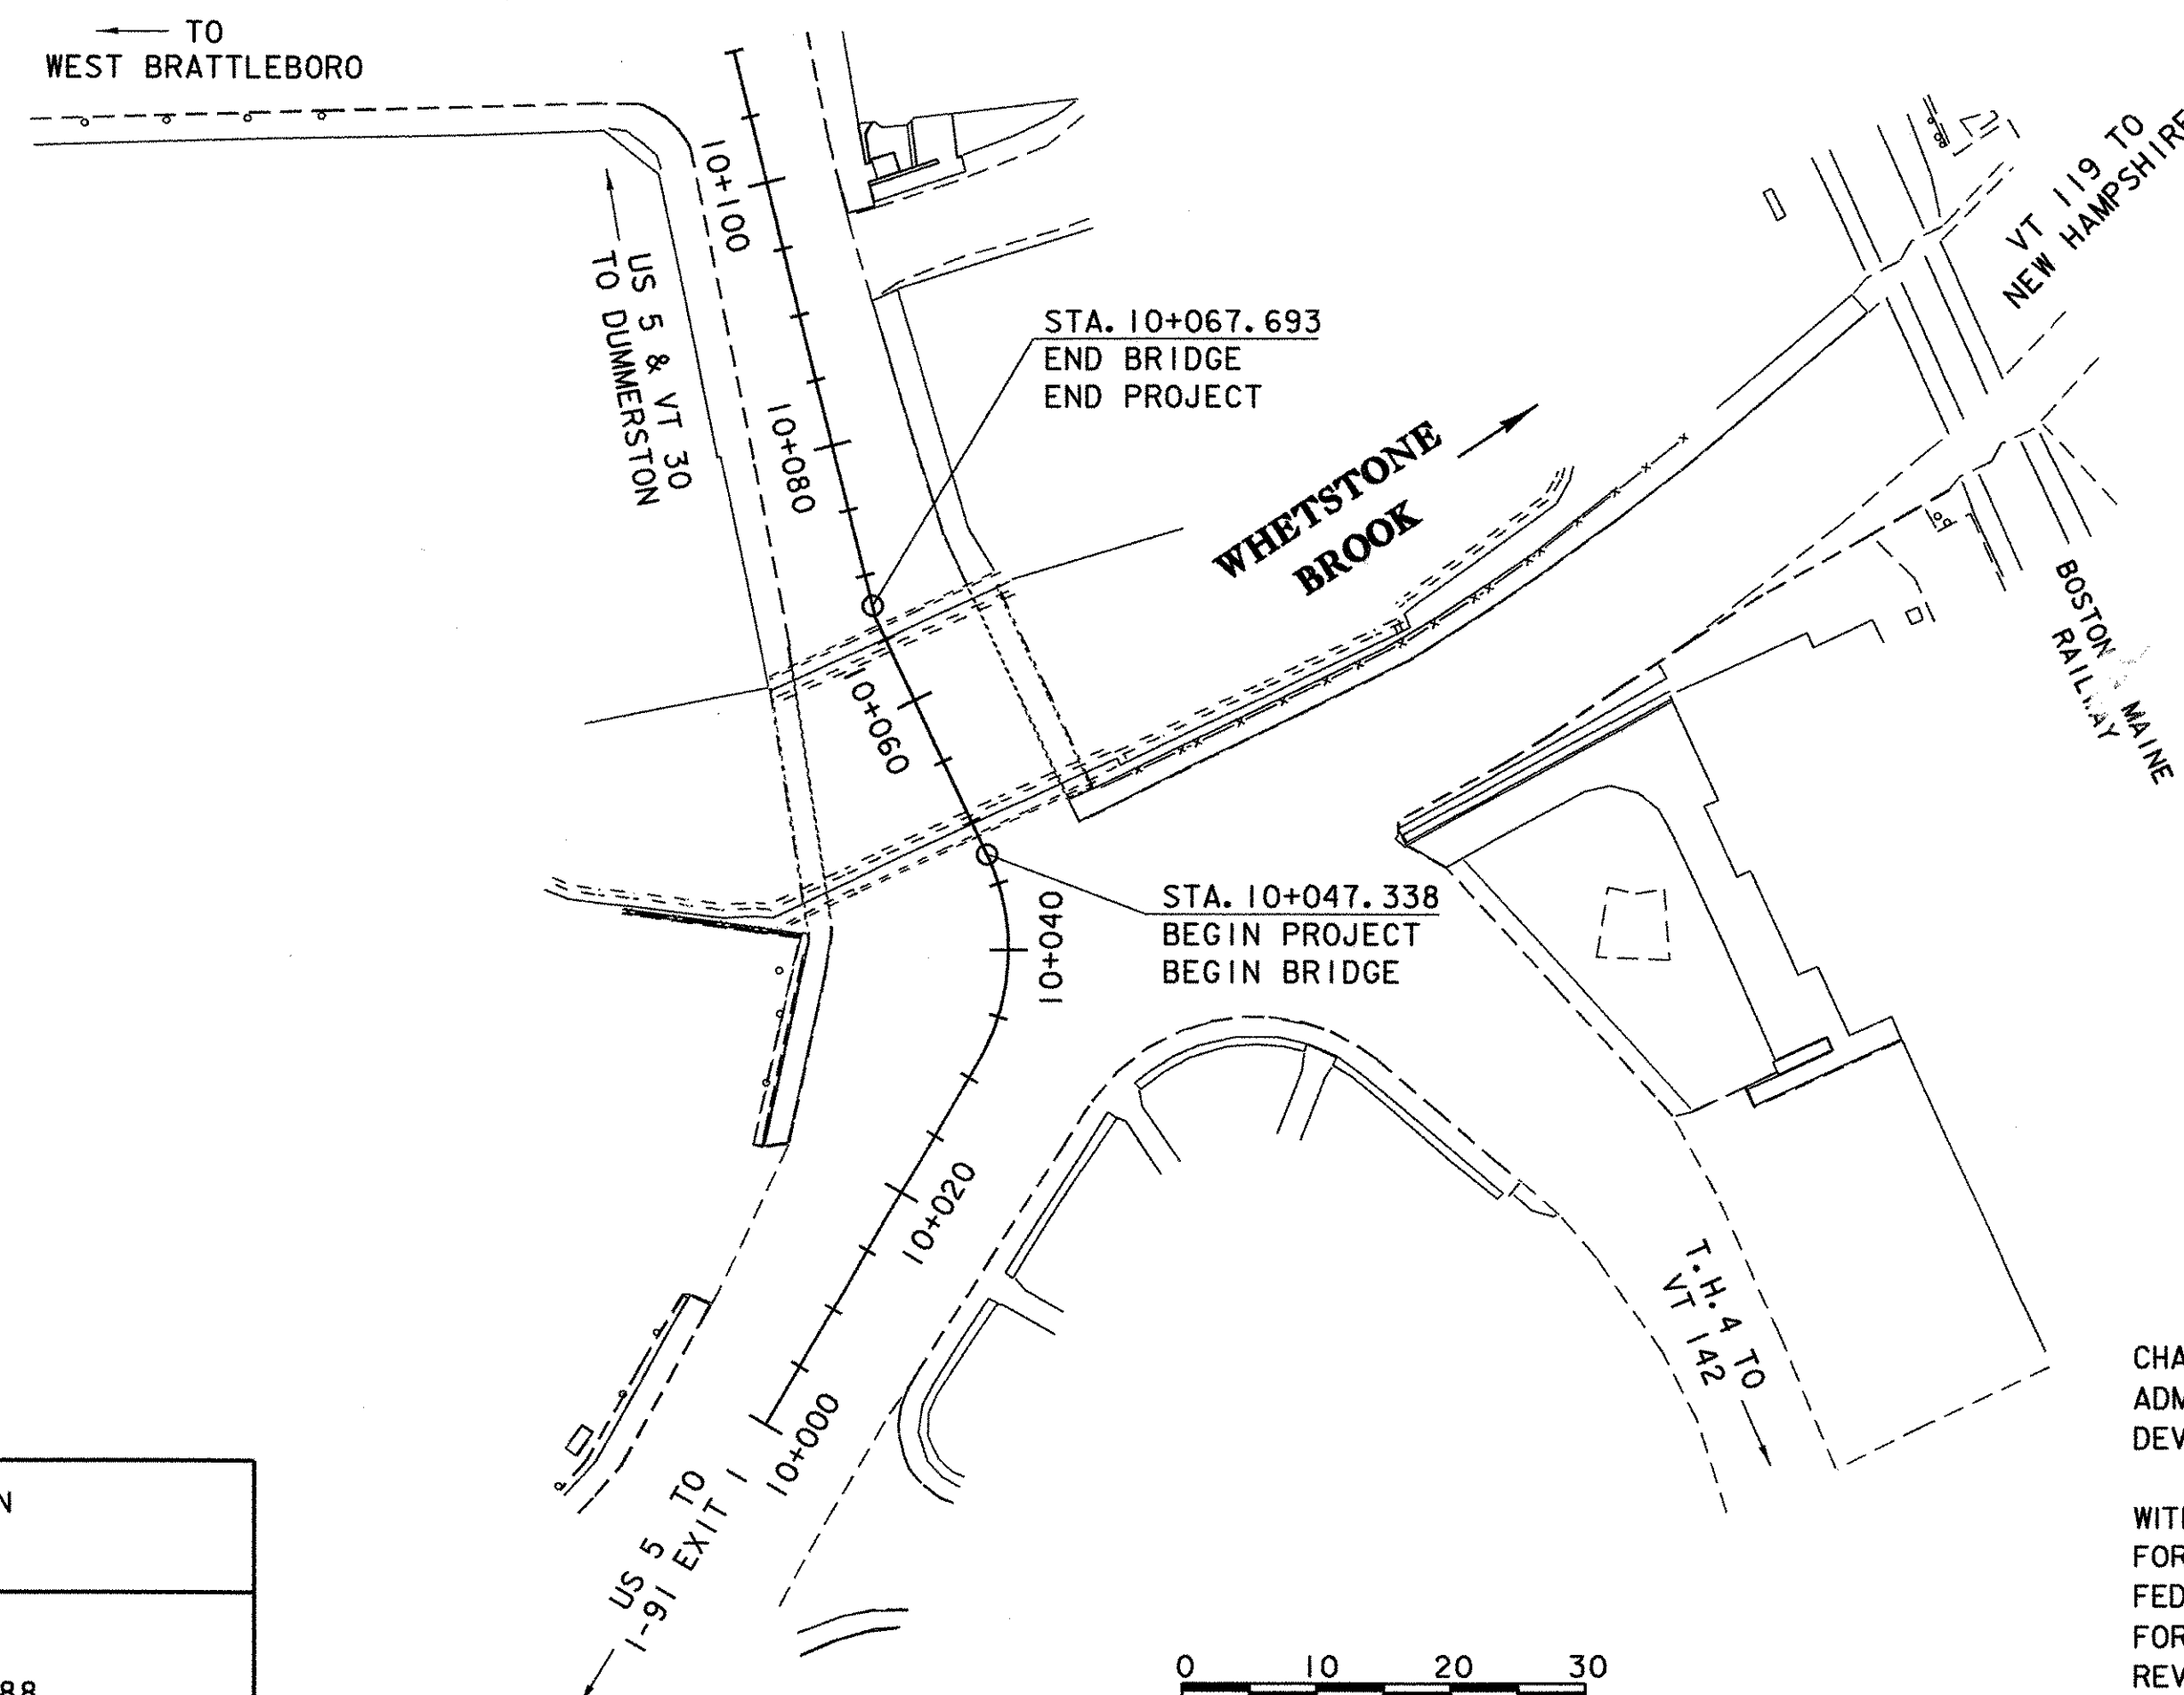

RECORD PLANS	
CONTRACTOR:	RENAUD BROTHERS, INC. - VERNON, VT
RESIDENT ENGINEER:	FRED ROSS
CONSTRUCTION BEGAN:	MAY 6, 2003
CONSTRUCTION COMPLETE:	NOVEMBER 26, 2003
RECORD PLANS BY:	FRED ROSS
I HEREBY CERTIFY THAT ALL THE CONSTRUCTION REQUIRED BY THIS SET OF DRAWINGS HAS BEEN ACCOMPLISHED AS INDICATED HEREIN.	
BY:	<i>Fredrick W. Ross III</i> RESIDENT ENGINEER
DATE:	10-4-05
NOTE: Any further information concerning final quantities, amounts or other details relative to this project may be found at Central Files in the electronic archives.	

CONVENTIONAL SYMBOLS	
COUNTY LINE	
TOWN LINE	
LIMITS OF ACCESS	
POINT OF ACCESS	
FENCE LINE	
STONE WALL	
TRAVELED WAY	
GUARD RAIL	
RAILROAD	
SURVEY LINE	
CULVERT	
POWER POLE	
TELEPHONE POLE	
TREES	
CONTROL OF ACCESS	
PROPERTY LINE	
R.O.W. TAKING LINE	
SLOPE RIGHTS	
TOP OF CUT	
TOE OF SLOPE	

SURVEYED BY : R. GILMAN
SURVEYED DATE : 6/96

DATUM
VERTICAL NAVD 88
HORIZONTAL NAD 83 (92)

THESE PLANS ARE SUBJECT TO SUCH ENGINEERING CHANGES AS MAY BE REQUIRED BY THE FEDERAL HIGHWAY ADMINISTRATION OR THE DIRECTOR OF PROJECT DEVELOPMENT.

CONSTRUCTION IS TO BE CARRIED ON IN ACCORDANCE WITH THESE PLANS AND THE STANDARD SPECIFICATIONS FOR CONSTRUCTION DATED 2001, AS APPROVED BY THE FEDERAL HIGHWAY ADMINISTRATION ON JANUARY 4, 2001 FOR USE ON THIS PROJECT, INCLUDING ALL SUBSEQUENT REVISIONS AND SUCH REVISED SPECIFICATIONS AND SPECIAL PROVISIONS AS ARE INCORPORATED IN THESE PLANS.

941078\structures\sj078tit.dgn sj078tit.i 08-SEP-2005

Metric

UNLESS NOTED OTHERWISE
STATIONS ARE IN KILOMETERS
ELEVATIONS ARE IN METERS
DIMENSIONS ARE IN MILLIMETERS

DIRECTOR OF PROJECT DEVELOPMENT	APPROVED _____ DATE _____
PROJECT MANAGER : R. R. WHITCOMB	
PROJECT NAME : BRATTLEBORO	
PROJECT NUMBER : BHF 2000 (17)	
SHEET 1 OF 71 SHEETS	