

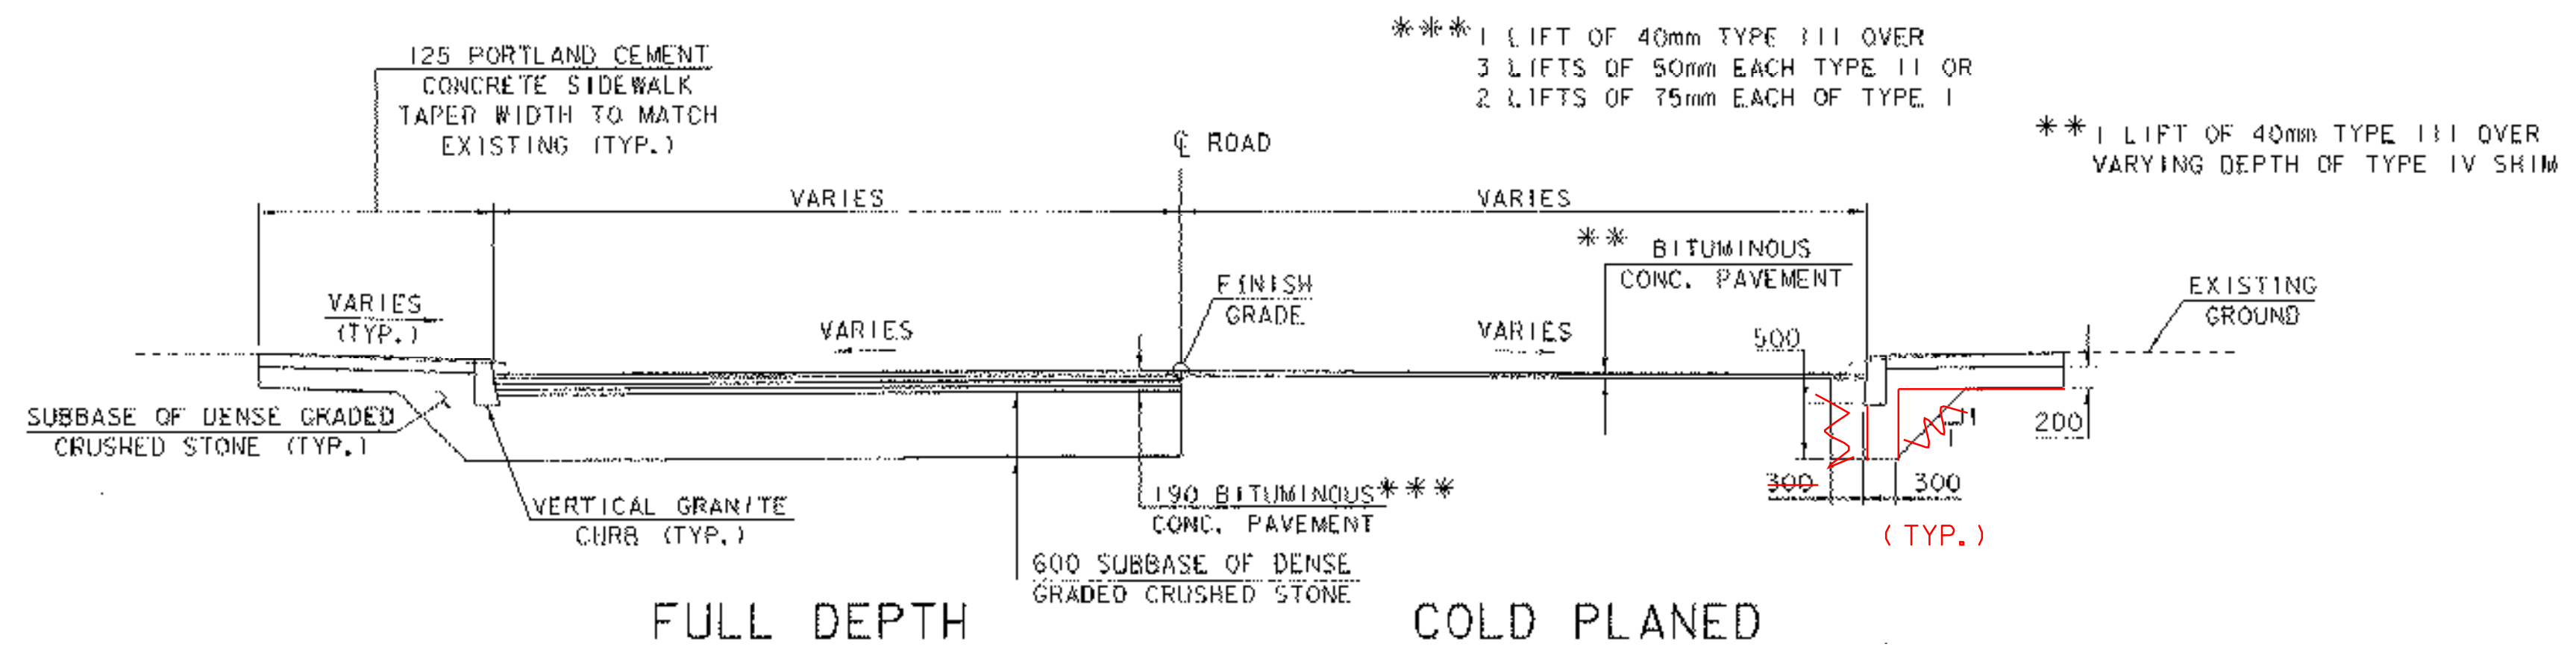
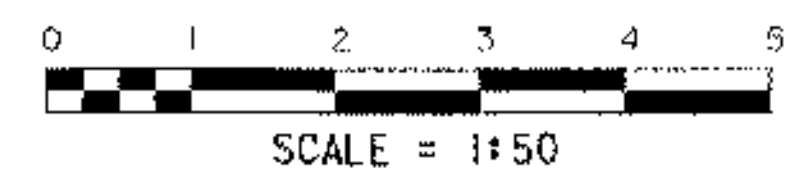




BRIDGE TYPICAL SECTION @ MIDSPAN

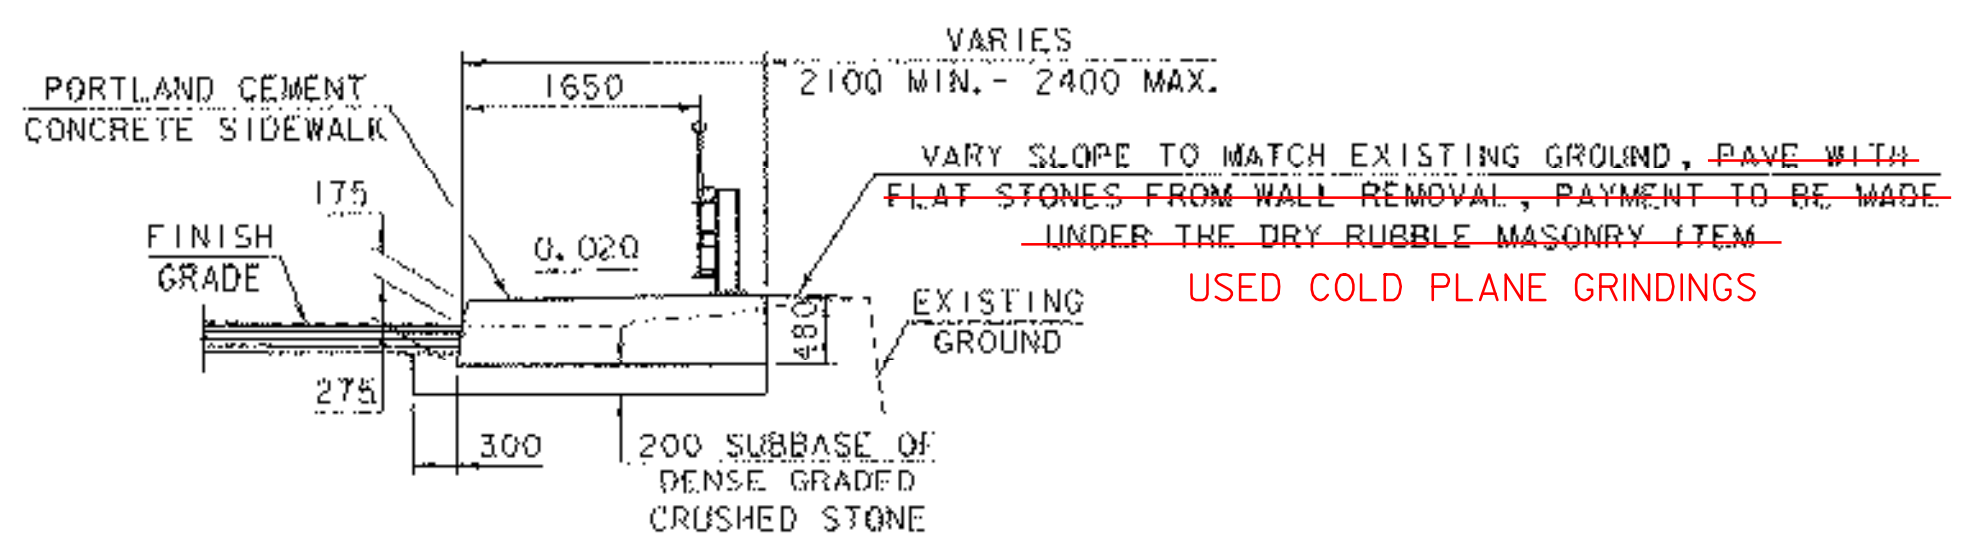


FULL DEPTH ROADWAY APPROACH SECTION

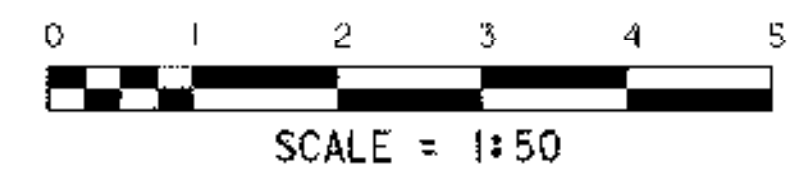

SIDEWALK TYPICAL SECTION  
STA. 20+020.20 RT. - STA. 20+040.26 RT.

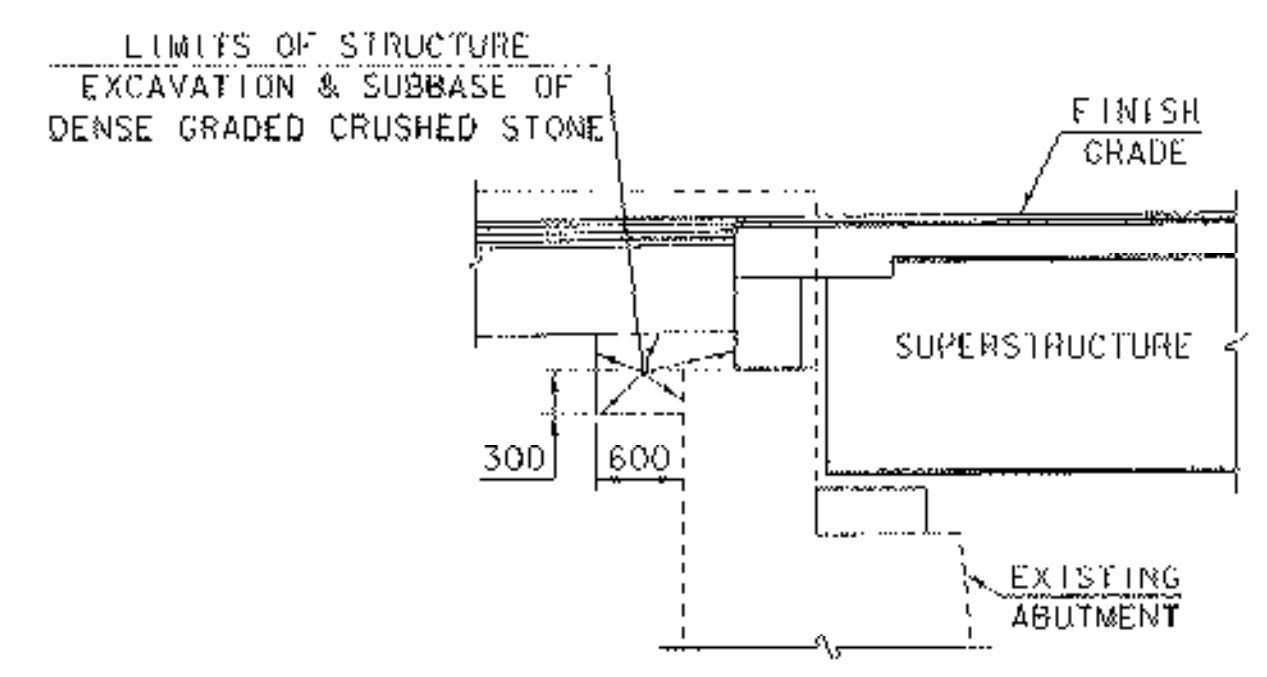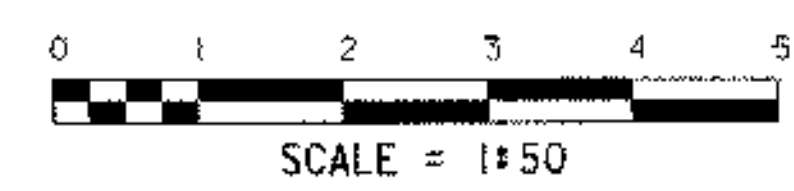

ABUTMENT TYPICAL SECTION

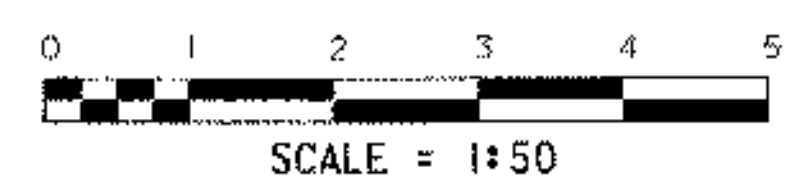

MATERIAL ITEM	TOLERANCE
PAVEMENT	±5 mmr TOTAL THICKNESS
BASE COURSE	±10 mm
SUBBASE	±30 mm
SAND BORROW	±30 mm

PROJECT TYPICAL SHEET

PROJECT NAME:	BRATTLEBORO	FILE NAME:	94\078\Structures\sj078typ.l	PLOT DATE:	06-FEB-2003
PROJECT NUMBER:	BHF 2000 (17)	PROJECT MANAGER:	R.R. WHITCOMB	DRAWN BY:	G. ROY
		DESIGNED BY:	T. SUMNER	CHECKED BY:	T. SUMNER
					SHEET 3 OF 71