



**PHASE ONE
ABUTMENT NO. 1**
(LOOKING BACK STATION)
(ALONG CENTERLINE OF BEARING)

INDICATES REMOVAL OF EXISTING BRIDGE.

INDICATES EXISTING SIDEWALK AND BRACING REMOVED BY PREVIOUS CONTRACT WITH VERIZON.

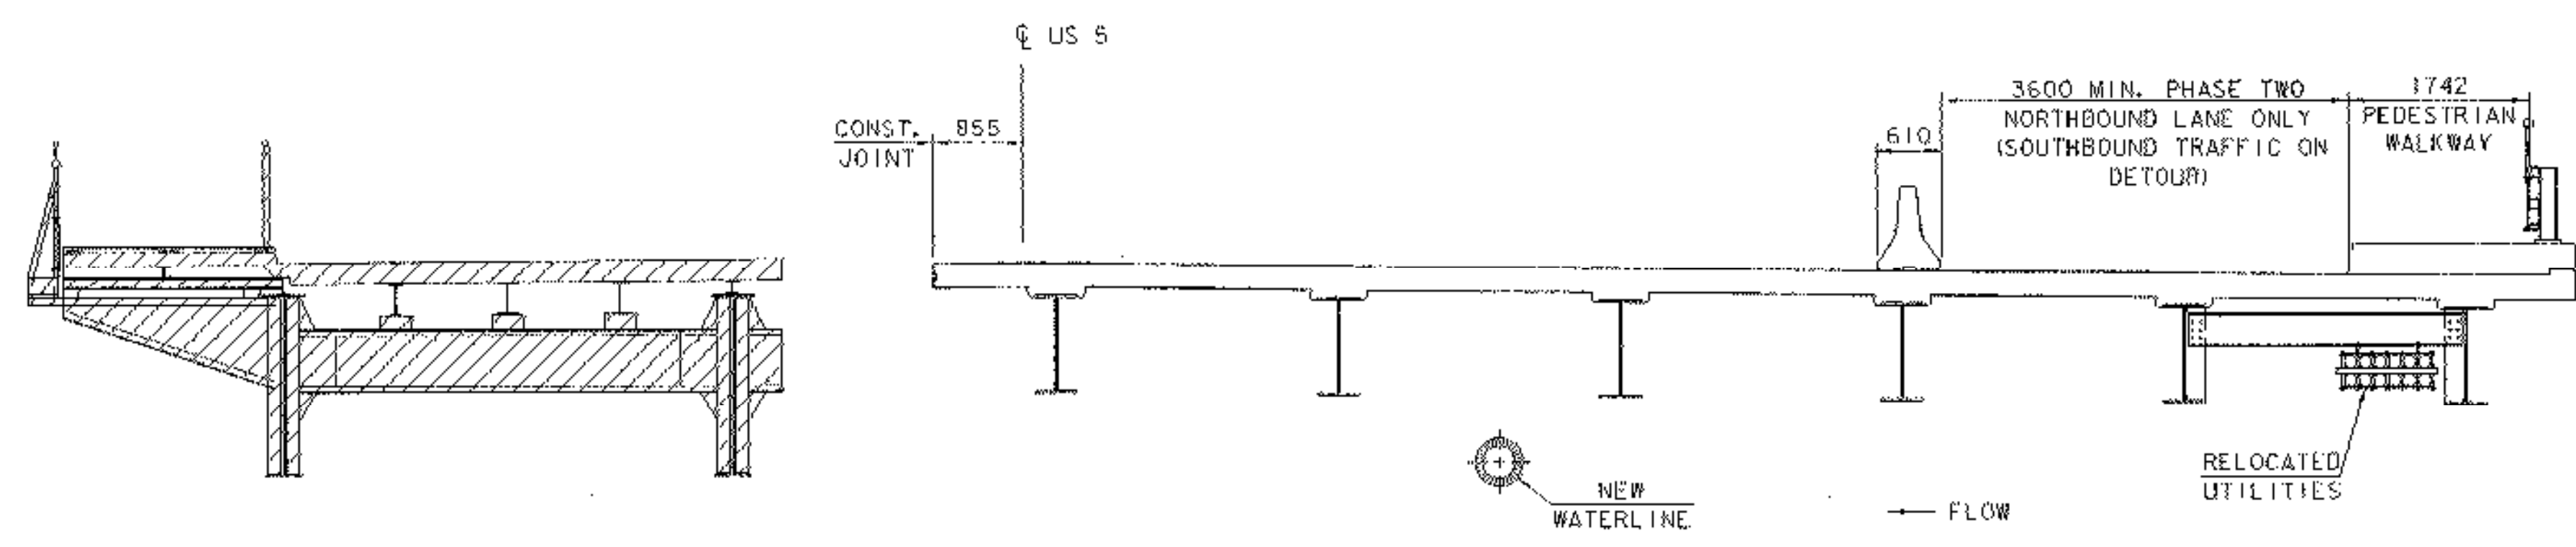


**PHASE ONE TO PHASE TWO
ABUTMENT NO. 1**
(LOOKING BACK STATION)
(ALONG CENTERLINE OF BEARING)

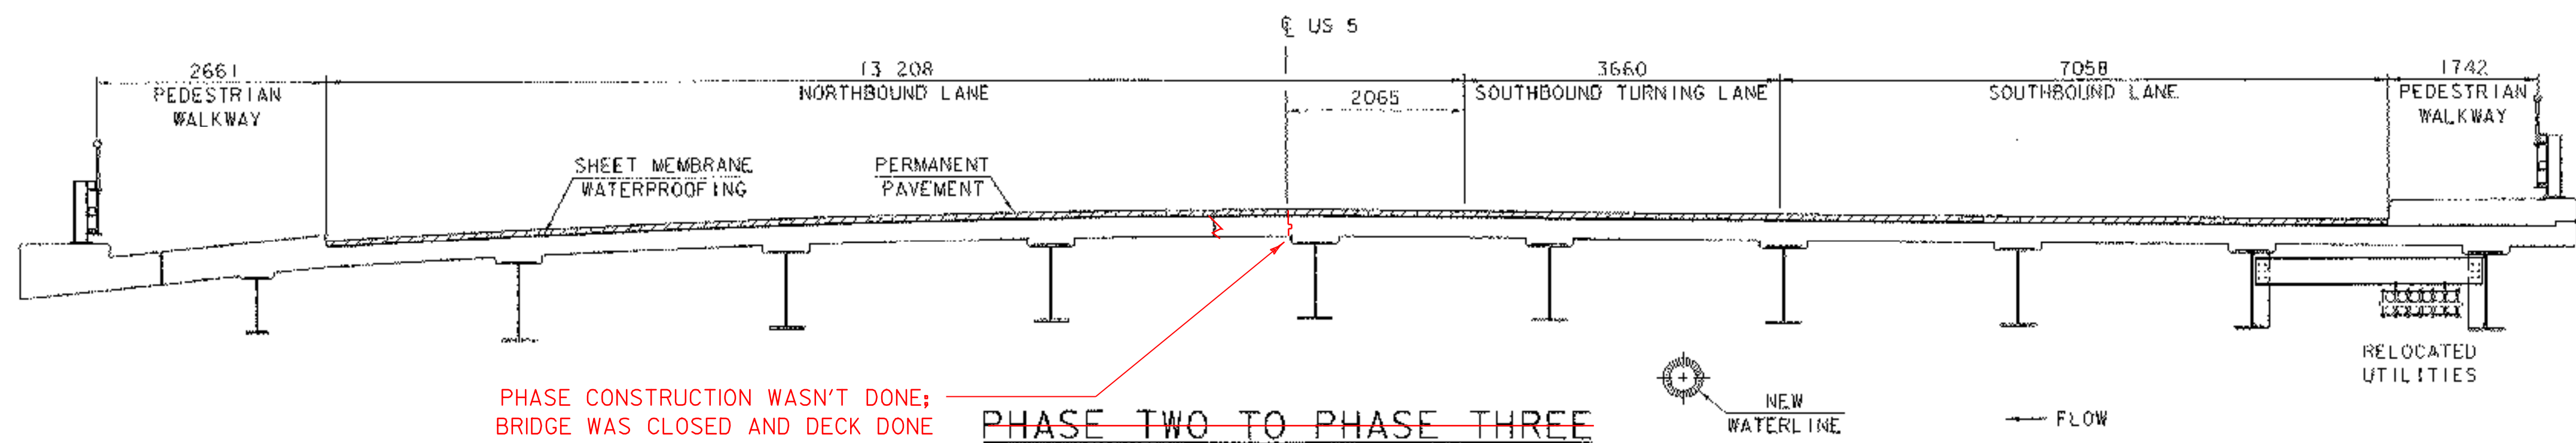

PHASE CONSTRUCTION WASN'T DONE;
BRIDGE WAS CLOSED AND DECK DONE
IN 2 POURS WITH CONSTRUCTION
JOINT @ CL (SEE CO #1, DATED 5-28-03)

**PHASE TWO TO PHASE THREE
ABUTMENT NO. 1**
(LOOKING BACK STATION)
(ALONG CENTERLINE OF BEARING)

**PHASE CONSTRUCTION DETAILS
AT ABUTMENT NO. 1**

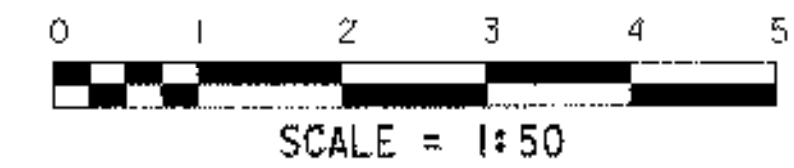

PROJECT NAME:	BRATTLEBORO	PLOT DATE:	06-FEB-2003
PROJECT NUMBER:	BHF 2000 (17)	DRAWN BY:	G. ROY
FILE NAME:	941078\Structures\sj078pod1	CHECKED BY:	T. SUMNER
PROJECT MANAGER:	R. R. WHITCOMB	SHEET	6 OF 71
DESIGNED BY:	T. SUMNER		