

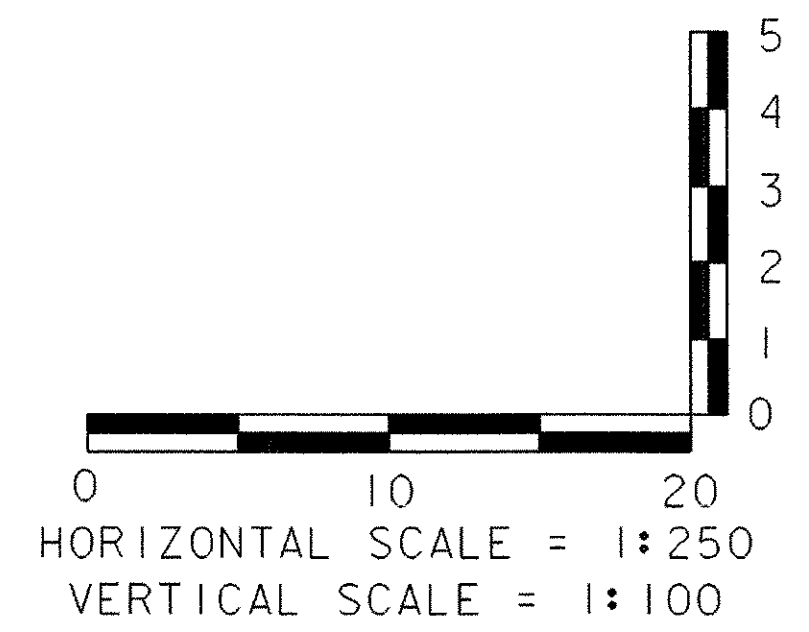
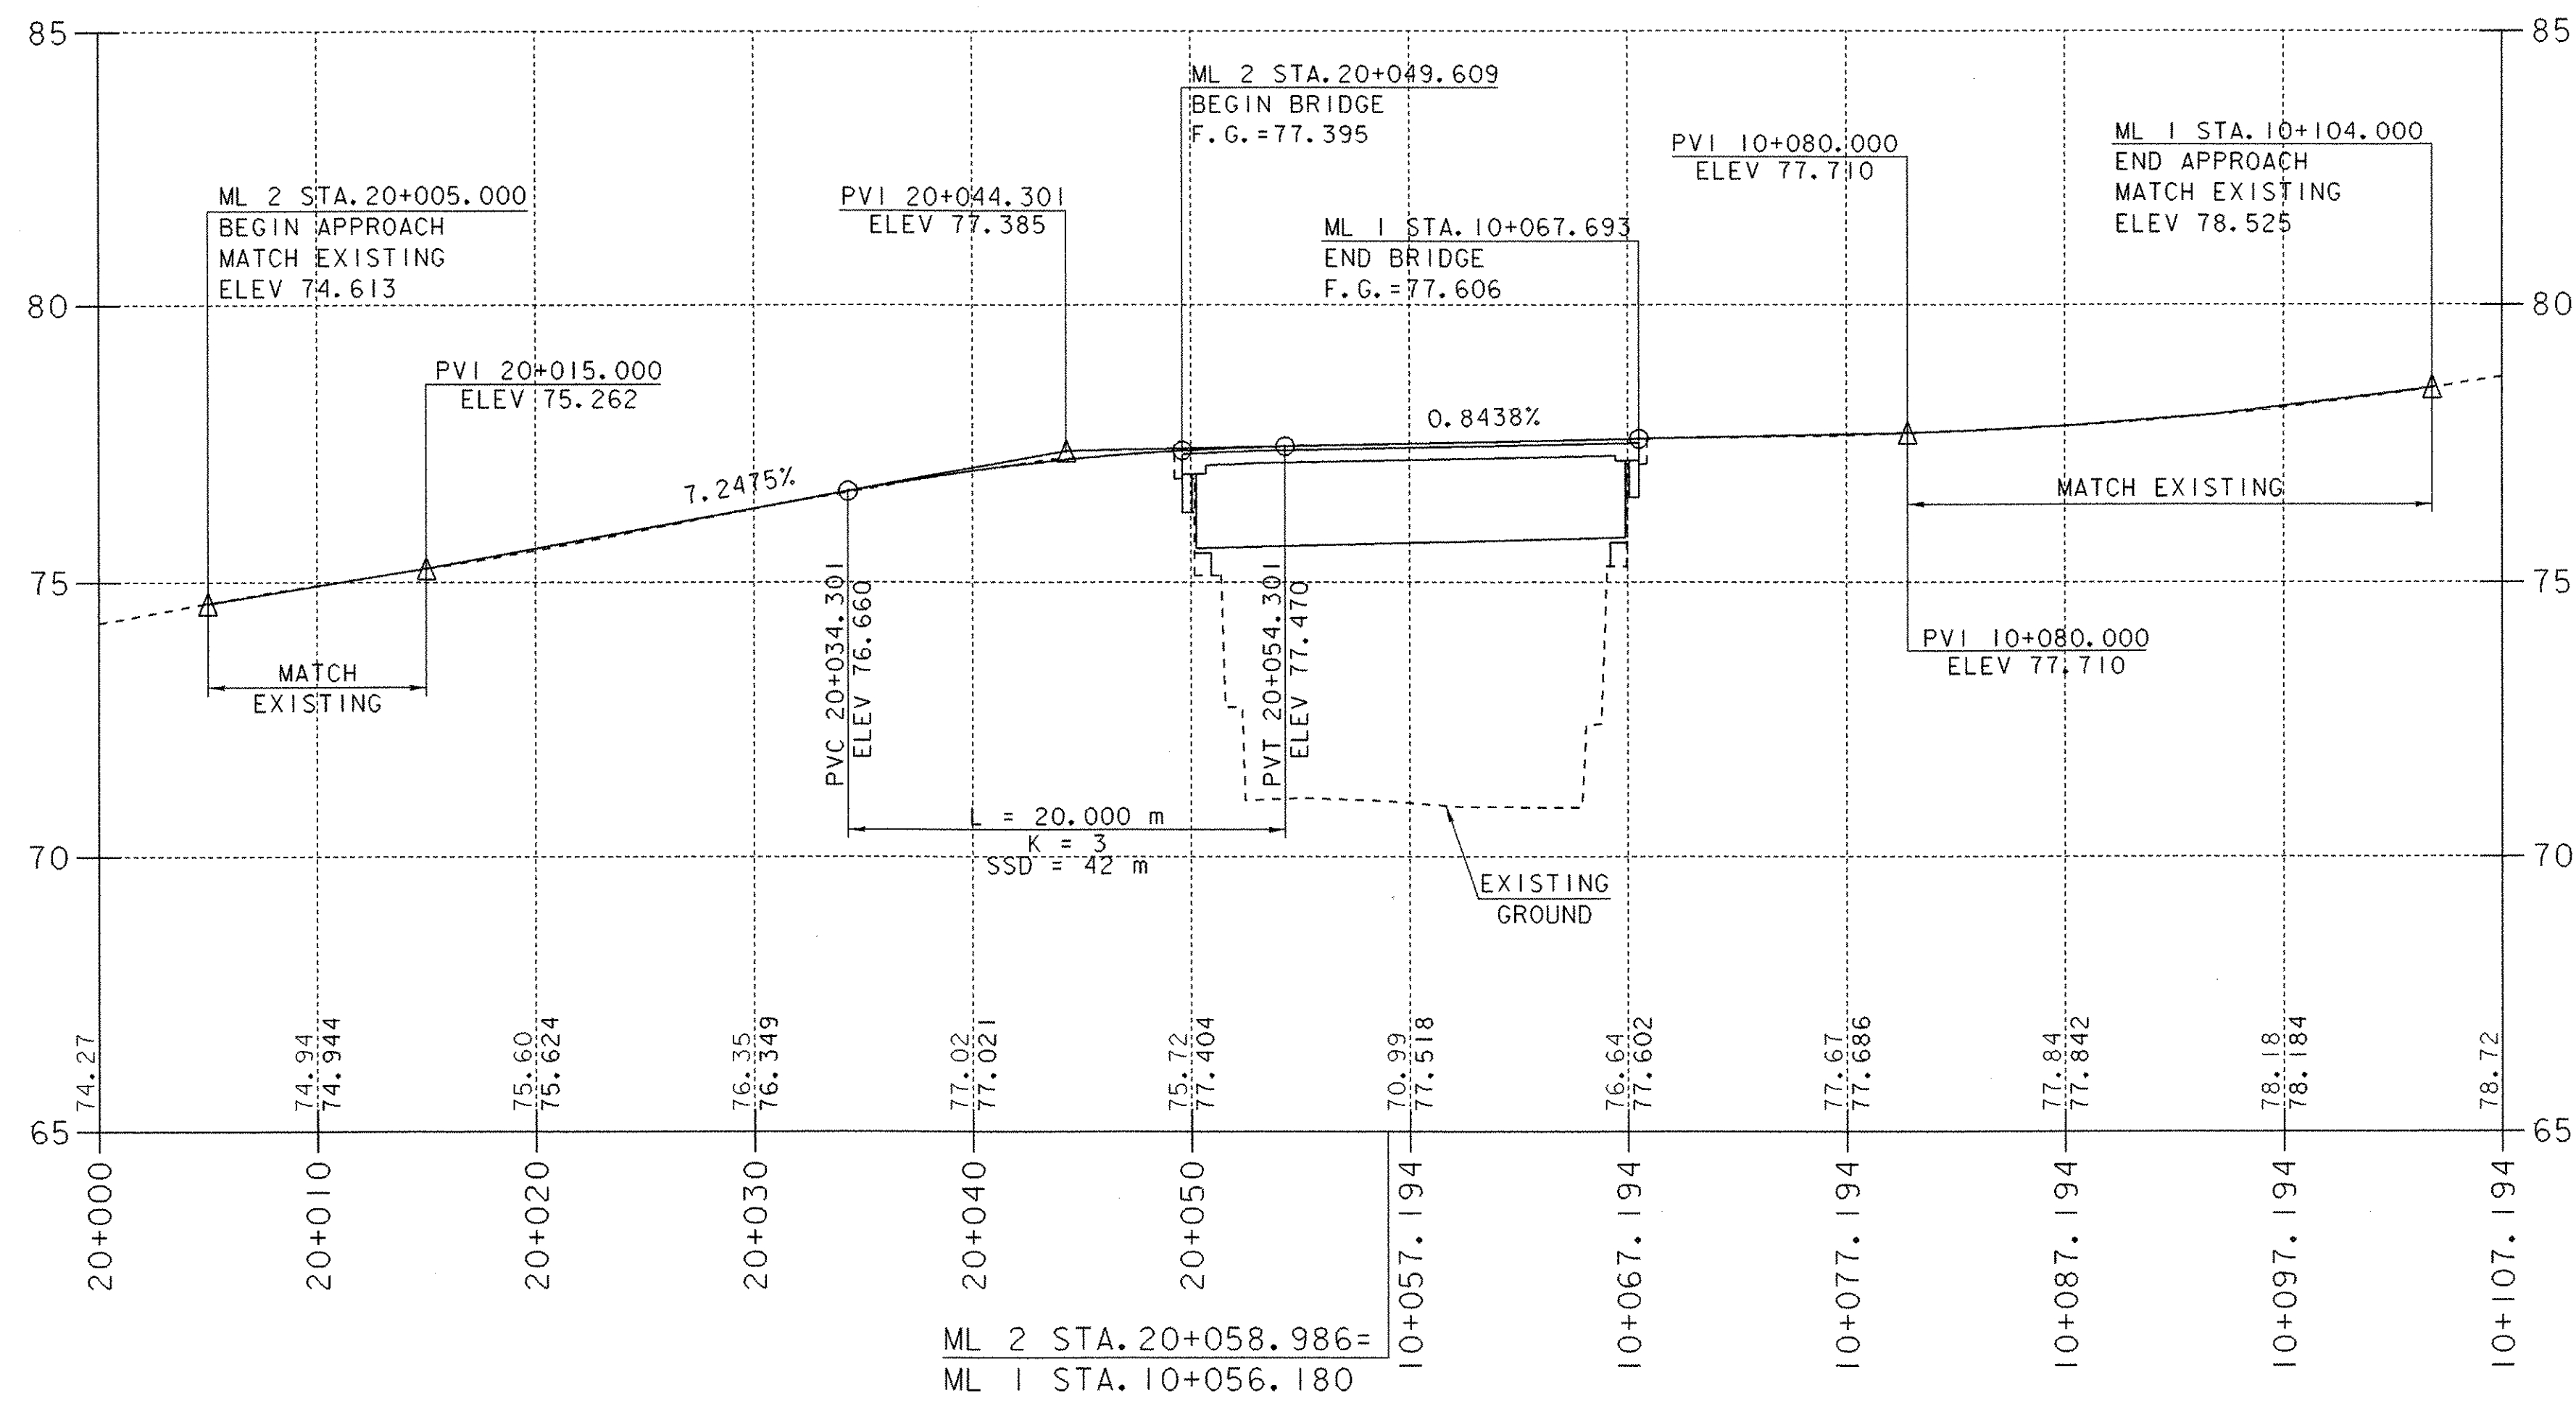


### Profile Along Center Line Bridge St. to Main St.

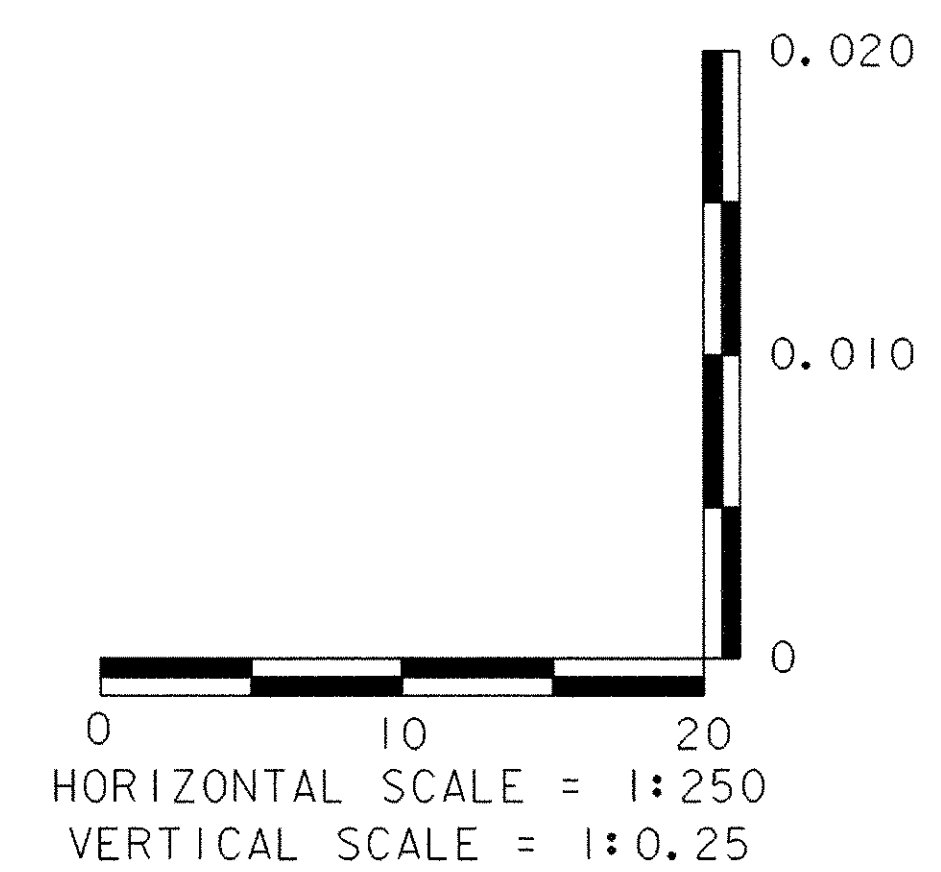

NOTE:  
 ELEVATIONS TO THE NEAREST HUNDREDTH ARE  
 EXISTING GROUND ALONG PROPOSED CENTERLINE.  
 ELEVATIONS TO THE NEAREST THOUSANDTH ARE  
 FINISH GRADE ALONG PROPOSED CENTERLINE.

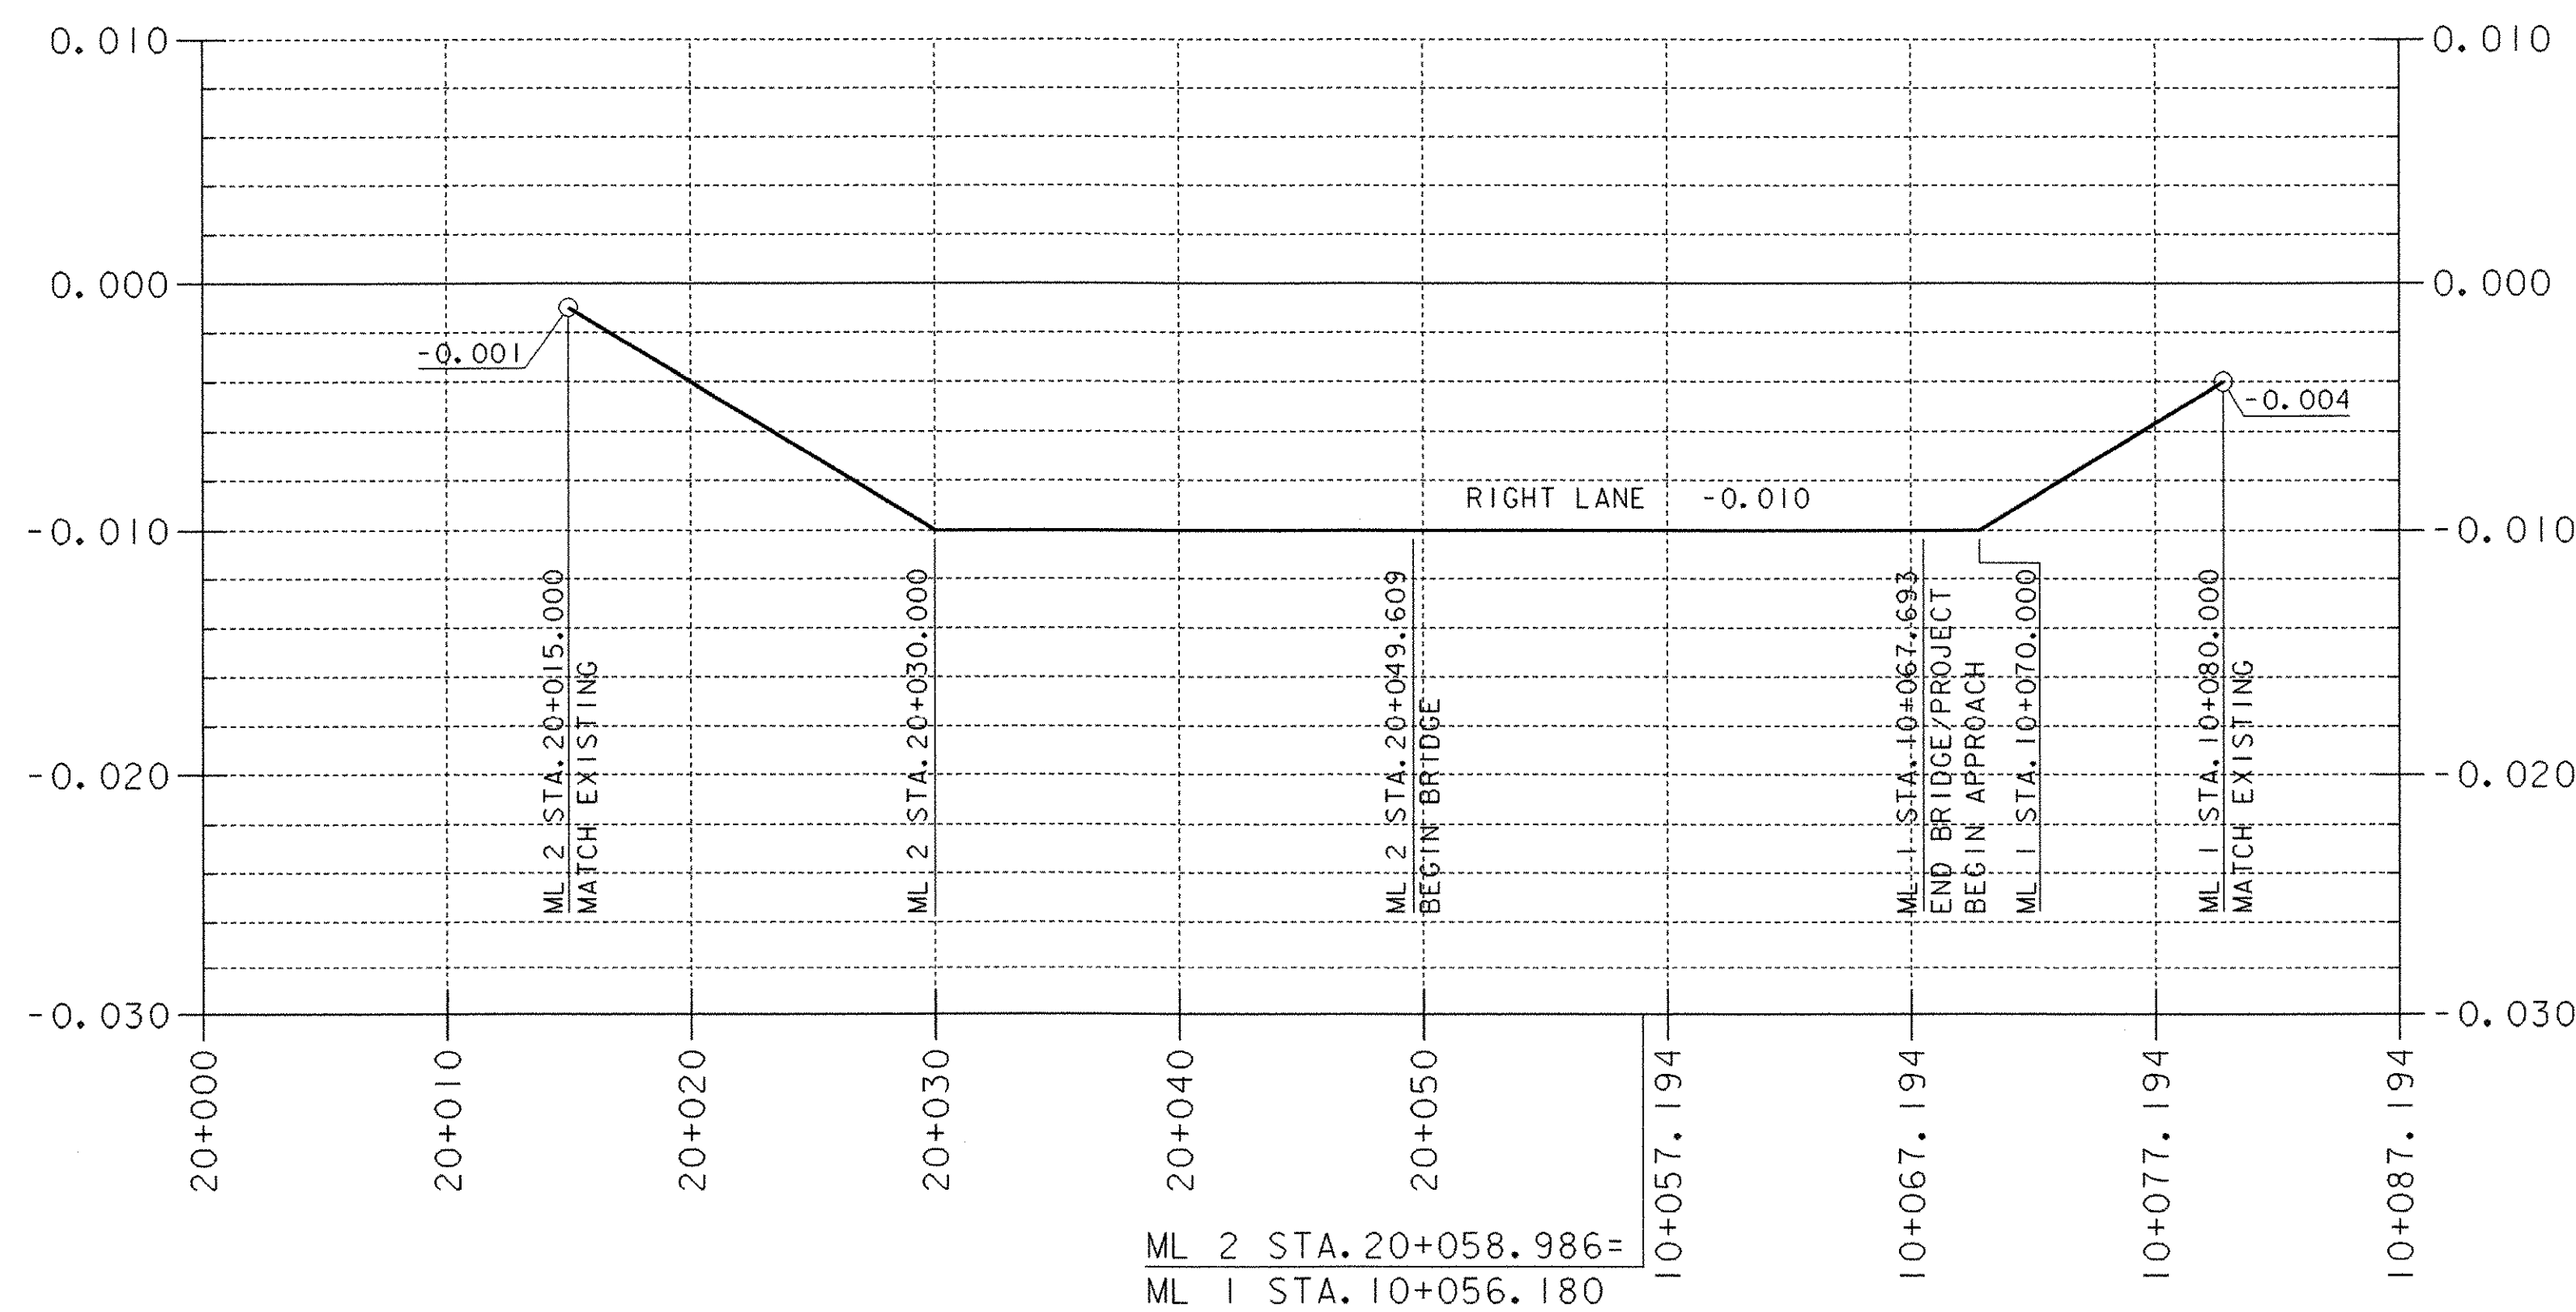

### PROFILE & BANKING DIAGRAM (2)

PROJECT NAME:	BRATTLEBORO
PROJECT NUMBER:	BHF 2000 (17)
FILE NAME:	94J078\Structures\sj078pf2.1
PROJECT MANAGER:	R. R. WHITCOMB
DESIGNED BY:	G. ROY
PLOT DATE:	06-FEB-2003
DRAWN BY:	G. ROY
CHECKED BY:	T. SUMNER
SHEET	11 OF 71

Banking Diagram For Right Travel Lane - Bridge St. to Main St.