

- TEMPORARY TRAFFIC BARRIER**
10+029.7 LT. - 20+014.9 RT.
- TEMPORARY 100mm YELLOW LINE**
9+980.0 LT. - 10+011.6 LT. (DOUBLE)
20+003.2 LT. - 20+037.8 LT. (DOUBLE)
② CANAL ST. 10.4m (DOUBLE)
- TEMPORARY 100mm WHITE LINE**
9+984.4 RT. - 10+016.7 RT. TRAVEL LANE
10+019.1 LT. - 10+029.7 LT. EDGE LINE
10+090.0 RT. - 10+102.6 RT. EDGE LINE
19+986.1 RT. - 20+021.2 RT. EDGE LINE
② CANAL ST. 13.7m DOTTED LINE

- TEMPORARY 600mm STOP BAR**
20+038.2 LT. - 20+038.8 LT.

- TEMPORARY CROSSWALK WITH DIAGONAL LINES**
10+017.7 LT. - 10+017.7 RT.
20+005.2 RT. - 20+023.5 LT.

- TEMPORARY LETTERS OR SYMBOLS**
- 9+985.2 LT. ~~PLAZA~~
- 10+003.7 LT. ~~PLAZA~~
- 9+985.0 RT. ~~ONLY~~
- 9+988.6 LT. ~~ONLY~~
- 10+007.1 LT. ~~ONLY~~
- 9+991.5 LT. ~~ONLY~~
- 10+010.1 RT. ~~ONLY~~
- 9+988.3 RT. ~~ONLY~~
- 20+036.1 CL. ~~STOP~~

- ERECTING SALVAGED SIGNS**
20+036.7 RT. (4 EA.)


- SETTING SALVAGED POSTS**
20+036.7 RT. (1 EA.)

- ~~PORTLAND CEMENT CONCRETE~~
~~SIDEWALK - 125mm~~
10+015.11 RT. - 10+020.63 RT.


- SIDEWALK RAMP, TYPE 6**
10+015.11 RT. - 10+020.63 RT.
MADE WITH HOT MIX (TEMP.)

NOTE:
CONTRACTOR SHALL INSTALL
SIDEWALK DETOUR SIGNS SHOWN ON
CONSTRUCTION SIGN DETAIL (2) AS
NEEDED TO REDIRECT PEDESTRIAN
TRAFFIC AROUND BRIDGE PROJECT.

- TRAFFIC SIGNS, TYPE A**
- 9+984.8 RT. (1 EA.)
- 10+015.8 RT. (2 EA.)
- 10+019.0 LT. (2 EA.)
- 10+096.5 RT. (1 EA.)
- 10+101.7 RT. (1 EA.)
- 20+006.3 LT. (2 EA.)
- 20+007.6 LT. (2 EA.)
- 20+035.0 LT. (2 EA.)

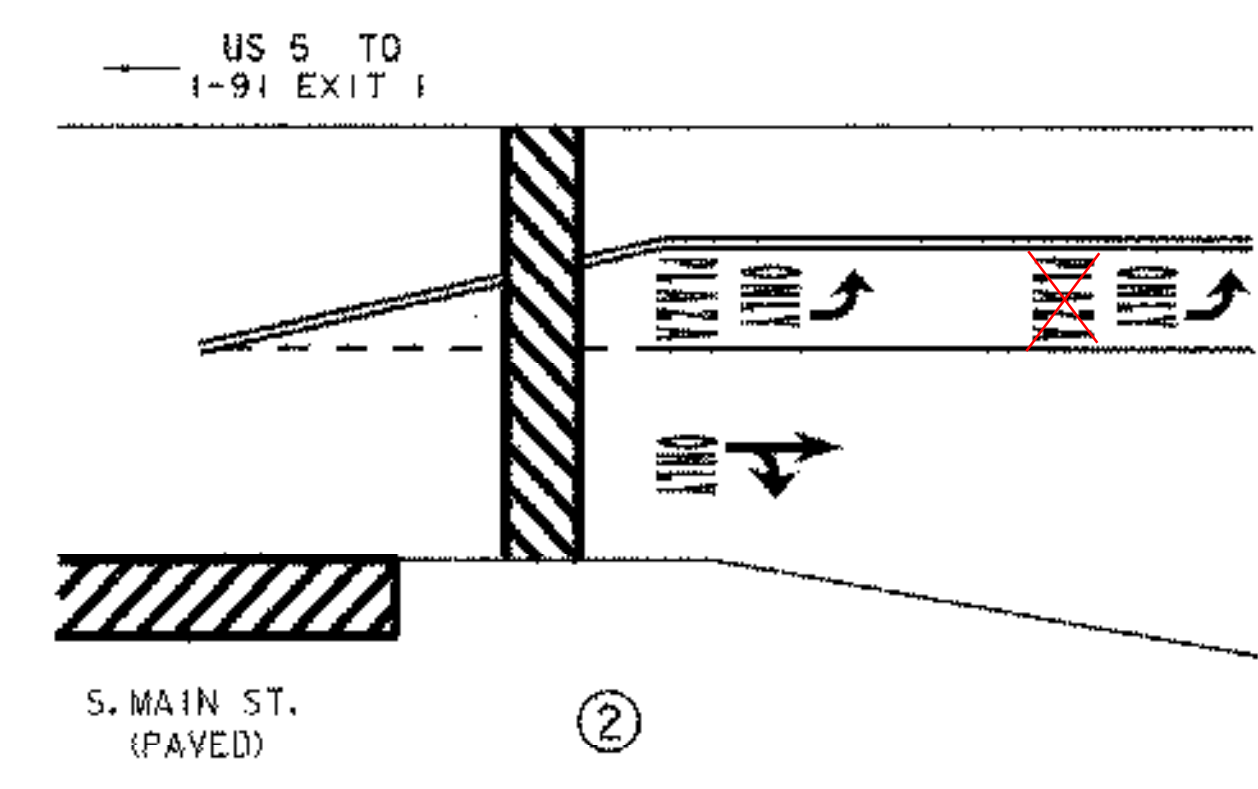

- LEGEND**
- ⊗ REFLECTORIZED PLASTIC DRUMS (SEE STD. E-106M)
- TYPE III BARRICADES (SEE STD. E-107AM)
- ⊠ TYPE III BARRICADES (MOD.) (SEE STD. E-107AM)
- TEMPORARY TRAFFIC BARRIER (SEE STD. G-18M)
- ENERGY ABSORPTION ATTENUATOR FOR 55km/h DESIGN SPEED
- SNOW FENCE
- S SALVAGE
- N NEW

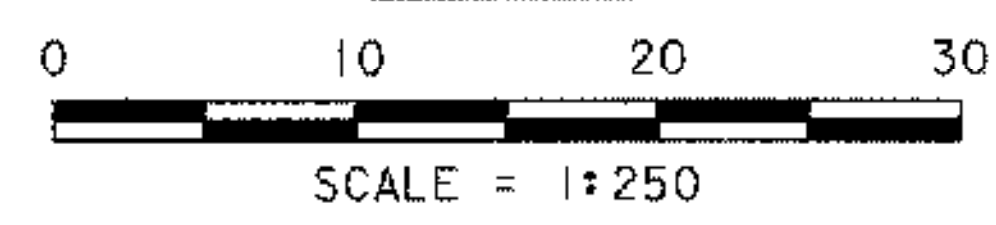

DATE	BY	REVISION
04/22/2003	VAOT	MODIFIED SIGNS FOR DETOUR DUE TO BRIDGE CLOSURE.
03/10/2003	VAOT	INFORMATION ADDED.

PROJECT NAME:	BRATTLEBORO	PLOT DATE:	24-MAY-2004
PROJECT NUMBER:	BHF 2000 (17)	DRAWN BY:	G. ROY
FILE NAME:	94J078\Structures\sj078p.cpl	CHECKED BY:	T. SUMNER
PROJECT MANAGER:	R. R. WHITCOMB	SHEET	13 OF 71
DESIGNED BY:	G. ROY		